
FARRIS, HANSEN & ASSOC. INC.
ENGINEERING, SURVEYING AND LAND PLANNING
715 W. WALWORTH ST. - P.O. BOX 487 - ELKHORN, WI 53121
OFFICE: 414/723-2098

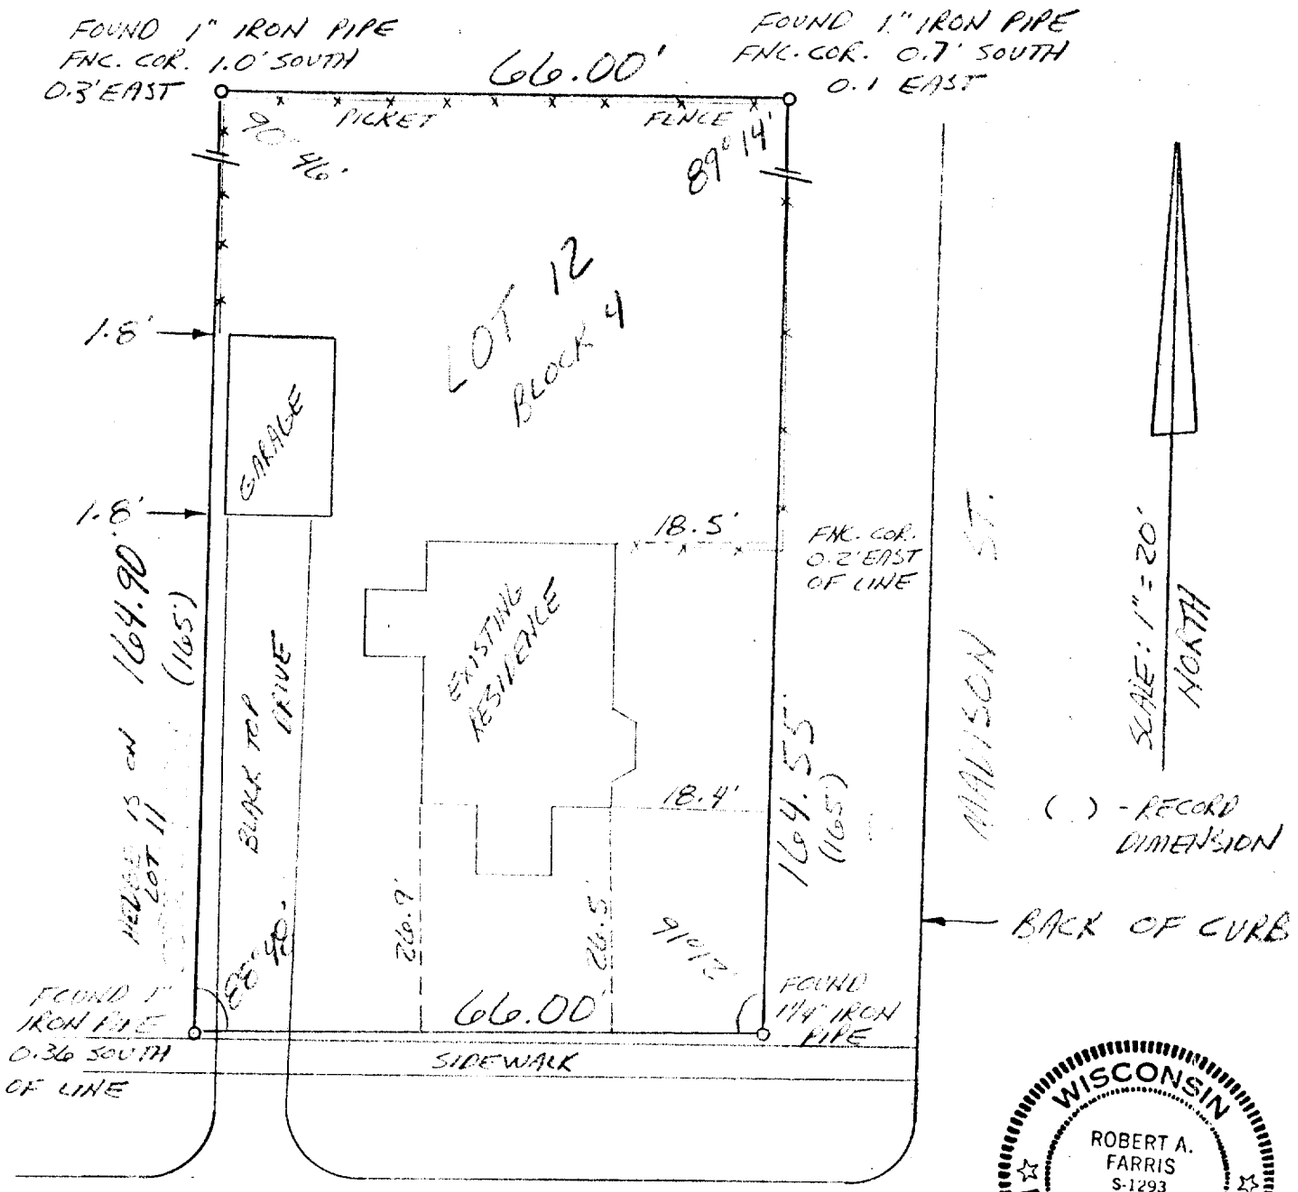

WISCONSIN
ROBERT A. FARRIS
S-1293
ELKHORN, WIS.
LAND SURVEYOR

PLAT OF SURVEY

LOT 12, BLK 4, WHEELERS ADDITION TO THE CITY OF LAKE GENEVA, WALWORTH CO. WISC.

I HEREBY CERTIFY THAT AT THE DIRECTION OF TAGGART REALTY I HAVE SURVEYED THE PROPERTY DESCRIBED HEREON AND THAT THIS PLAT IS A CORRECT REPRESENTATION THEREOF.

ROBERT A. FARRIS DEC. 28, 1982 **DRAWING NUMBER** 2036

ROBERT A. FARRIS S-1293 SURVEYOR

ZWH-24

7-727-F