
PLAT OF SURVEY OF LOT 17, BLOCK 1 OF McKENNA ADDITION TO THE CITY OF LAKE GENEVA, SEC. 25, T.2N., R. 17 E., WALWORTH COUNTY, WISCONSIN

Farris, Hansen & Associates, Inc.
Engineering, Surveying & Land Planning
P.O. BOX 487
715 W. WALWORTH STREET
ELKHORN, WISCONSIN 53121

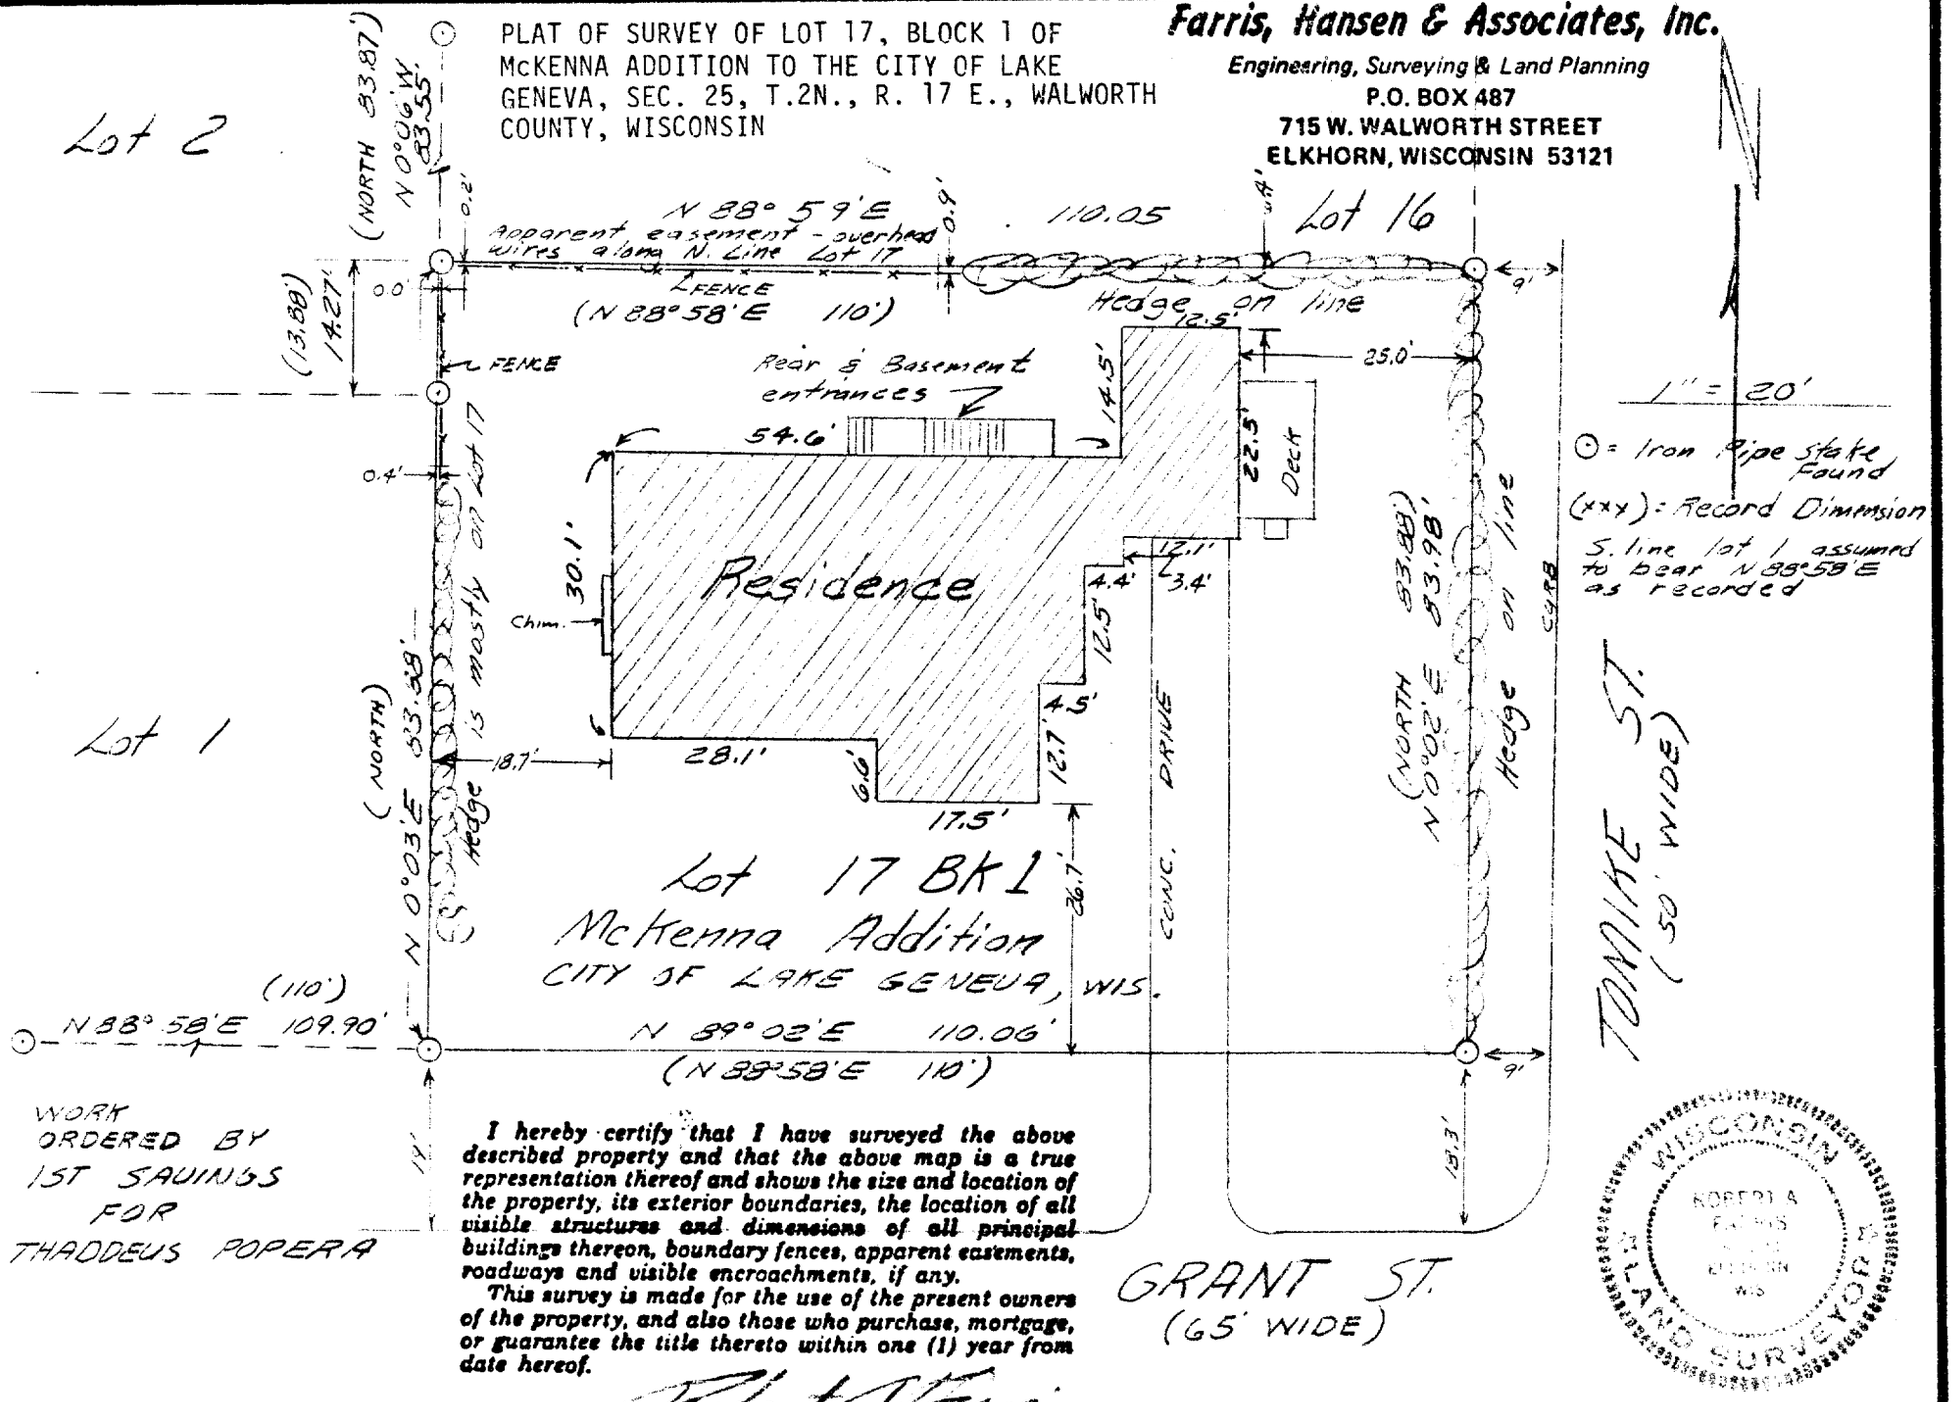

WORK ORDERED BY 1ST SAVINGS FOR THADDEUS POPERA

I hereby certify that I have surveyed the above described property and that the above map is a true representation thereof and shows the size and location of the property, its exterior boundaries, the location of all visible structures and dimensions of all principal buildings thereon, boundary fences, apparent easements, roadways and visible encroachments, if any.

This survey is made for the use of the present owners of the property, and also those who purchase, mortgage, or guarantee the title thereto within one (1) year from date hereof.

Robert J. Farris

DATED OCT. 14, 1983

WISCONSIN ROBERT J. FARRIS S-1328 WISCONSIN REGISTERED LAND SURVEYOR

DRAWING NUMBER 2175

2MC-17

7-1328-F