
KOLB LAND CONSULTING, INC.

LAND SURVEYING · SUBDIVIDING · LAND PLANNING

LAKE GENEVA, WISCONSIN 53147 WHITEWATER, WISCONSIN 53190

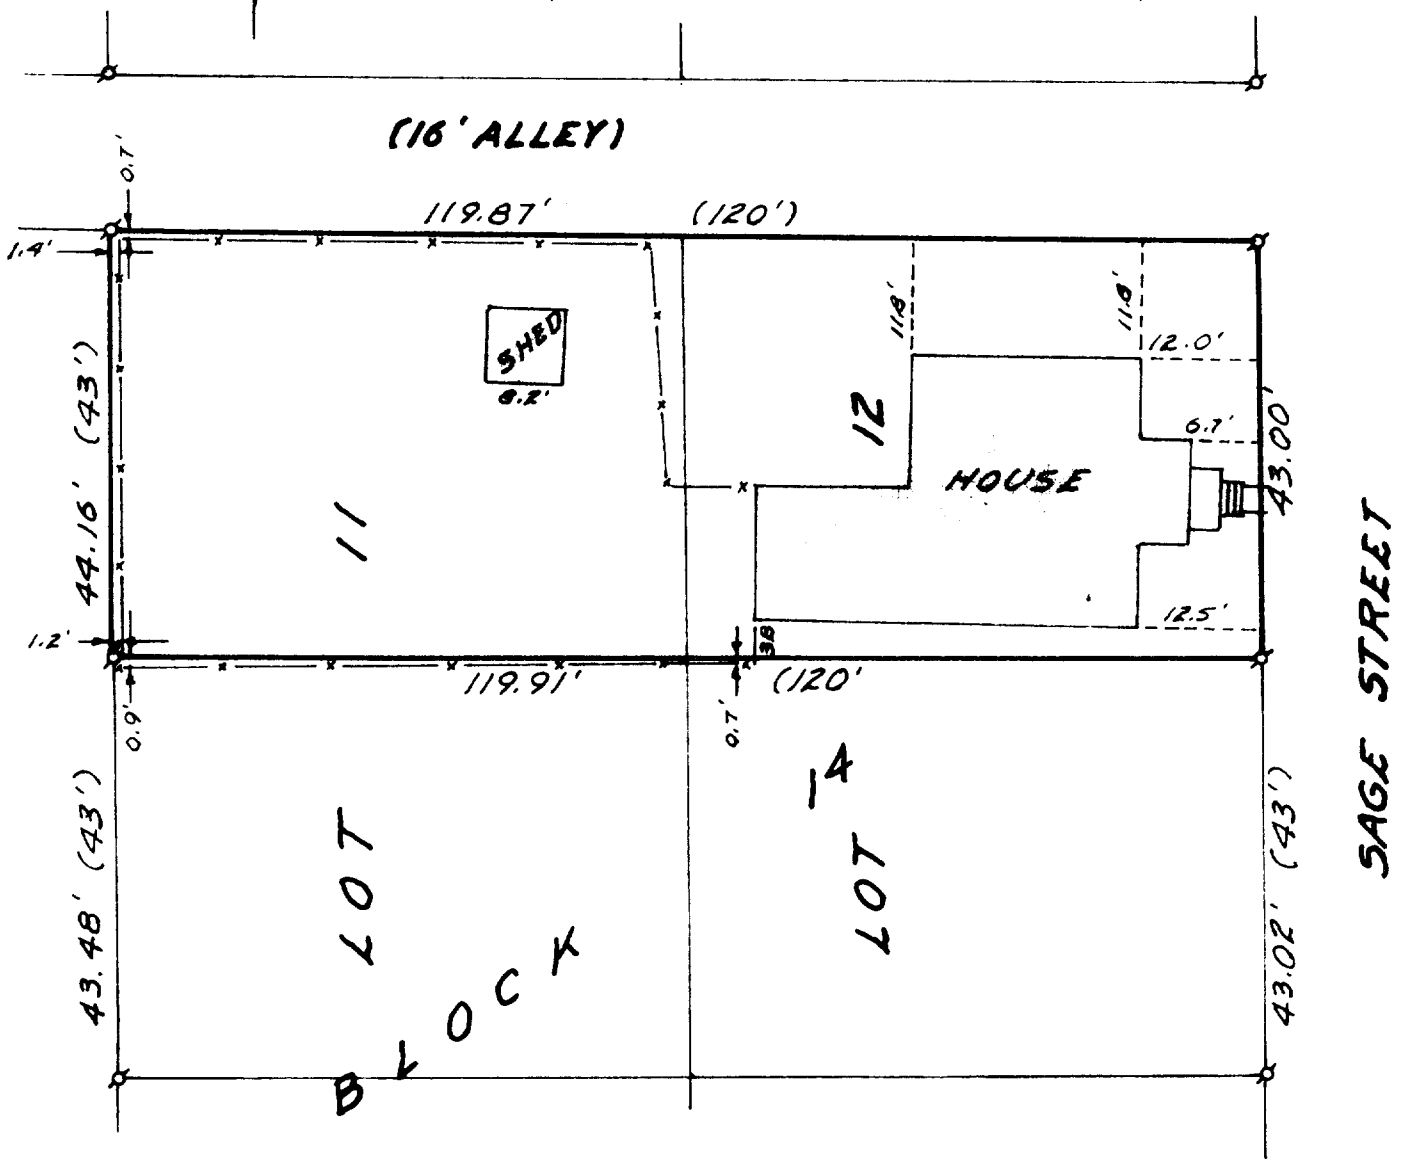

PLAT OF SURVEY OF

A PARCEL OF LAND DESCRIBED AS THE NORTH 43 FEET OF LOTS 11 AND 12, BLOCK 14, ORIGINAL PLAT OF THE VILLAGE, NOW CITY OF LAKE GENEVA, WALWORTH COUNTY, WIS.

ORDERED BY: JOHN NELSON
420 SAGE STREET
LAKE GENEVA, WI. 53147

N

SCALE: 1"=20'

LEGEND
ø IRON PIPE FOUND
—x— FENCE
( ) AS RECORDED

I, HAROLD H. KOLB, DO HEREBY CERTIFY THAT I HAVE SURVEYED THE PROPERTY HEREON DESCRIBED ACCORDING TO THE OFFICIAL RECORDS, AND THAT THE PLAT HEREON IS A CORRECT REPRESENTATION OF THE LOT LINES AND THE PRINCIPLE LINES OF THE IMPROVEMENTS THEREON, TO THE BEST OF MY KNOWLEDGE AND BELIEF.

Harold H. Kolb

WISCONSIN REGISTERED LAND SURVEYOR, S-

DATE MAY 27, 1982

OP-132

7-732-K