KOLB LAND CONSULTING, INC.

LAND SURVEYING · SUBDIVIDING · LAND PLANNING

LAKE GENEVA, WISCONSIN 53147

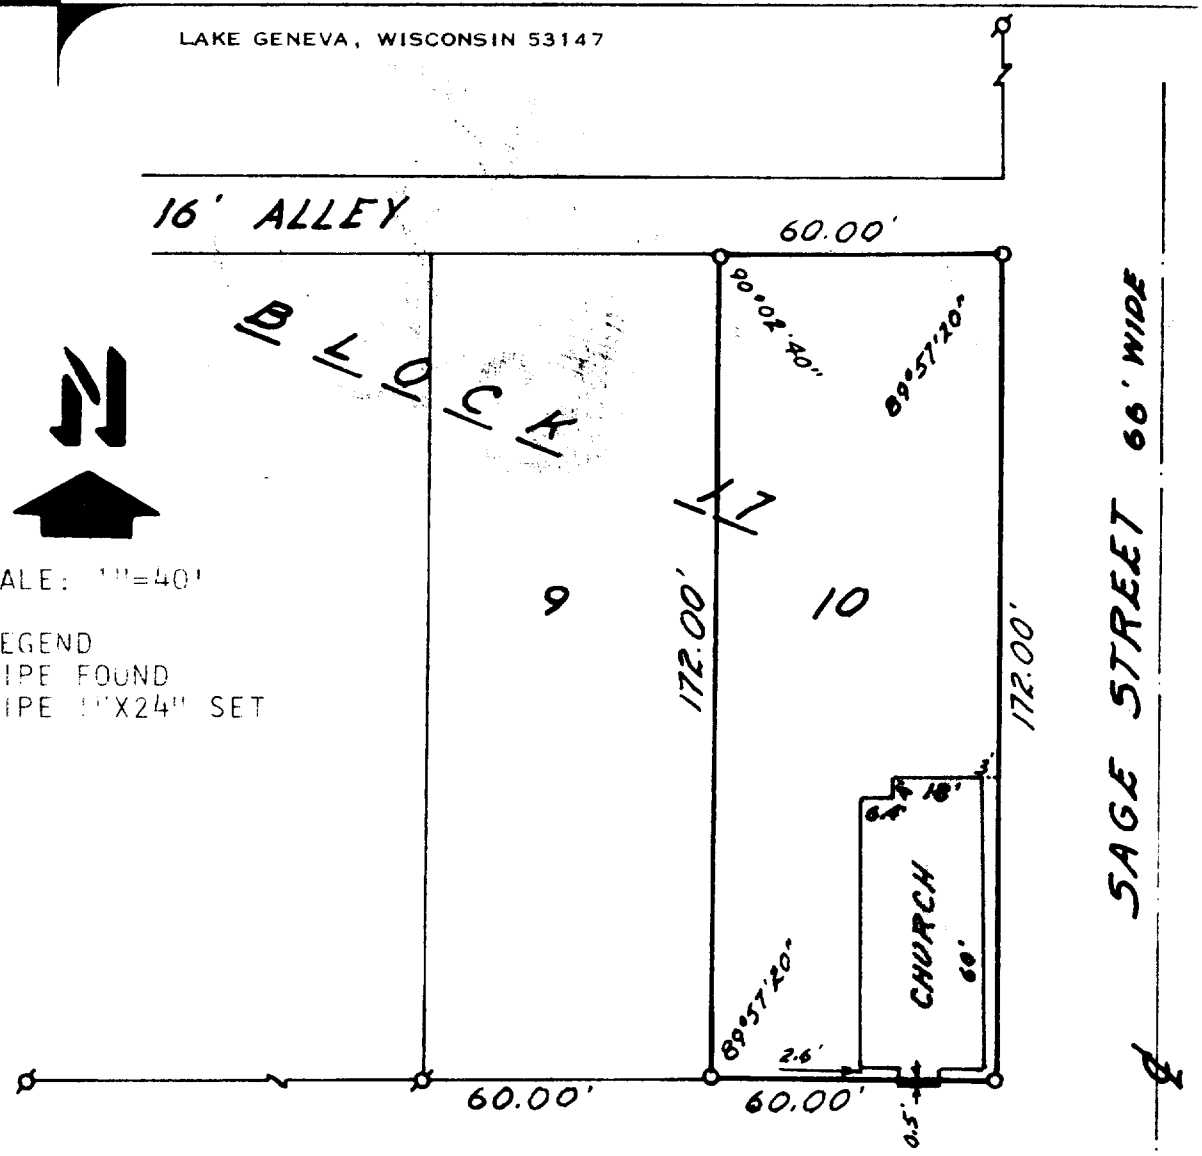

PLAT OF SURVEY OF

LOT 10, BLOCK K, GENEVA LAKE CRAWFORD MANUFACTURING COMPANY ADDITION TO THE CITY OF LAKE GENEVA, LOCATED IN THE SOUTHEAST 1/4 OF SECTION 25, T 2 N, R 17 E, CITY OF LAKE GENEVA, WALWORTH COUNTY, WISCONSIN.

ORDERED BY: STANLEY E. ENGSTROM
FOR: LAKE GENEVA BIBLE CHAPEL
601 WALWORTH STREET
LAKE GENEVA, WI. 53147

WISCONSIN HAROLD H. KOLB S-187 REGISTERED LAND SURVEYOR

I, HAROLD H. KOLB DO HEREBY CERTIFY THAT I HAVE SURVEYED THE PROPERTY HEREON DESCRIBED ACCORDING TO THE OFFICIAL RECORDS, AND THAT THE PLAT HEREON IS A CORRECT REPRESENTATION OF THE LOT LINES AND THE PRINCIPAL LINES OF THE BUILDINGS THEREON TO THE BEST OF MY KNOWLEDGE AND BELIEF.

Harold H. Kolb

WISCONSIN REGISTERED LAND SURVEYOR, S-187

DATE FEBRUARY 14, 1983

ZGC-89

7-738-K