
48-4

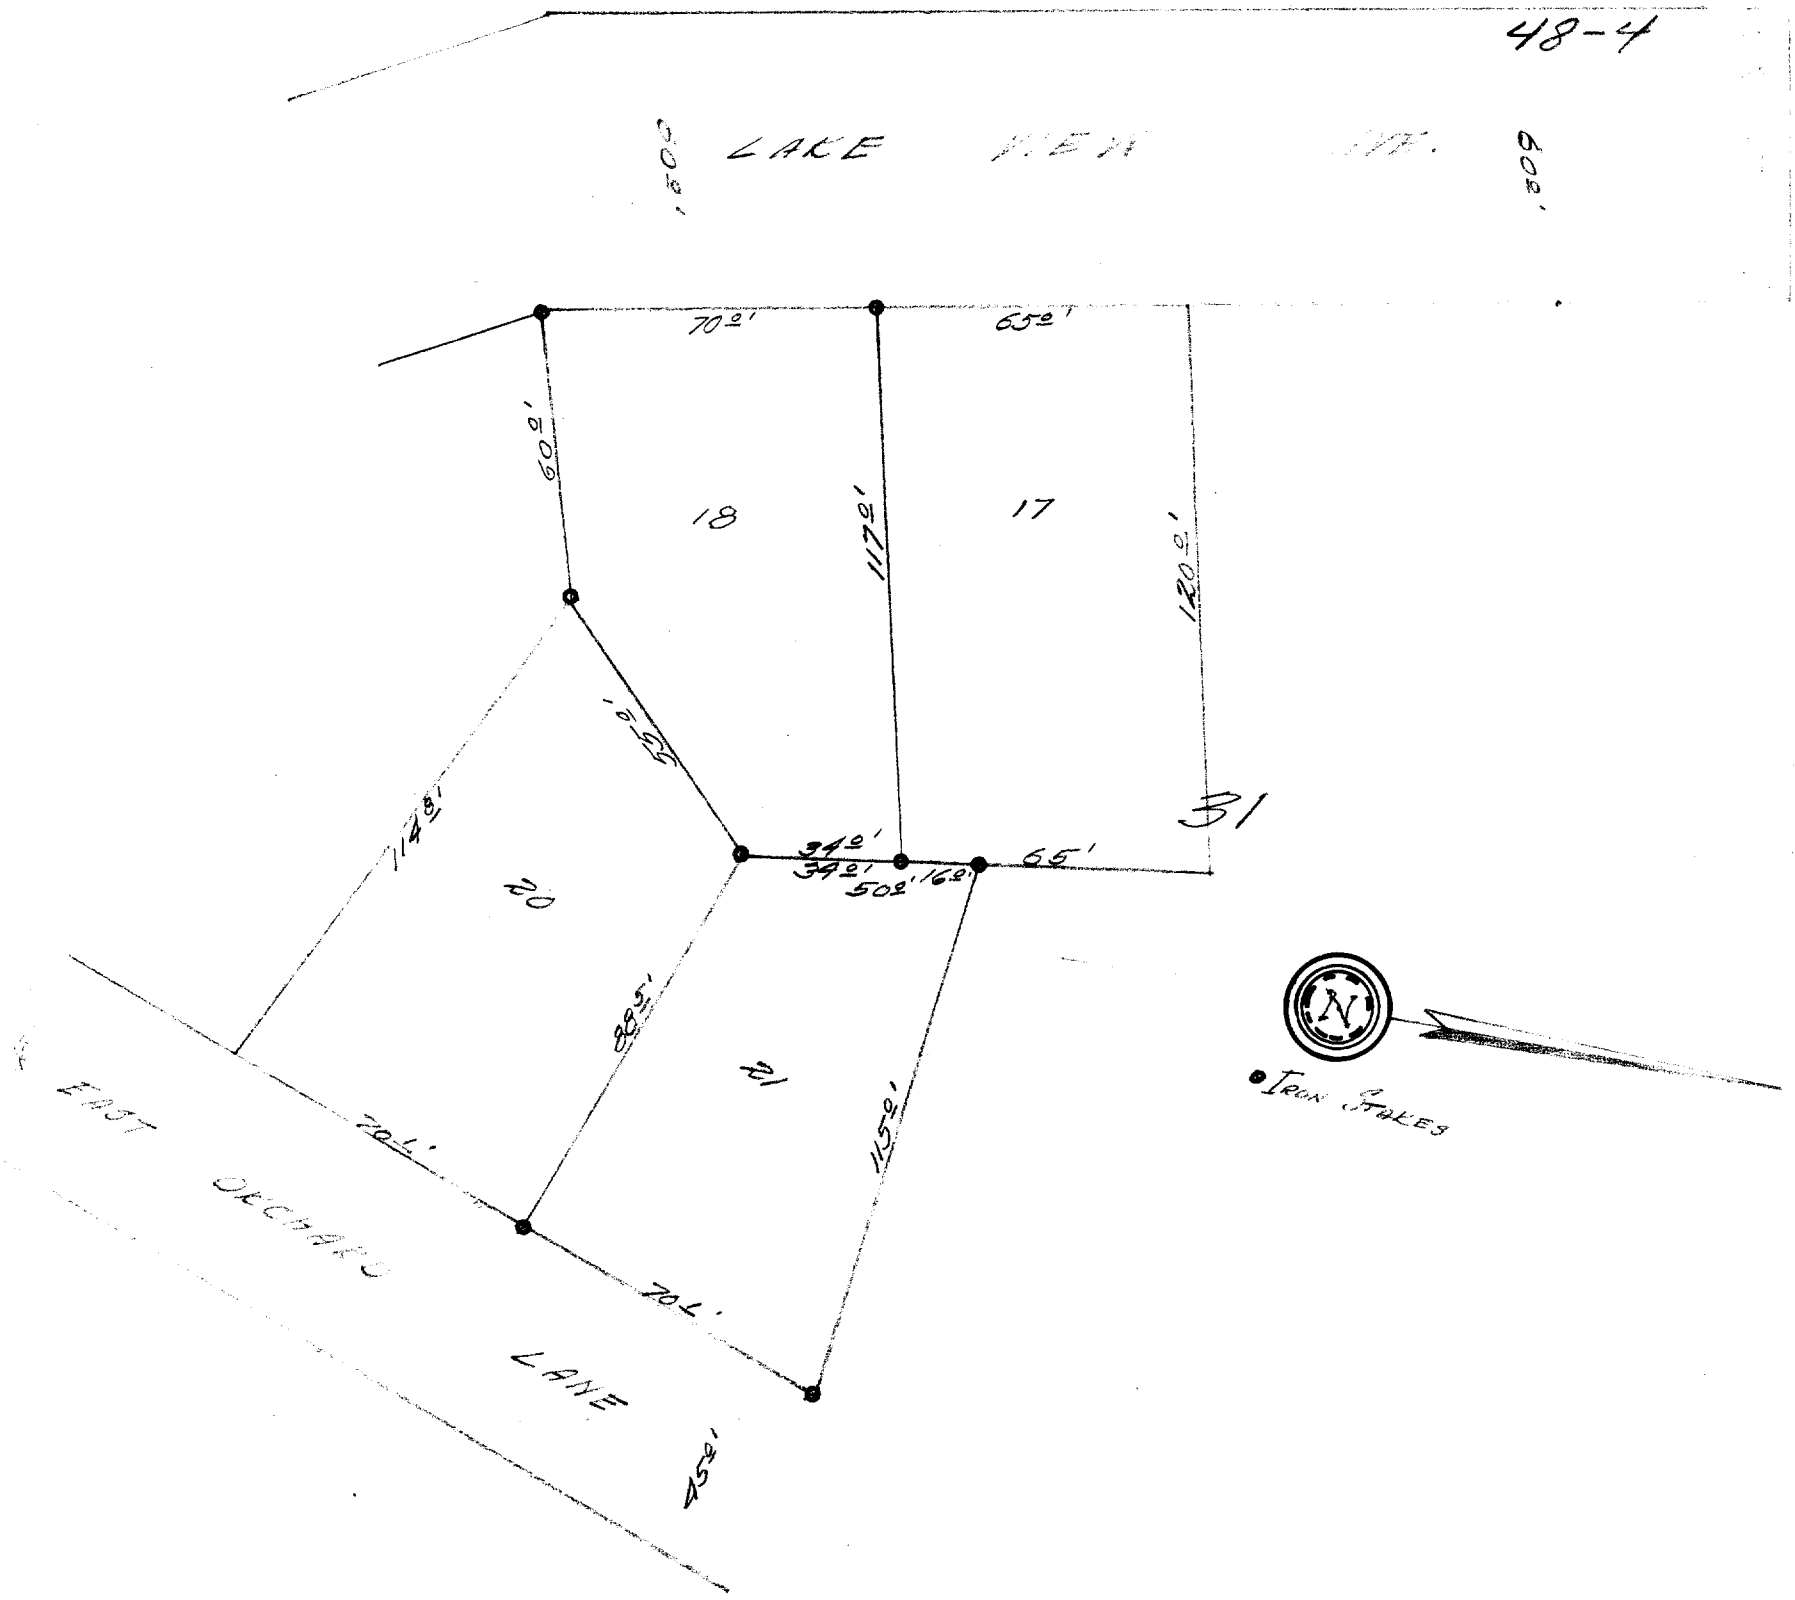

DESCRIPTION:

Lots 18 and 21, Block 31; Lake Geneva Manor a subdivision of a portion of the City of Lake Geneva, Walworth County, Wisconsin.

CERTIFICATE:

I, hereby certify that I have on this the 26th day of November, 1948, surveyed the above described property according to the official records on file in the office of the Recorder of Deeds in and for Walworth County, Wisconsin, and find that the measurements and bearings of the boundary lines of the property as taken at the site on this day substantially agree with those in said official records and that no encroachments exist.

SIGNED AND SEALED THIS 29TH DAY OF NOVEMBER 1948.

Joseph M. Biagi.
Professional Engineer.
Elkhorn Wisconsin.

1-13B

7-73B