
KOLB LAND CONSULTING, INC.

LAND SURVEYING · SUBDIVIDING · LAND PLANNING

LAKE GENEVA, WISCONSIN 53147

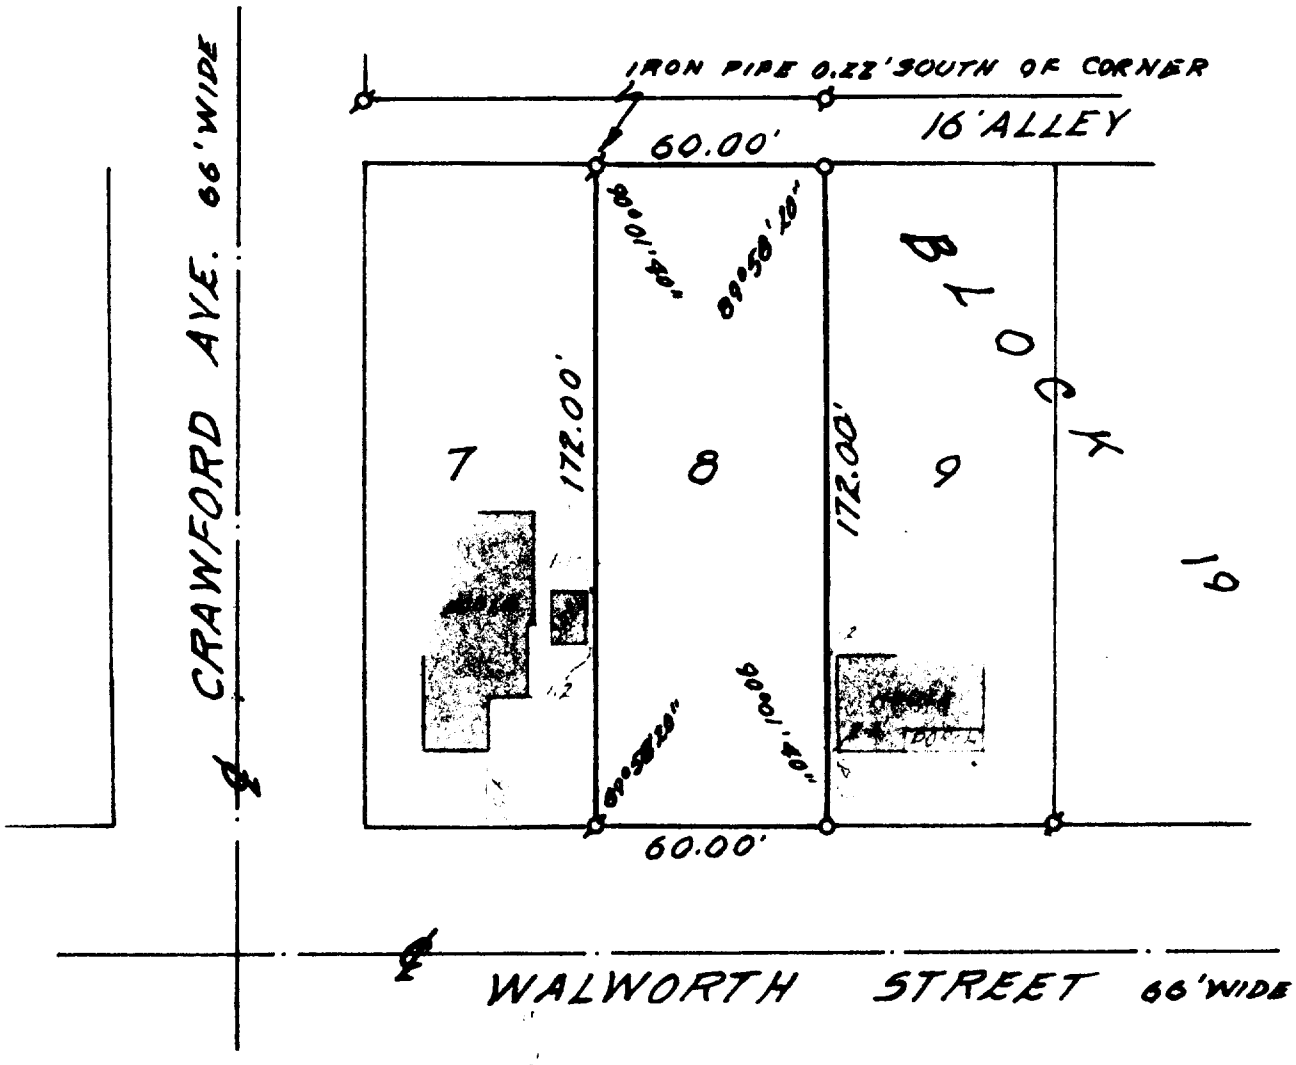

SCALE - 1"=50'

LEGEND
ø - IRON PIPE FOUND
o - IRON PIPE SET
1-5/8"X24"

PLAT OF SURVEY OF

LOT 8, BLOCK 19, GENEVA LAKE CRAWFORD MANUFACTURING COMPANY ADDITION, CITY OF LAKE GENEVA, WALWORTH COUNTY, WISCONSIN.

ORDERED BY: HOWARD BASSO, JR.
ROUTE 4 2608 ECHO LANE
BURLINGTON, WI 53105

I, HAROLD H. KOLB, DO HEREBY CERTIFY THAT I HAVE SURVEYED THE PROPERTY HEREON DESCRIBED ACCORDING TO THE OFFICIAL RECORDS, AND THAT THE PLAT HEREON IS A CORRECT REPRESENTATION OF THE LOT LINES TO THE BEST OF MY KNOWLEDGE AND BELIEF.

Harold H. Kolb

HAROLD H. KOLB
WISCONSIN REGISTERED LAND SURVEYOR, S-187

DATE SEPTEMBER 7, 1983

ZGC-00107

7-748-K