KOLB LAND CONSULTING, INC.

LAND SURVEYING · SUBDIVIDING · LAND PLANNING

LAKE GENEVA, WISCONSIN 53147

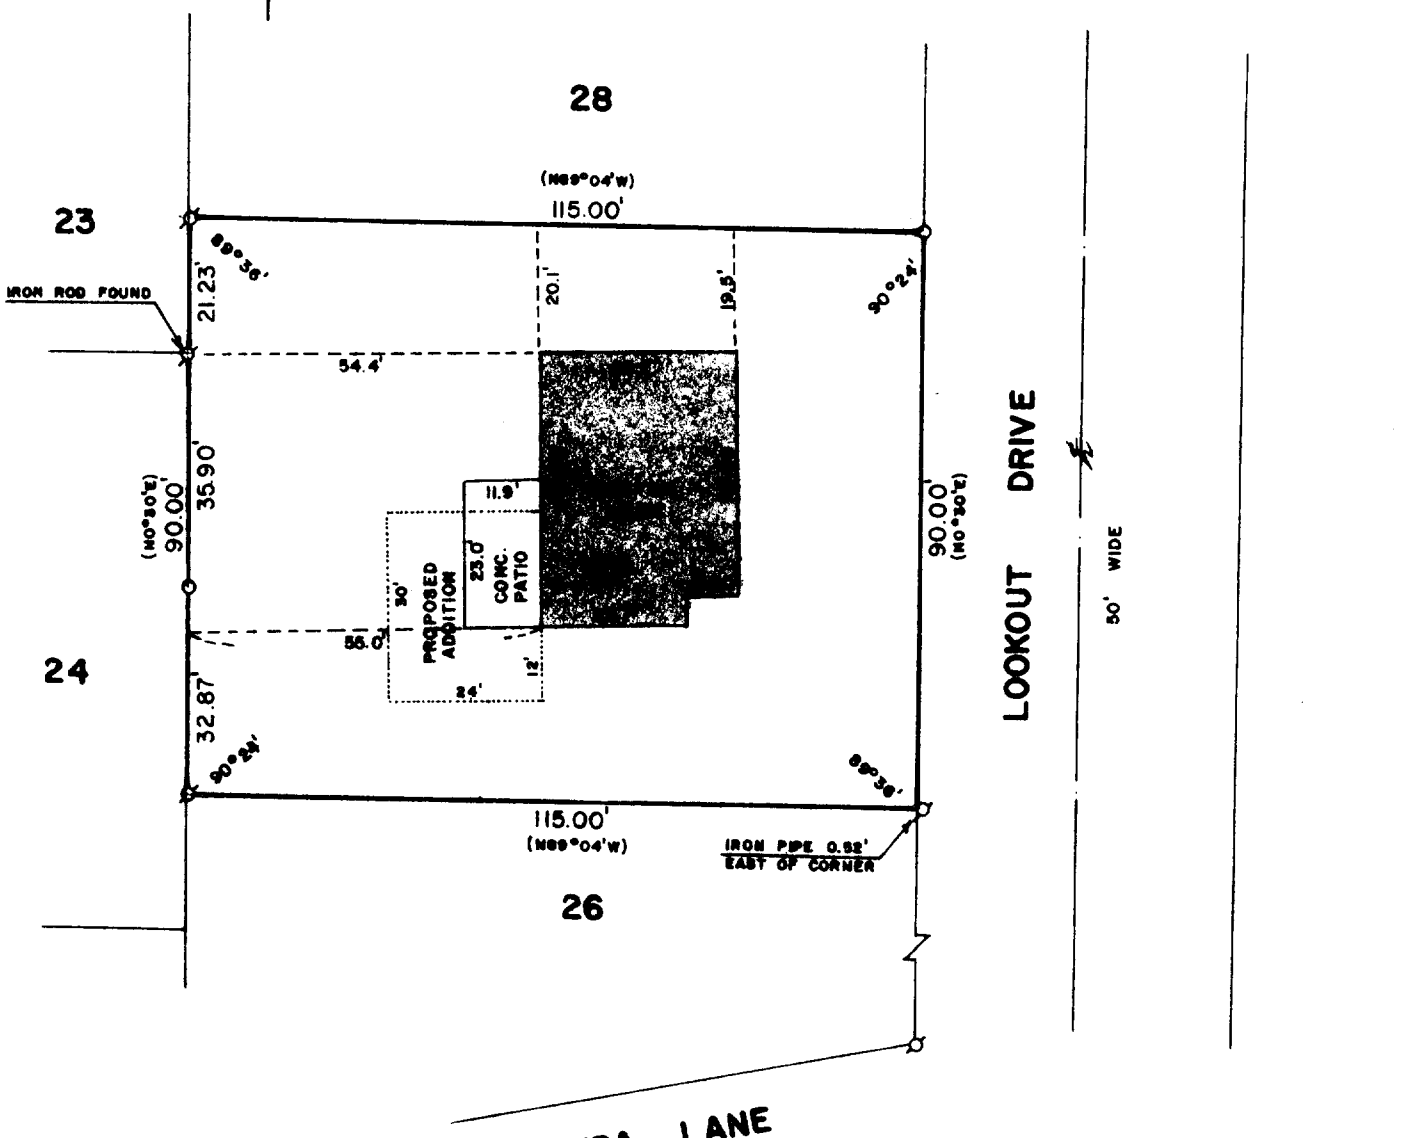

PLAT OF SURVEY OF

LOT 27, STURWOOD ADDITION, A SUBDIVISION LOCATED IN THE NE 1/4 OF SECTION 35, T 2 N, R 17 E, CITY OF LAKE GENEVA, WALWORTH COUNTY, WISCONSIN.

ORDERED BY: BOB SKIBITZKI
208 LOOKOUT DRIVE
LAKE GENEVA, WI 53147

SCALE: 1"=30'

LEGEND
- ø IRON PIPE FOUND
- o 1"X24" IRON PIPE SET

WISCONSIN HAROLD H. KOLB S-187 LAKE GENEVA, WIS LAND SURVEYOR

I, HAROLD H. KOLB, DO HEREBY CERTIFY THAT I HAVE SURVEYED THE PROPERTY HEREON DESCRIBED ACCORDING TO THE OFFICIAL RECORDS, AND THAT THE PLAT HEREON IS A CORRECT REPRESENTATION OF THE LOT LINES AND THE PRINCIPAL LINES OF THE BUILDINGS THEREON TO THE BEST OF MY KNOWLEDGE AND BELIEF.

Harold H. Kolb

WISCONSIN REGISTERED LAND SURVEYOR, S- 187

DATE SEPT. 27, 1983

ZST-- 00026

7-749K