
PLAT OF SURVEY

PARCELS OF LAND LOCATED IN THE NORTHEAST 1/4 OF SECTION 26, T.2N., R17E, CITY OF LAKE GENEVA, WALWORTH COUNTY, WISCONSIN.

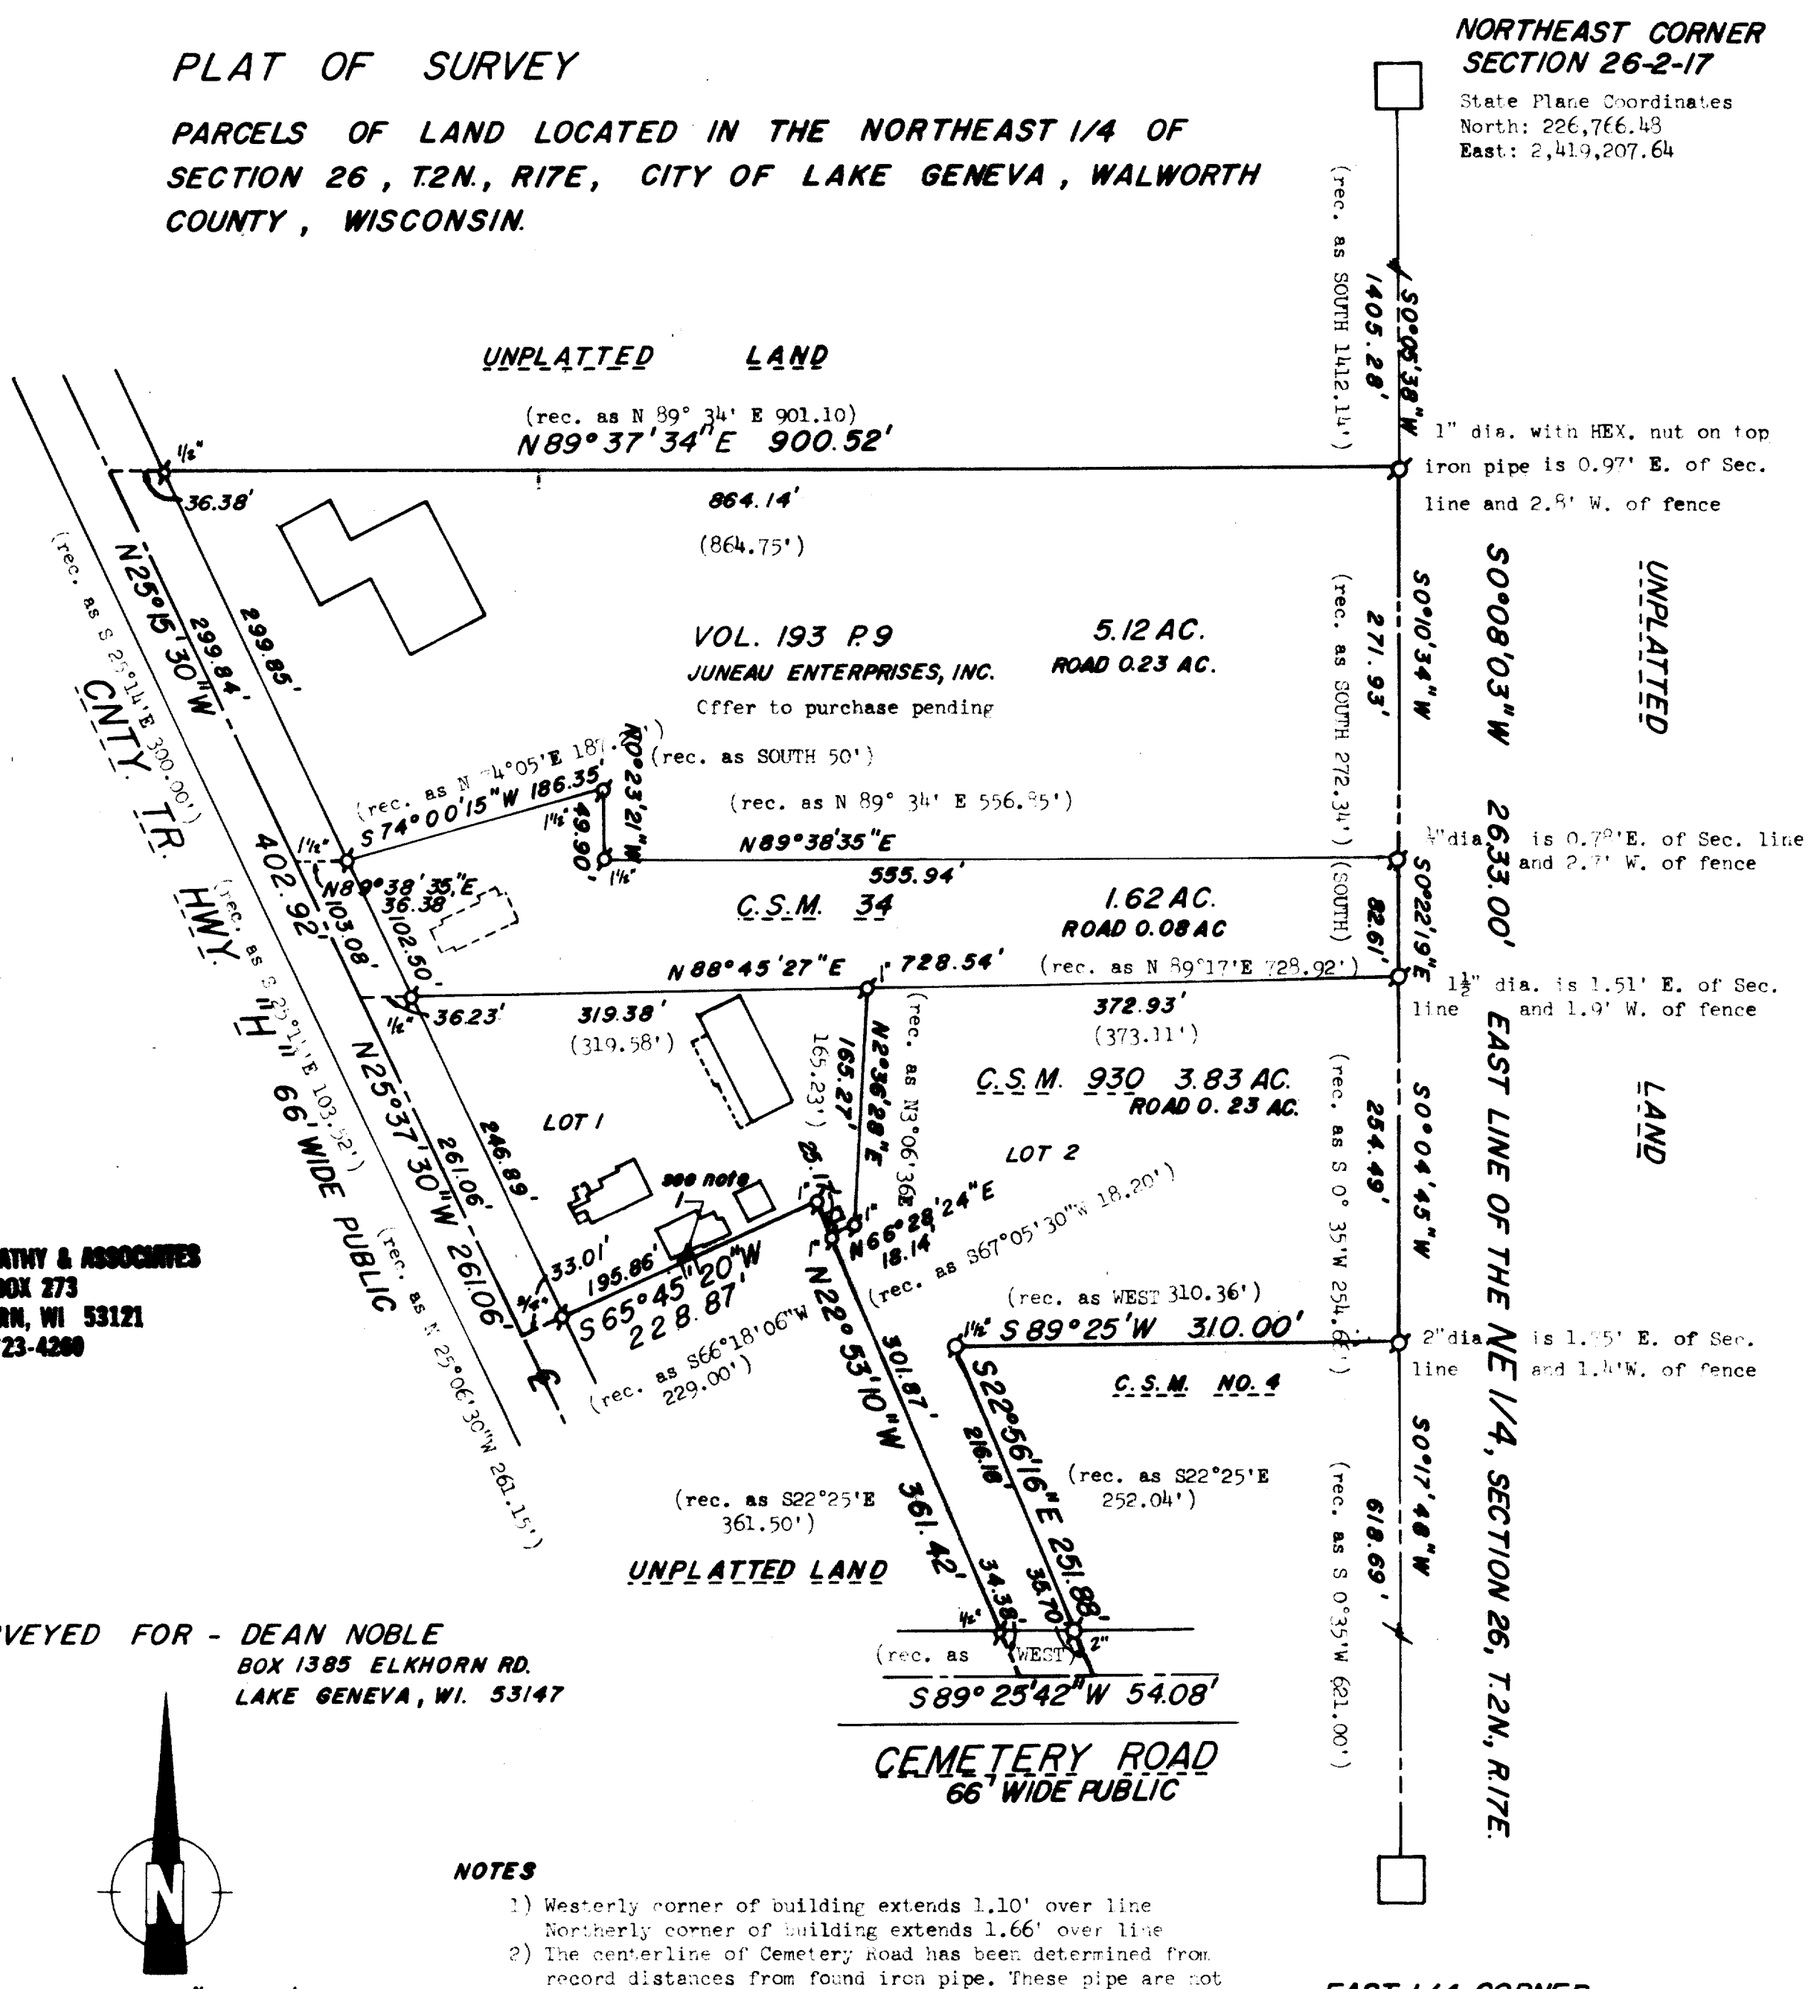

ABERNATHY & ASSOCIATES
RT. 3 BOX 273
ELKHORN, WI 53121
(414) 723-4280

SURVEYED FOR - DEAN NOBLE
BOX 1385 ELKHORN RD.
LAKE GENEVA, WI. 53147

SCALE 1"= 100'

NOTES

1) Westerly corner of building extends 1.10' over line
   Northerly corner of building extends 1.66' over line
2) The centerline of Cemetery Road has been determined from record distances from found iron pipe. These pipe are not on the North Line of said road.
3) Previous surveys have assumed the East Line of Section 26 to bear both NORTH and S 0°-35'-00"W.

LEGEND

Ø - IRON PIPE FOUND
( ) - RECORD DIMENSION
□ WALWORTH COUNTY SECTION CORNER

BEARINGS ARE BASED ON WISCONSIN STATE PLANE COORDINATE SYSTEM, SOUTH ZONE

SURVEYOR'S CERTIFICATE:

I, Kenneth B. Abernathy Jr., do hereby certify that I have surveyed the above described property and that this plat of survey is a true and accurate representation of the boundary lines and buildings thereon to the best of my professional knowledge and belief.

Kenneth B. Abernathy Jr.
Wis. Reg. Surveyor No. S-1594

WISCONSIN KENNETH B. ABERNATHY, JR. S-1594 ELKHORN, WI LAND SURVEYOR

MAY 2, 1985

4up-40B
#930

NO. 1985.201

7-781