
RECEIVED
SEP 30 1985

KOLB LAND CONSULTING, INC.

LAND SURVEYING · SUBDIVIDING · LAND PLANNING

929 WILLIAMS STREET LAKE GENEVA, WISCONSIN 53147 414-248-3697



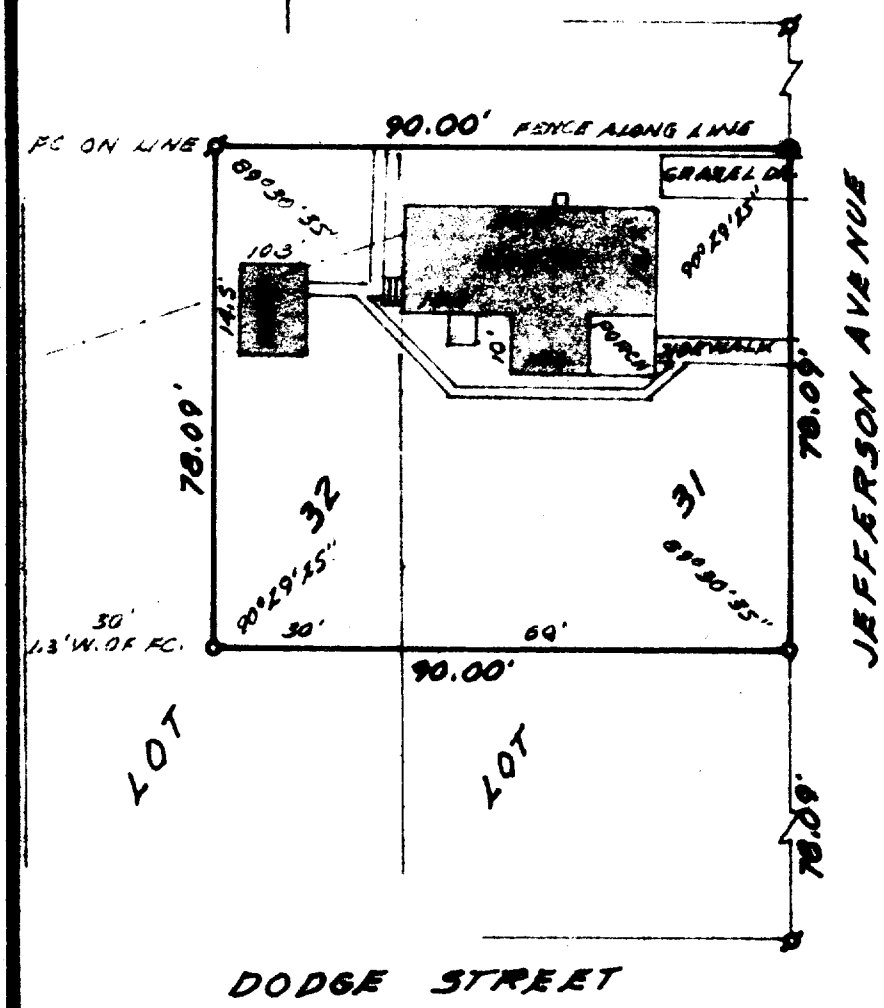


SCALE: 1" =30'

LEGEND
- IRON PIPE FOUND
- 1" X24" IRON PIPE SET
- CROSS IN CONC. FOUND
- OVERHEAD UTILITY LINES

ORDERED BY:
LEROY M. OLSON, OWNER
1740 HILLCREST DRIVE
LAKE GENEVA, WI. 53147

PLAT OF SURVEY OF
THE NORTH 1/2 OF LOT 31 AND THE EAST 1/2 OF THE NORTH 1/2 OF LOT 32, DAVID O. MARSH ADDITION TO THE CITY OF LAKE GENEVA, WALWORTH COUNTY, WISCONSIN.
TAX PARCEL: ZCMA-33

I, HEREBY CERTIFY THAT I HAVE SURVEYED THE ABOVE DESCRIBED PROPERTY AND THAT THE ABOVE MAP IS A TRUE REPRESENTATION THEREOF AND SHOWS THE SIZE AND LOCATION OF THE PROPERTY, ITS EXTERIOR BOUNDARIES, THE LOCATION OF ALL VISIBLE STRUCTURES AND DIMENSIONS OF ALL PRINCIPAL BUILDINGS THEREON, BOUNDARY FENCES, APPARENT EASEMENTS, ROADWAYS AND VISIBLE ENCROACHMENTS, IF ANY, TO THE BEST OF MY KNOWLEDGE AND BELIEF.
THIS SURVEY IS MADE FOR THE USE OF THE PRESENT OWNERS OF THE PROPERTY, AND ALSO THOSE WHO PURCHASE, MORTGAGE, OR GUARANTEE THE TITLE THERETO WITHIN ONE (1) YEAR FROM THE DATE HEREOF.

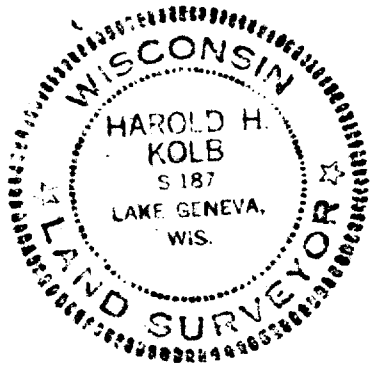

Harold H. Kolb

HAROLD H. KOLB
WISCONSIN REGISTERED LAND SURVEYOR, S-187
DATE MAY 18, 1985
REVISED
REVISED

ZMA-00033

LG-CMA-33 7-784-K