
RECEIVED
SEP 3 0 1985

KOLB LAND CONSULTING, INC.

LAND SURVEYING · SUBDIVIDING · LAND PLANNING

929 WILLIAMS STREET LAKE GENEVA, WISCONSIN 53147 414-248-3697

RECEIVED
SEP 3 0 1985

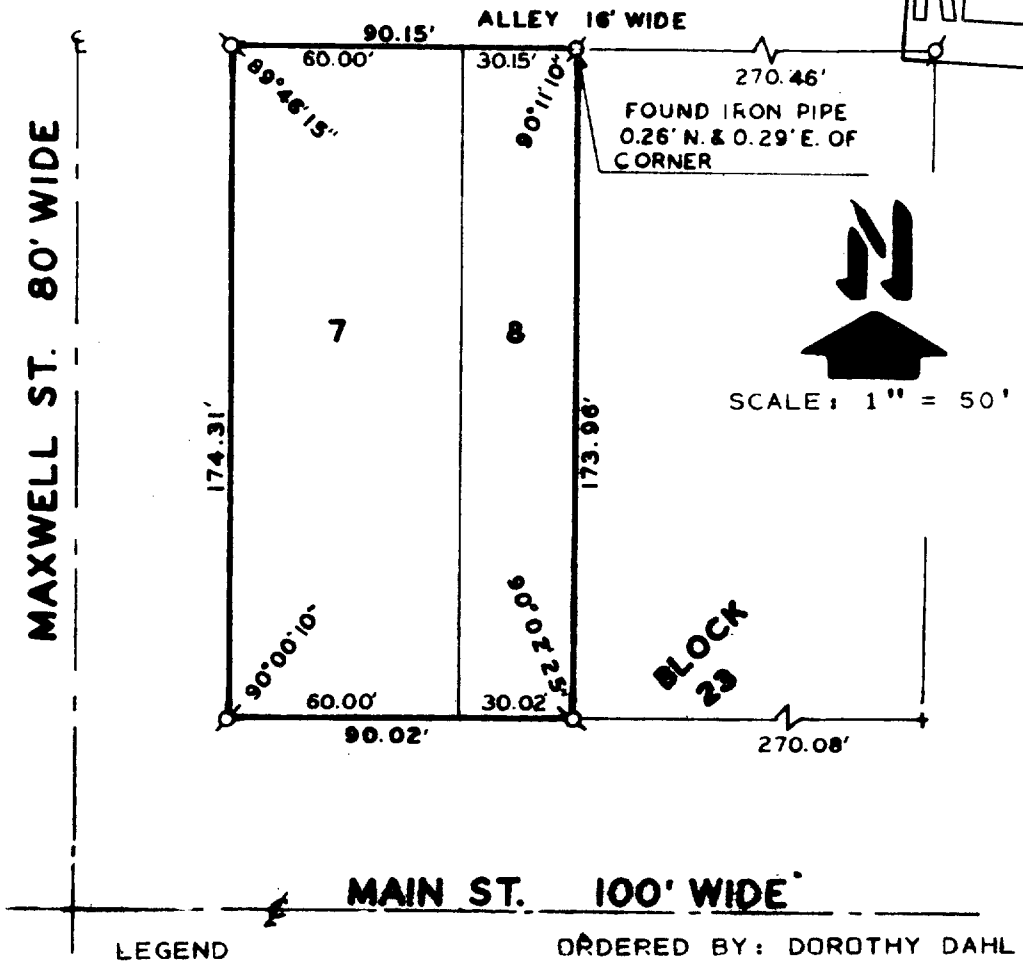

LEGEND

ø - IRON PIPE FOUND
+ - SPIKE FOUND

ORDERED BY: DOROTHY DAHLIN
1131 MAIN ST.
LAKE GENEVA, WI, 53147

PLAT OF SURVEY OF

LOT 7 AND THE WEST 1/2 OF LOT 8, BLOCK 23,
ORIGINAL PLAT OF THE CITY OF LAKE GENEVA,
WALWORTH COUNTY, WISCONSIN.

WISCONSIN
HAROLD H. KOLB
S-187
LAKE GENEVA, WIS
LAND SURVEYOR

I, HAROLD H. KOLB, DO HEREBY CERTIFY THAT I HAVE SURVEYED THE PROPERTY HEREON DESCRIBED ACCORDING TO THE OFFICIAL RECORDS, AND THAT THE PLAT HEREON IS A CORRECT REPRESENTATION OF THE LOT LINES TO THE BEST OF MY KNOWLEDGE AND BELIEF.

Harold H. Kolb
HAROLD H. KOLB

WISCONSIN REGISTERED LAND SURVEYOR, S-187

DATE AUGUST 9, 1985

REVISED _____

REVISED _____

ZOP-00219

LG-ZOP-219 7-787-K