
ABELL
SURVEYING & MAPPING
DELAVAN, WISCONSIN 53115

RECEIVED
JAN 8 1986

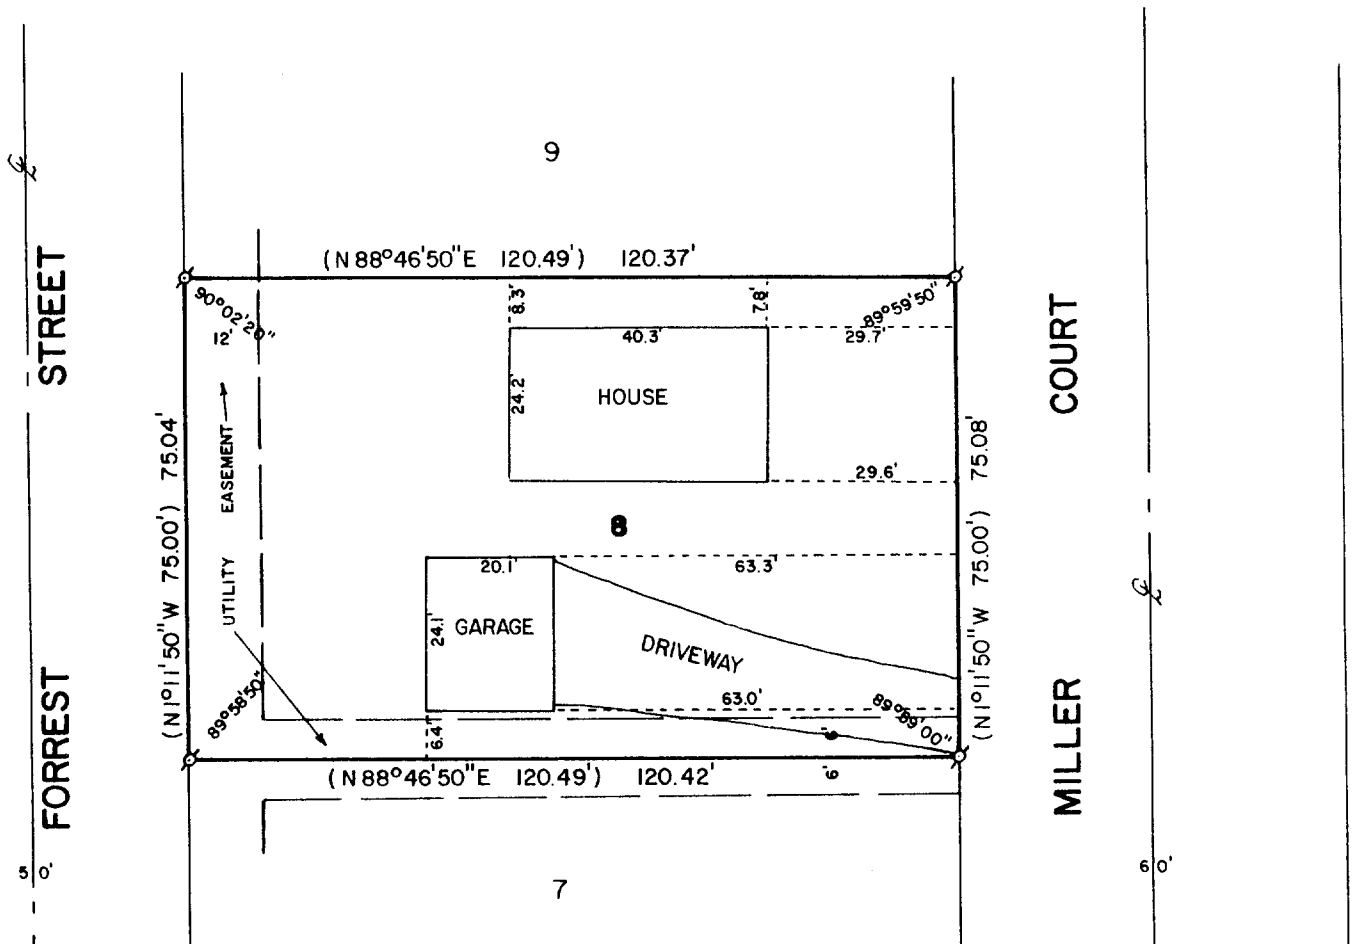

PLAT OF SURVEY OF

LOT 8 OF WESTGATE SUBDIVISION, LOCATED IN THE CITY OF LAKE GENEVA, WALWORTH COUNTY, WISCONSIN.

ORDERED BY: ANCHOR SAVINGS & LOAN
201 BROAD STREET
LAKE GENEVA, WI 53147

SCALE - 1"=30'
LEGEND
ø - IRON PIPE FOUND
( )- RECORDED AS

I, DAVID F. ABELL, DO HEREBY CERTIFY THAT I HAVE SURVEYED THE PROPERTY HEREON DESCRIBED ACCORDING TO THE OFFICIAL RECORDS, AND THAT THE PLAT HEREON IS A CORRECT REPRESENTATION OF THE LOT LINES TO THE BEST OF MY KNOWLEDGE AND BELIEF.

David F. Abell
DAVID F. ABELL
WISCONSIN REGISTERED LAND SURVEYOR, S-1596

DATE January 2, 1986 JOB NUMBER - 1285004

7-790-A