
WALWORTH COUNTY
SURVEYING & MAPPING
LAKE GENEVA, WISCONSIN


RECEIVED
1985

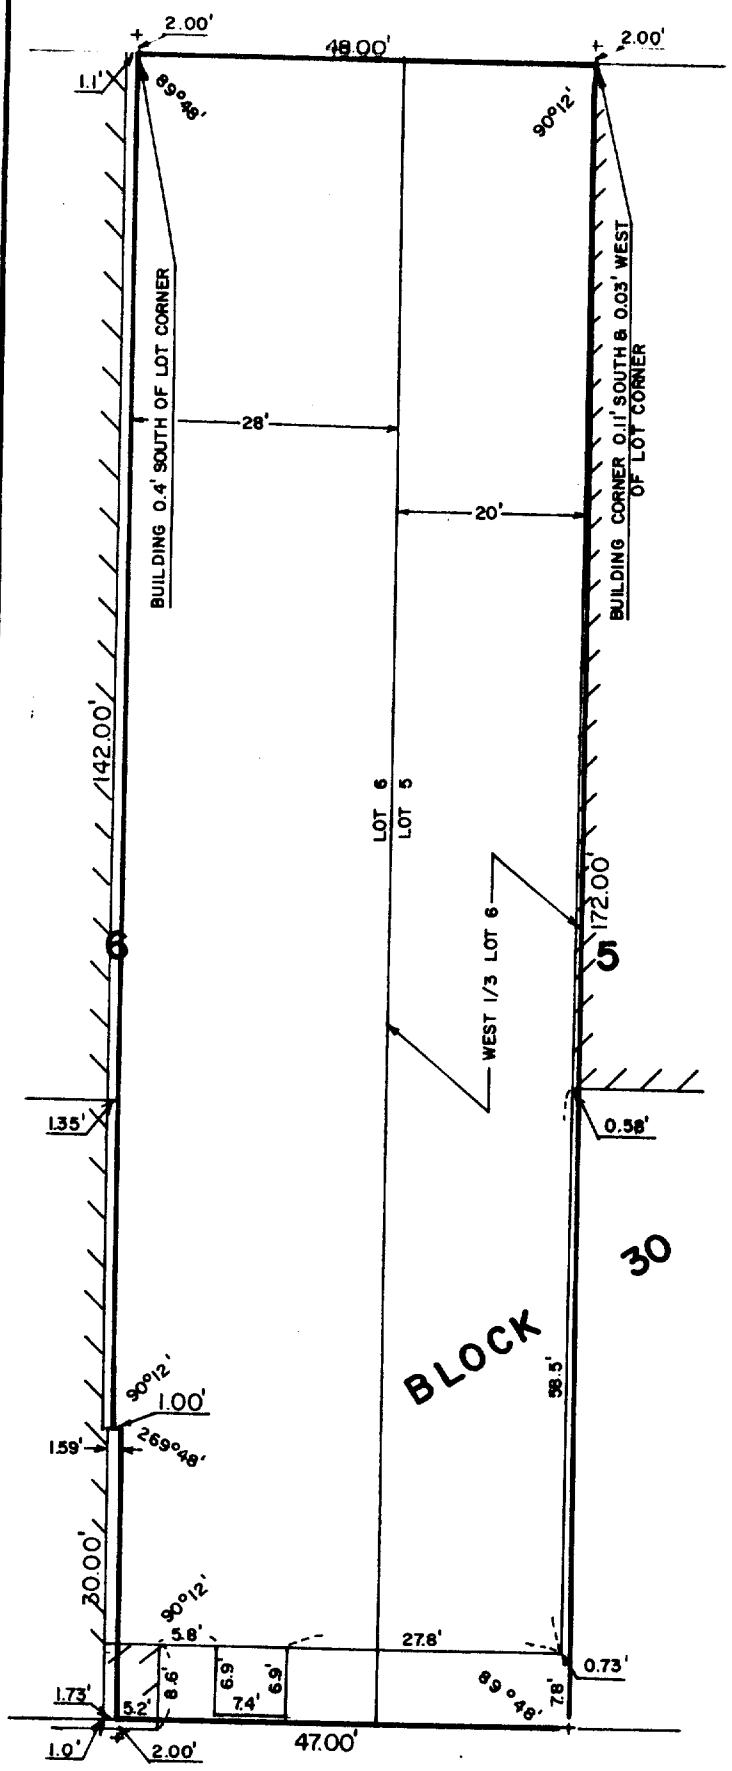


PLAT OF SURVEY OF

THE WEST 1/3 OF LOT 5 AND THE EAST 28 FEET OF LOT 6, EXCEPTING A STRIP OF LAND 1 FOOT WIDE EAST AND WEST AND 30 FEET LONG NORTH AND SOUTH OUT OF THE SOUTHWEST CORNER OF SAID 28 FEET, ALL LOCATED IN BLOCK 30 OF THE VILLAGE OF GENEVA, NOW CITY, WALWORTH COUNTY, WISCONSIN.

ORDERED BY: KEEFE REAL ESTATE
704 MAIN STREET
LAKE GENEVA, WISCONSIN
53147

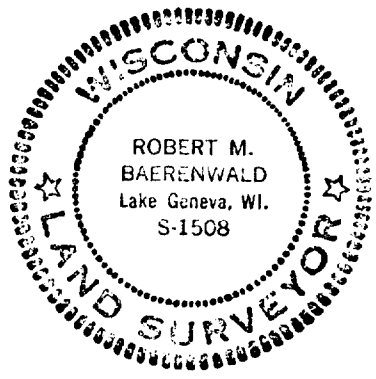




SCALE: 1"=20'

+ -CUT CROSS IN CONCRETE

I, ROBERT M. BAERENWALD, HEREBY CERTIFY THAT I HAVE SURVEYED THE PROPERTY HEREON DESCRIBED ACCORDING TO THE OFFICIAL RECORDS AND THAT THE PLAT HEREON IS A CORRECT REPRESENTATION OF THE PROPERTY LINES TO THE BEST OF MY KNOWLEDGE AND BELIEF.

Robert M. Baerenwald
ROBERT M. BAERENWALD
WISCONSIN REGISTERED LAND SURVEYOR, S-1508

May 6, 1985
DATE JOB NO. 0264

ZOP-00321-ZOP-00322

7-792-B