
PLAT OF SURVEY OF THE

NORTH 60 FEET OF LOTS 6 & 7 BLOCK 16 LOCATED IN GENEVA LAKE CRAWFORD MANUFACTURING COMPANY'S ADDITION, T2N, R17E, CITY OF LAKE GENEVA, WALWORTH COUNTY, WISCONSIN.


JENSEN SURVEYING & MAPPING S.C.
P.O. Box 322
45 SOUTH WISC. ST.
ELKHORN, WISCONSIN 53121

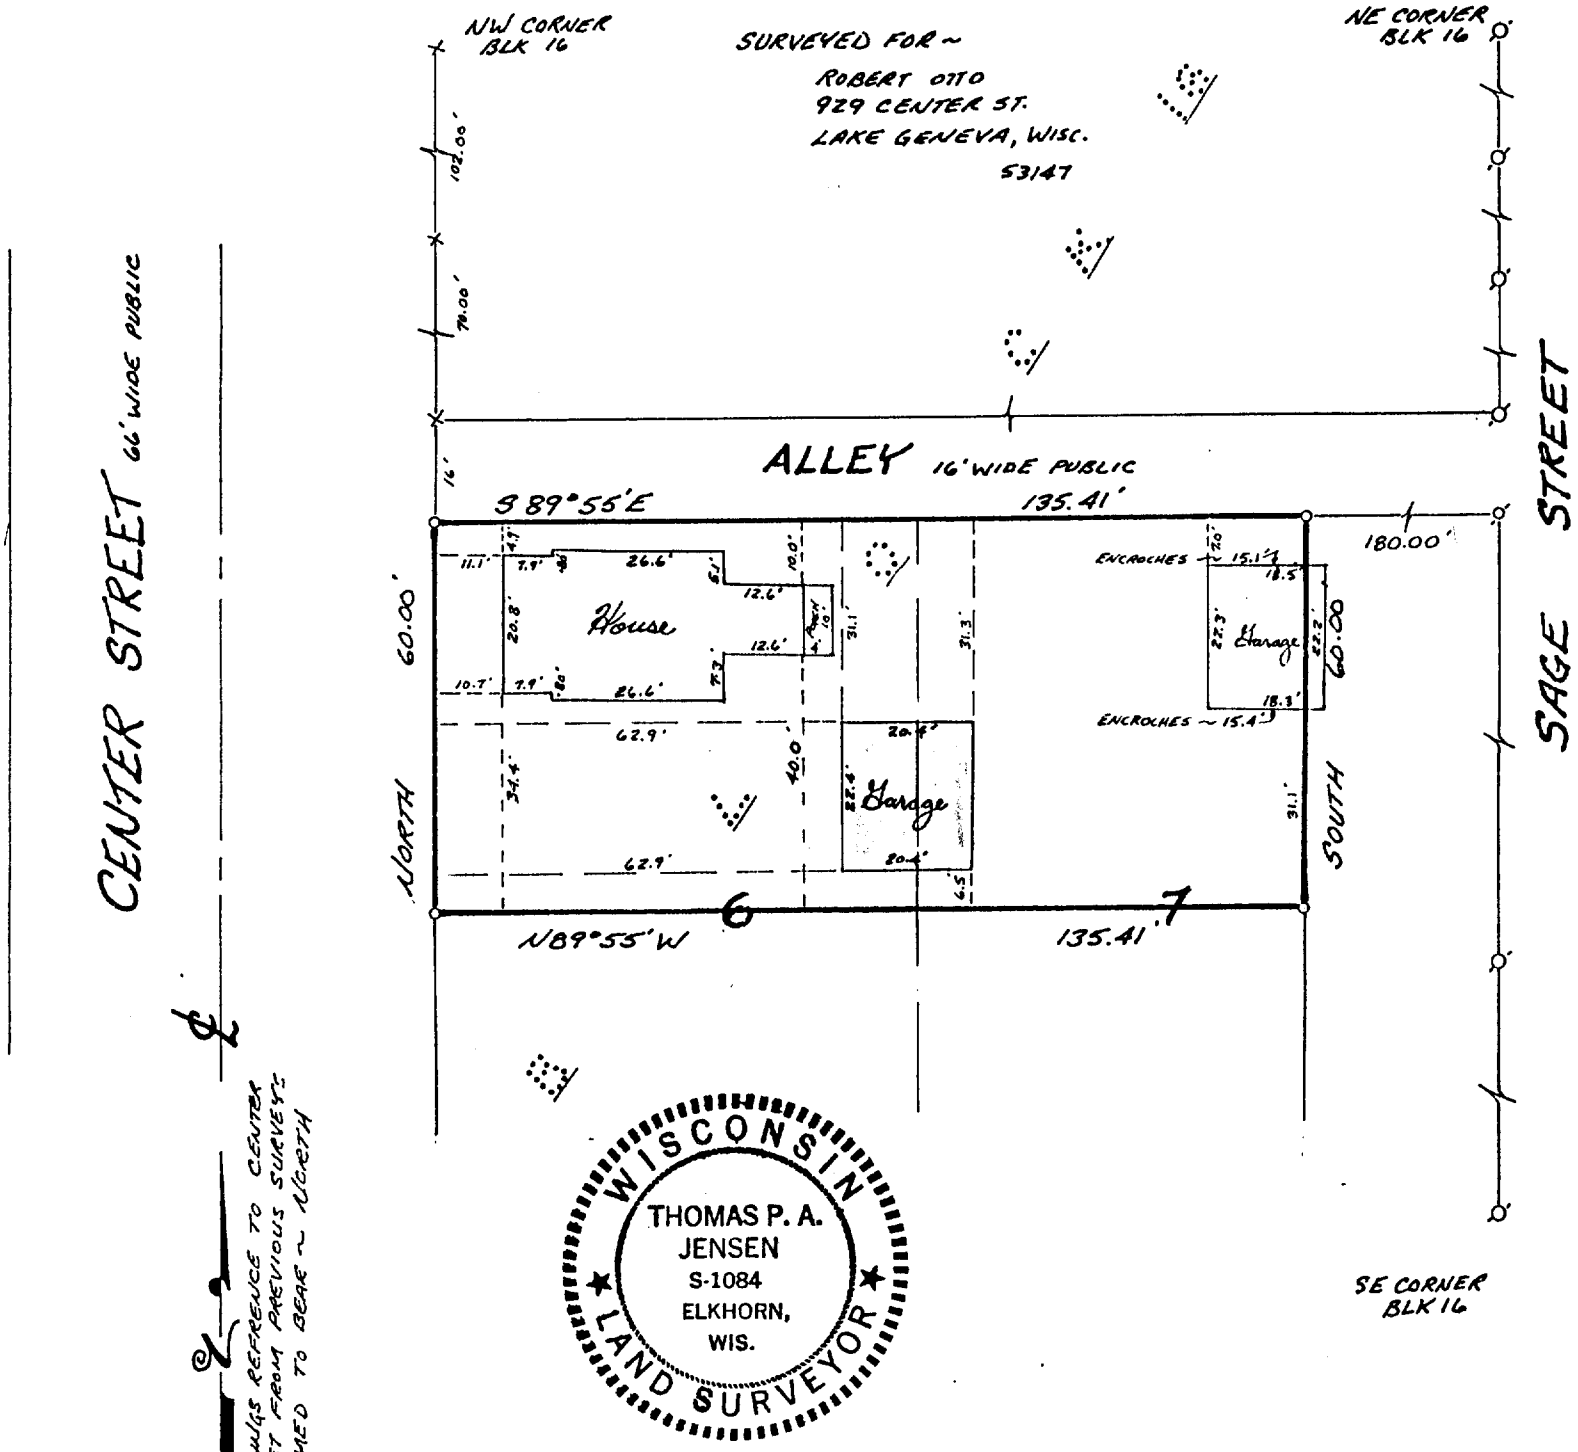

WISCONSIN
THOMAS P. A. JENSEN
S-1084
ELKHORN, WIS.
LAND SURVEYOR

SCALE 1" = 30'

Date ~ May 16, 1985

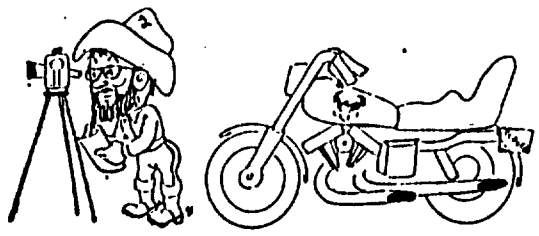

LEGEND

- ⌀ ~ FOUND 2" DIA. IRON PIPE
- ⌀ ~ FOUND 1" DIA IRON PIPE
- o ~ SET ¾" DIA IRON ROD
- X ~ FOUND CHISEL CROSS CUT IN SIDEWALK

I, THOMAS P.A. JENSEN, WISC. REGISTERED LAND SURVEYOR, DO HEREBY CERTIFY THAT THIS SURVEY WAS PERFORMED BY ME OR UNDER MY DIRECTION, IN FULL COMPLIANCE WITH THE OWNER'S / AGENT'S INSTRUCTIONS AND CHAPTER AE-5 OF WISC. ADMIN. CODE "MINIMUM STANDARDS FOR PROPERTY SURVEYS"; AND THAT THIS MAP IS AN ACCURATE REPRESENTATION THEREOF TO THE BEST OF MY KNOWLEDGE AND BELIEF.

RECEIVED
NOV 14 1985

Thomas P.A. Jensen
THOMAS P.A. JENSEN S-1084

7-800-J