
ABELL
SURVEYING & MAPPING
DELAVAN, WISCONSIN 53115
414-728-6737

RECEIVED
JUN 9 1986

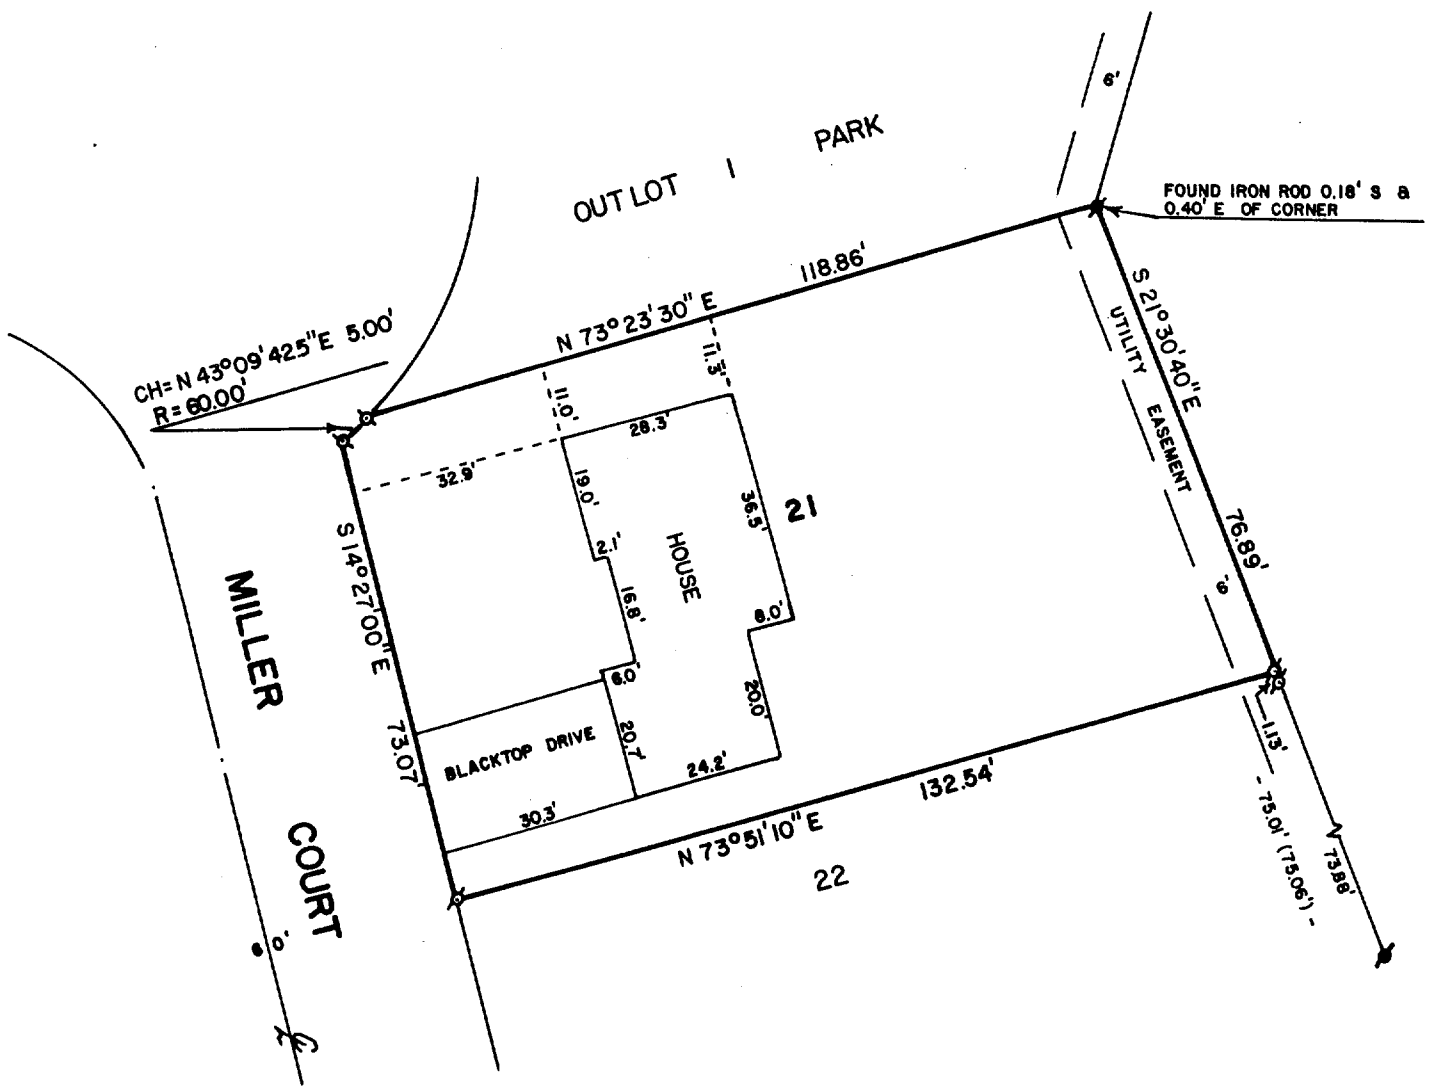

PLAT OF SURVEY OF

LOT 21 OF WESTGATE SUBDIVISION, CITY OF LAKE GENEVA, WALWORTH COUNTY, WISCONSIN, AS PER THE RECORDED PLAT OF SAID SUBDIVISION RECORDED IN VOLUME 17 OF PLATS ON PAGES 32 AND 33 IN THE OFFICE OF THE REGISTER OF DEEDS IN AND FOR WALWORTH COUNTY, WISCONSIN.

ORDERED BY: ANCHOR SAVINGS & LOAN
201 BROAD STREET
LAKE GENEVA, WI 53147

BUYER: ROBERT A. RUSKEY and NINA H. RUSKEY

WISCONSIN
DAVID F. ABELL
S-1596
Delavan, Wis.
LAND SURVEYOR

NOTE: BEARINGS ARE AS SHOWN ON THE SUBDIVISION PLAT OF WESTGATE SUBDIVISION, WALWORTH COUNTY, WI.

SCALE - 1"=30'

LEGEND
- IRON PIPE FOUND
- IRON ROD FOUND
( ) - RECORDED AS

I, DAVID F. ABELL, DO HEREBY CERTIFY THAT I HAVE SURVEYED THE PROPERTY HEREON DESCRIBED ACCORDING TO THE OFFICIAL RECORDS, AND THAT THE PLAT HEREON IS A CORRECT REPRESENTATION OF THE LOT LINES TO THE BEST OF MY KNOWLEDGE AND BELIEF.

David F. Abell
DAVID F. ABELL
WISCONSIN REGISTERED LAND SURVEYOR, S-1596

April 15, 1986
DATE JOB NUMBER - 0486003

ZWG-00021

7-801-A