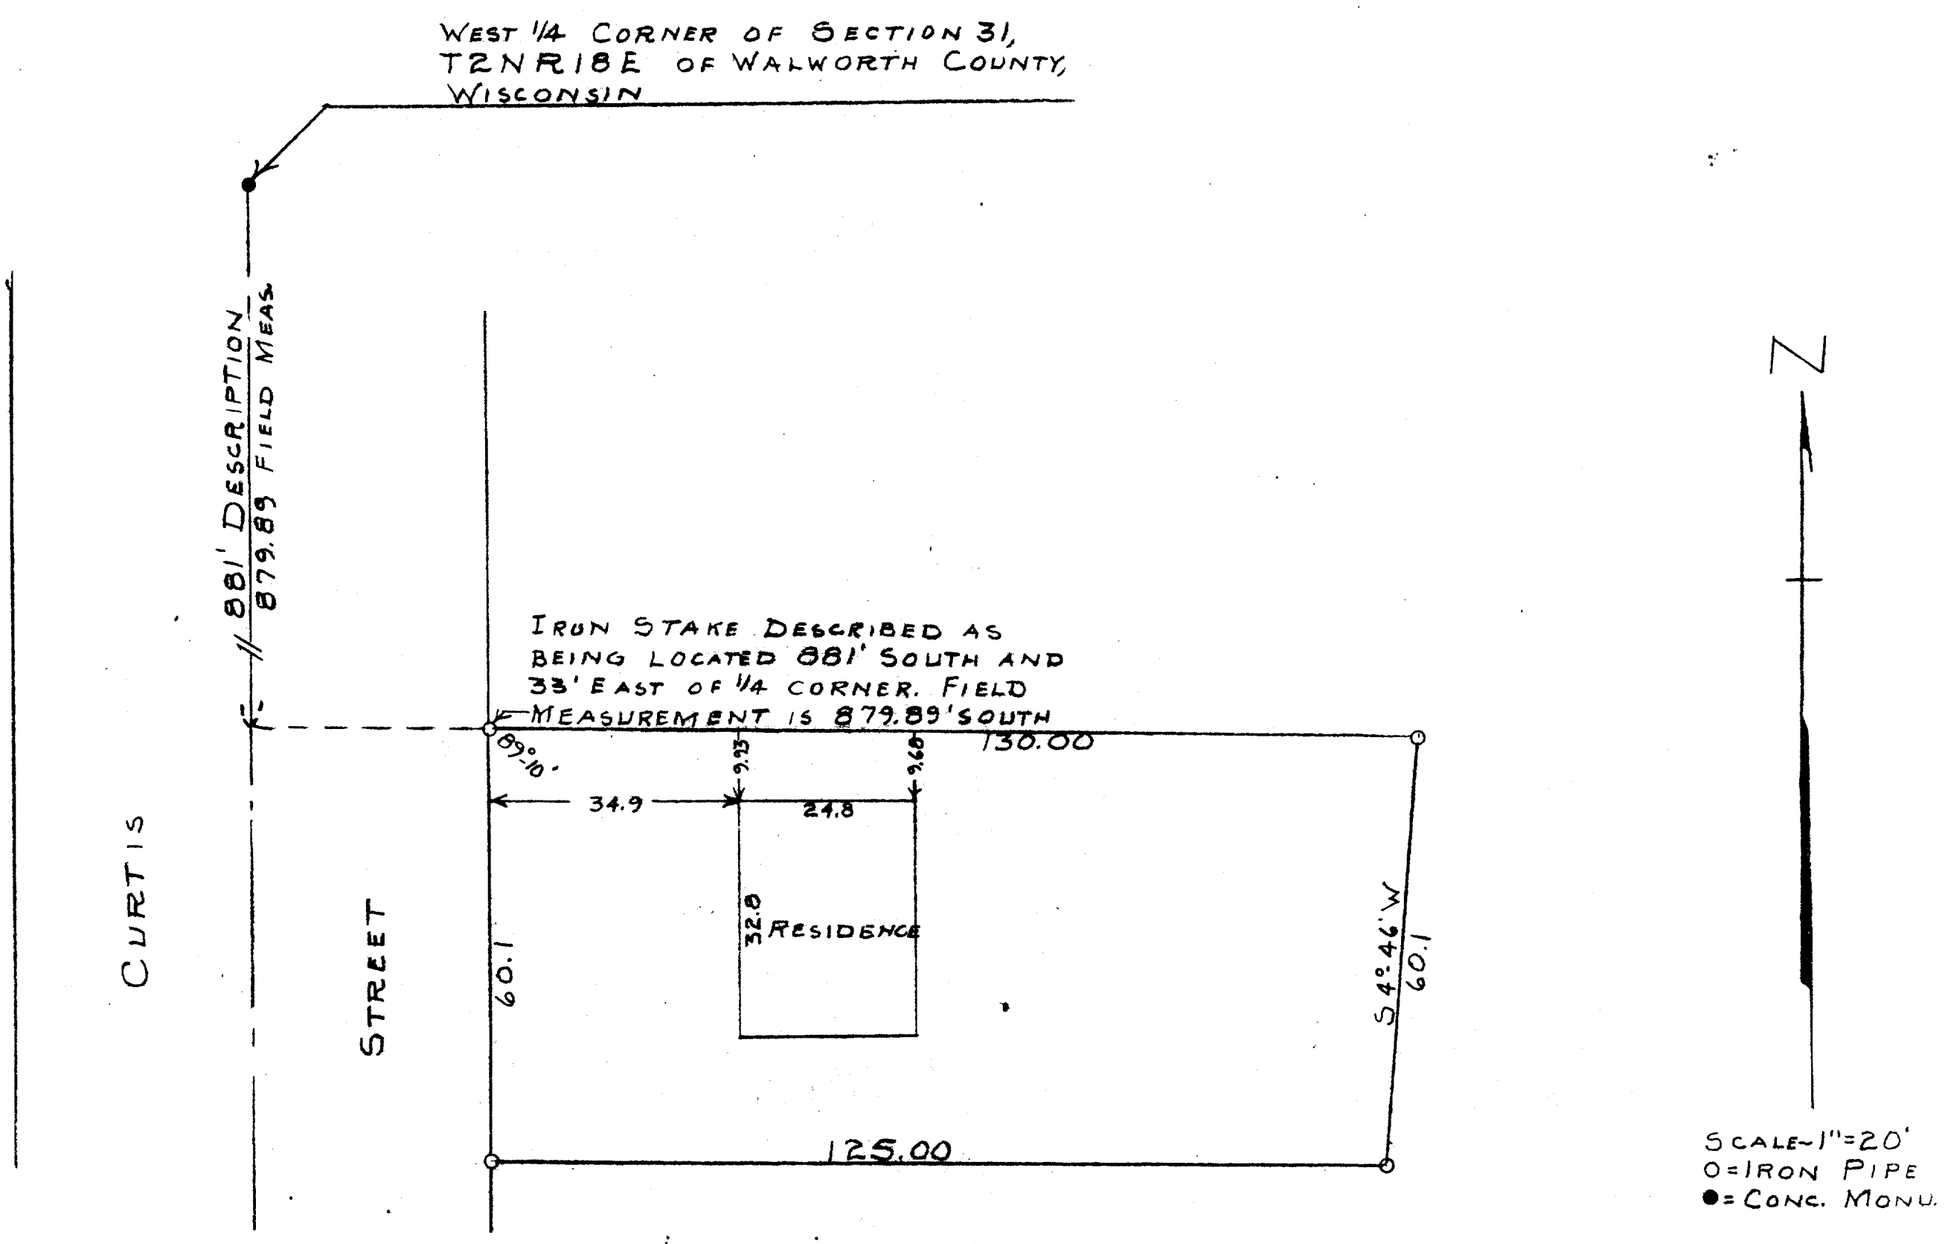


NOTE: IRON STAKES WERE FOUND AT THE FOUR CORNERS OF THE PROPERTY.

STATE OF WISCONSIN) SS
WALWORTH COUNTY)

I, GEORGE T. DUNHAM, DO HEREBY CERTIFY THAT I HAVE SURVEYED THE PROPERTY DESCRIBED AS FOLLOWS:

A PARCEL OF LAND LOCATED IN THE SOUTHWEST 1/4 OF SECTION 31, T2N R18E OF WALWORTH COUNTY, WISCONSIN. DESCRIBED AS FOLLOWS TO-WIT: COMMENCING AT AN IRON STAKE THAT IS 881 FEET SOUTH AND 33 FEET EAST OF THE WEST 1/4 CORNER OF SECTION 31-2-18 OF THE 4TH P.M, THENCE EAST 130 FEET; TO AN IRON STAKE; THENCE S 4° 46' W 60.1 FEET TO AN IRON STAKE; THENCE WEST 125 FEET TO AN IRON STAKE; THENCE NORTH 60 FEET TO THE PLACE OF BEGINNING.

AND THAT THE PLAT SHOWN ABOVE IS A CORRECT REPRESENTATION OF THE PROPERTY LINES AND OF THE IMPROVEMENTS LOCATED THEREON

MAY 16, 1958

George T. Dunham

GEORGE T. DUNHAM, SURVEYOR 7~~8~~84G
DELAVAN, WISCONSIN

UP-127