
#127-73

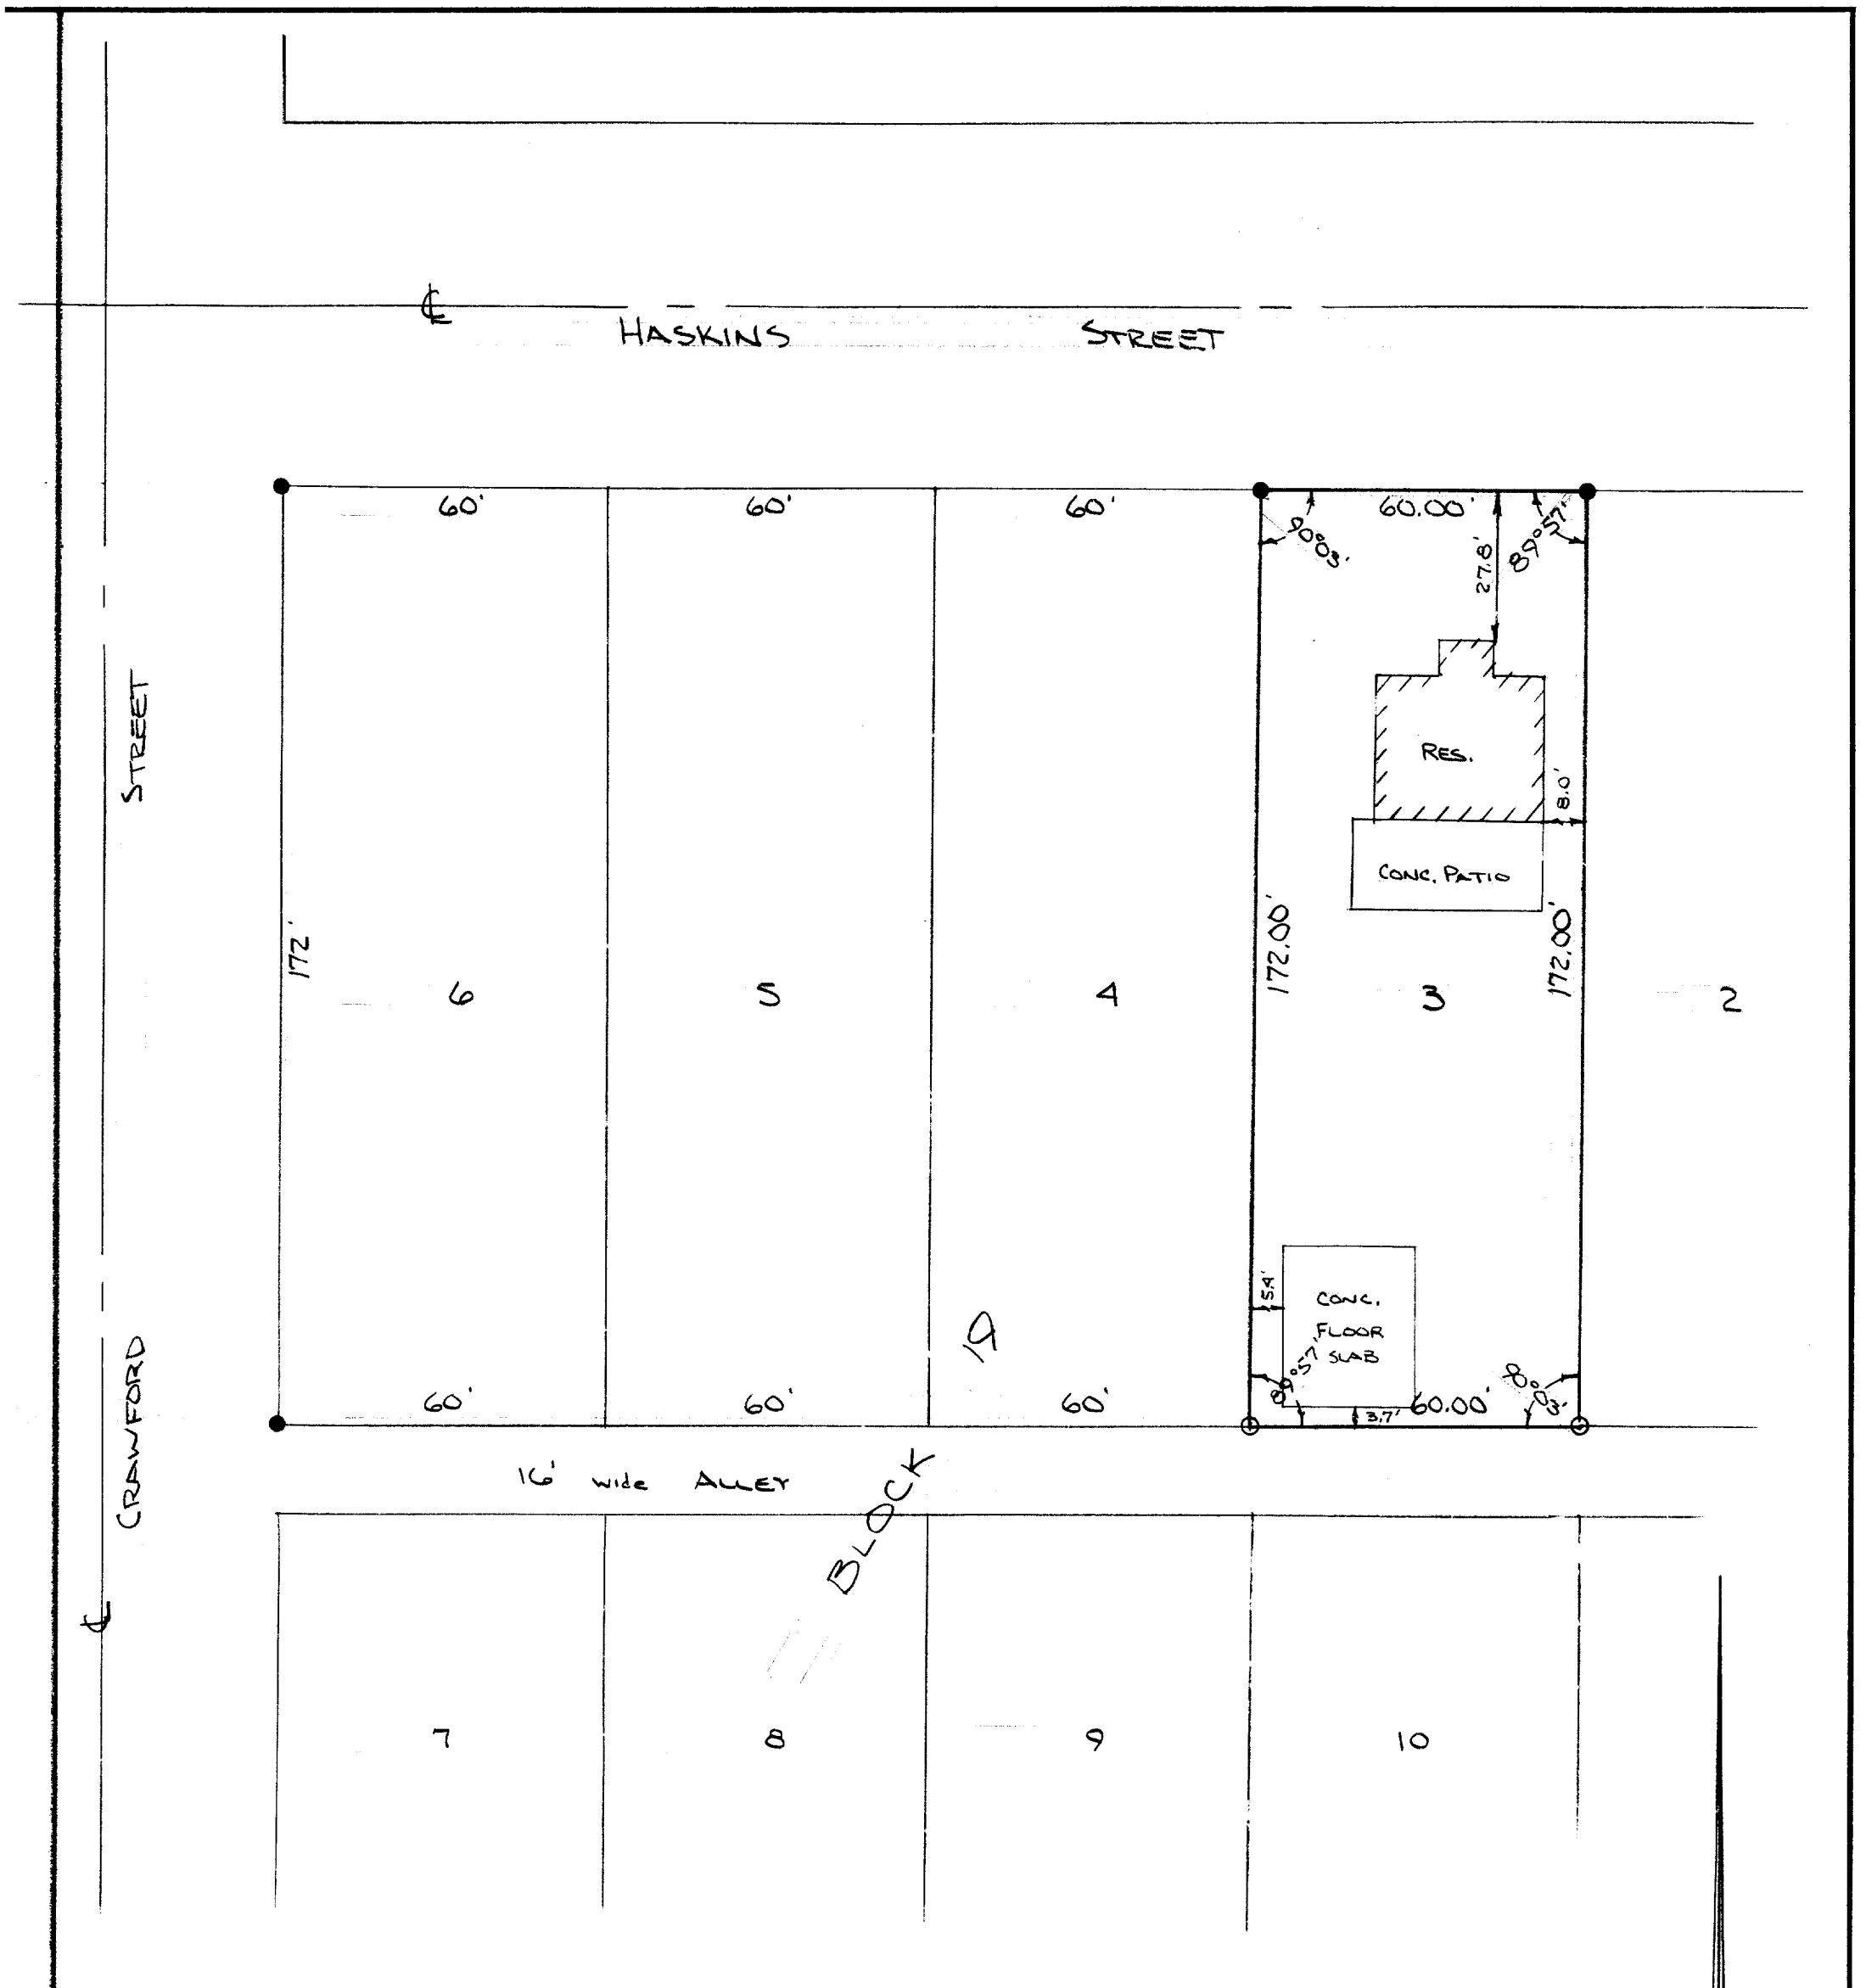

DESCRIPTION:
All of Lot 3 Block 19 of Geneva Lake Crawford Mfg. Co. Addition, a subdivision located in the SE¼ of Section 25, T2N, R17E, Lake Geneva, Walworth County, Wisconsin

CERTIFICATE:
I, Joseph M. Biagi, surveyor, do hereby certify that I have surveyed the Property hereon described.

DATE:
November 26, 1973

● - INDICATES IRON PIPE FOUND
○ - INDICATES IRON PIPE SET

Joseph M. Biagi RLS #12
Elkhorn, Wisconsin

LOT 3 BLOCK 19 GENEVA LAKE CRAWFORD MFG. CO. ADD.

SCALE: 1"=30'-0"	APPROVED BY:	DRAWN BY GW
DATE: Nov. 26, '73		REVISED

ENGINEERS ASSOCIATED, INC.
~~200~~ W. WALWORTH STREET
ELKHORN, WISCONSIN 53121

DRAWING NUMBER 127-73

LOC 1138

7-85 B