
#133-65

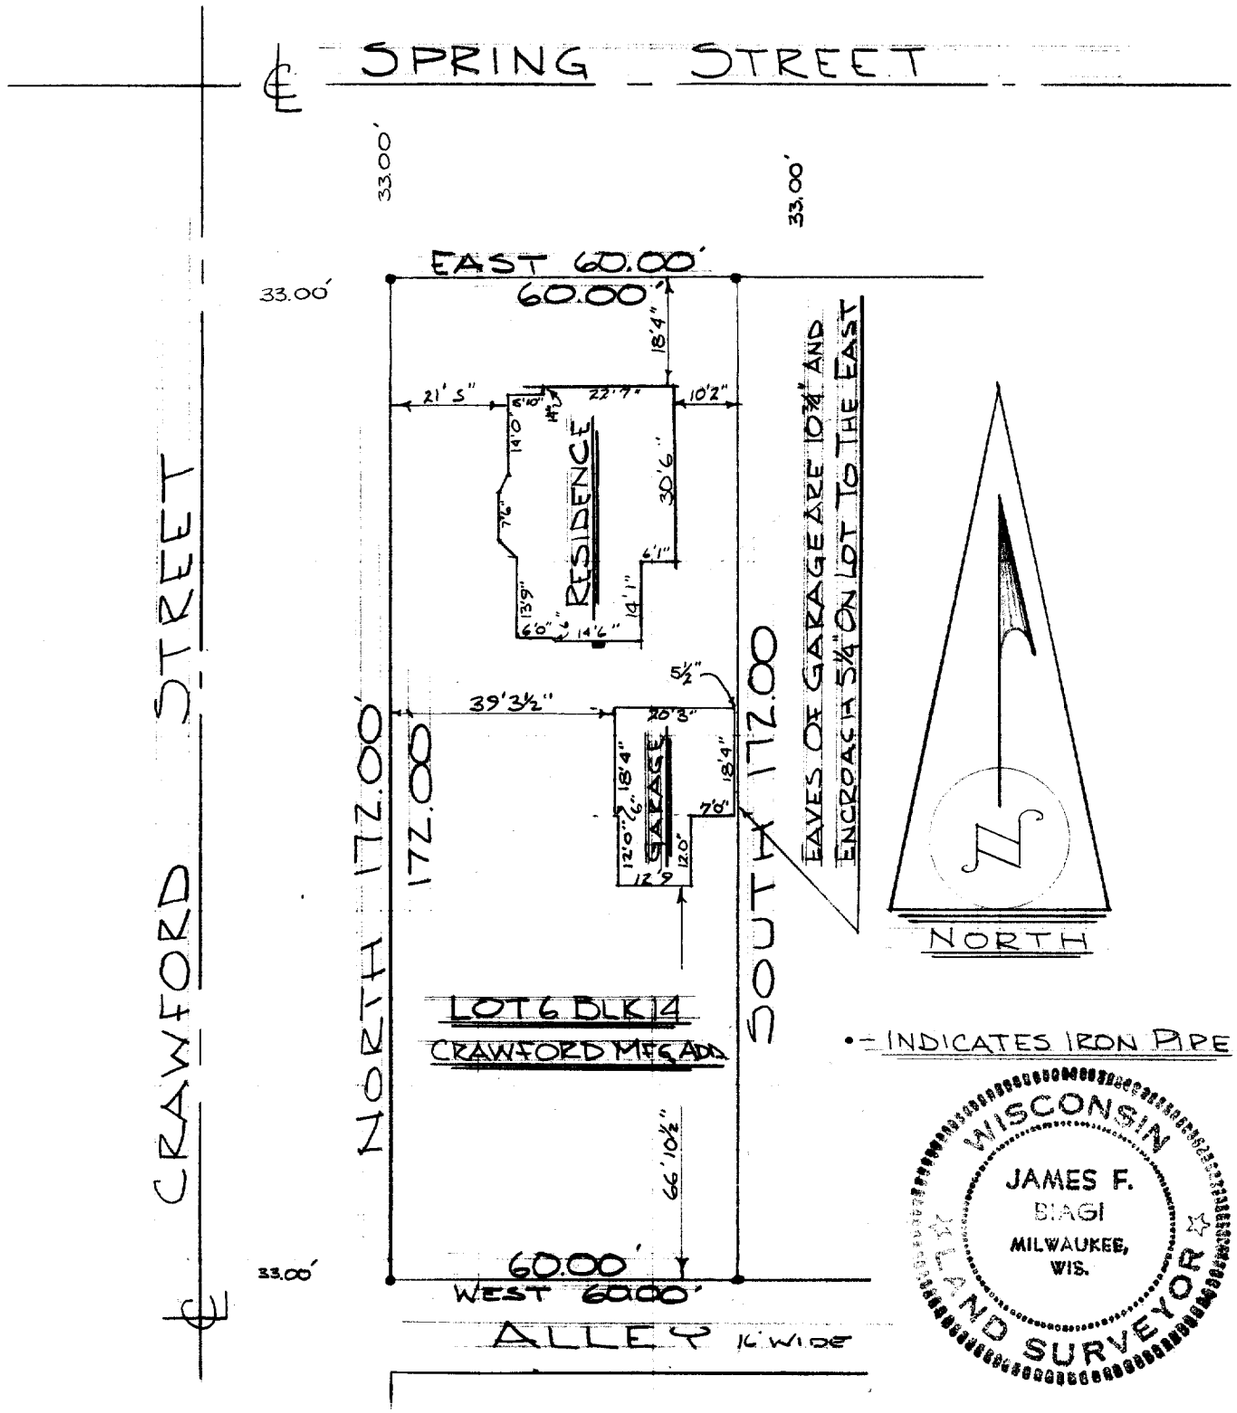

DESCRIPTION: Lot 6 Block 14, Geneva Lake Crawford Manufacturing Company Addition to the City of Lake Geneva, Walworth County, Wisconsin.

CERTIFICATE: I, James F. Biagi, surveyor, do hereby certify that I have surveyed the property hereon described and that the location of the improvements are as shown.

April 14, 1965.

James F. Biagi RLS 272

7-86 B