
KOLB LAND CONSULTING, INC.

LAND SURVEYING · SUBDIVIDING · LAND PLANNING

929 WILLIAMS STREET LAKE GENEVA, WISCONSIN 53147 414-248-3697

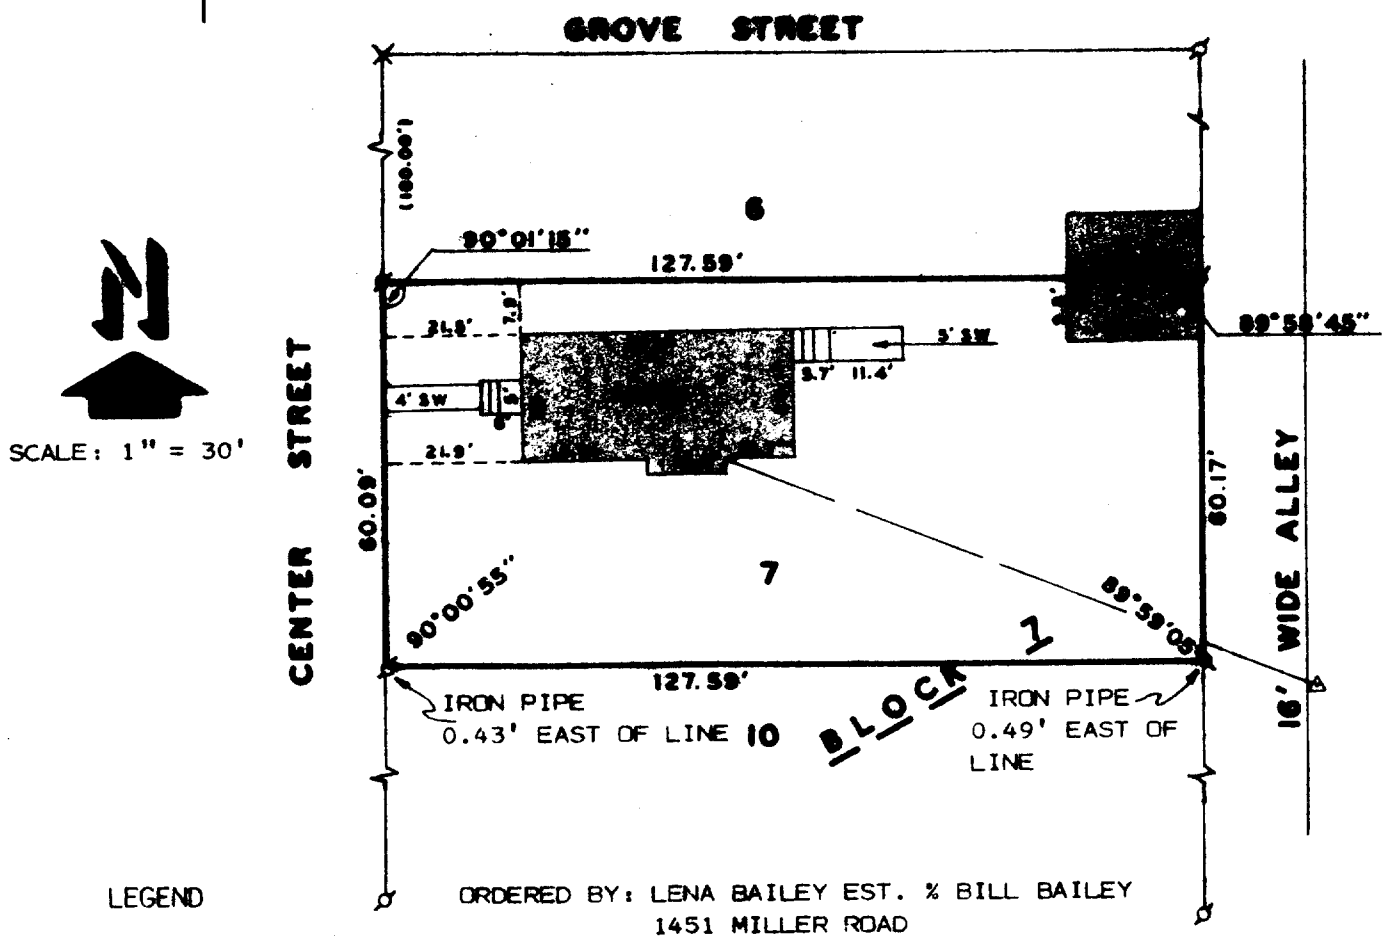

LEGEND

- ø - IRON PIPE FOUND
- ø - IRON ROD FOUND
- SW - SIDE WALK
- Δ - UTILITY POLE
- ——— - OVERHEAD UTILITY LINE
- X - SPIKE FOUND

ORDERED BY: LENA BAILEY EST. % BILL BAILEY
1451 MILLER ROAD
LAKE GENEVA, WI. 53147

PLAT OF SURVEY OF

LOT 7, BLOCK 7, OF GENEVA LAKE CRAWFORD MANUFACTURING COMPANY ADDITION, CITY OF LAKE GENEVA, WALWORTH COUNTY, WISCONSIN.

RECEIVED
NOV 13 1986

I HEREBY CERTIFY THAT I HAVE SURVEYED THE ABOVE DESCRIBED PROPERTY AND THAT THE ABOVE MAP IS A TRUE REPRESENTATION THEREOF AND SHOWS THE SIZE AND LOCATION OF THE PROPERTY, ITS EXTERIOR BOUNDARIES, THE LOCATION OF ALL VISIBLE STRUCTURES AND DIMENSIONS OF ALL PRINCIPAL BUILDINGS THEREON, BOUNDARY FENCES, APPARENT EASEMENTS, ROADWAYS AND VISIBLE ENCROACHMENTS, IF ANY, TO THE BEST OF MY KNOWLEDGE AND BELIEF.
THIS SURVEY IS MADE FOR THE USE OF THE PRESENT OWNERS OF THE PROPERTY AND ALSO THOSE WHO PURCHASE, MORTGAGE, OR GUARANTEE THE TITLE THERETO WITHIN ONE (1) YEAR FROM DATE HEREOF.

WISCONSIN HAROLD H. KOLB S-187 LAKE GENEVA, WIS LAND SURVEYOR

Harold H. Kolb

HAROLD H. KOLB

WISCONSIN REGISTERED LAND SURVEYOR, S-187

DATE SEPTEMBER 19, 1986

REVISED _____

REVISED _____

26C-21 LG-ZGC-21 7-85K