
RECEIVED
NOV 1 3 1986

KOLB LAND CONSULTING, INC.

LAND SURVEYING · SUBDIVIDING · LAND PLANNING

929 WILLIAMS STREET LAKE GENEVA, WISCONSIN 53147 414-248-3697

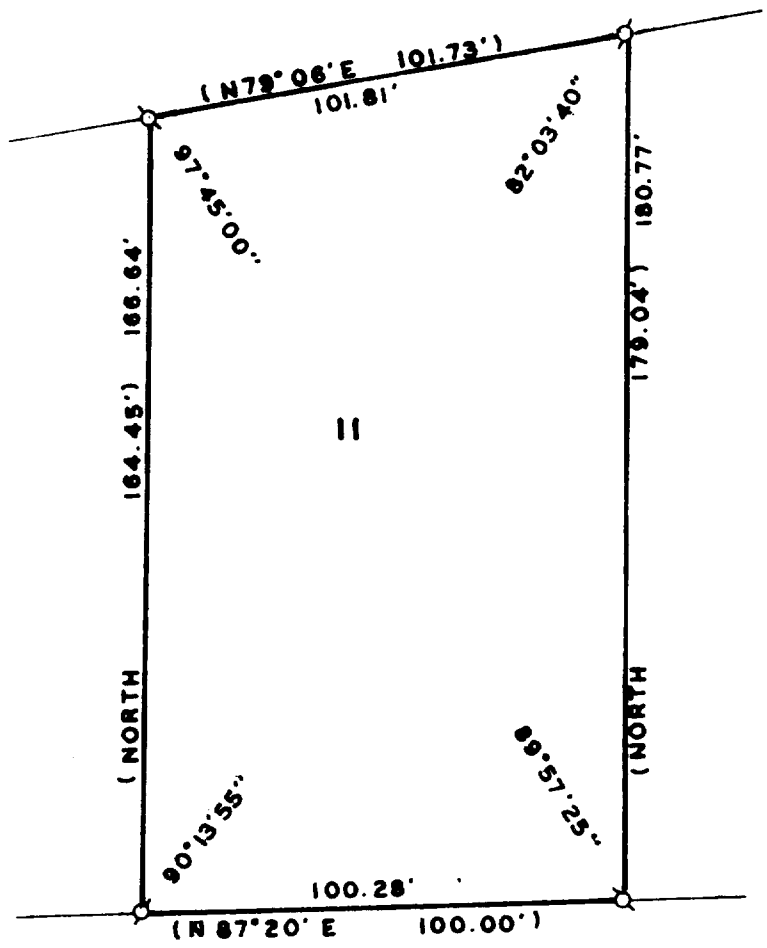

SCALE: 1" = 40'

LEGEND

ø - IRON PIPE FOUND
( ) - AS RECORDED

NOTE: ANGLES SHOWN ARE FROM FIELD WORK.

℄

LAGRANGE DRIVE 50' WIDE

PLAT OF SURVEY OF

LOT 11 OF THE LAKE GENEVA EAST SHORE EST., CITY OF LAKE GENEVA, WALWORTH COUNTY, WISCONSIN.

ORDERED BY: CENTURY 21
152 CENTER ST.
LAKE GENEVA, WI. 53147

I, HAROLD H. KOLB, DO HEREBY CERTIFY THAT I HAVE SURVEYED THE PROPERTY HEREON DESCRIBED ACCORDING TO THE OFFICIAL RECORDS AND THAT THE PLAT HEREON IS A CORRECT REPRESENTATION OF THE LOT LINES TO THE BEST OF MY KNOWLEDGE AND BELIEF.

Harold H. Kolb

HAROLD H. KOLB

WISCONSIN REGISTERED LAND SURVEYOR, S-187

DATE MAY 7, 1986

REVISED _____

REVISED _____

ZLZ-11

LG-254

7-876K