
KOLB LAND CONSULTING, INC.

LAND SURVEYING · SUBDIVIDING · LAND PLANNING

929 WILLIAMS STREET LAKE GENEVA, WISCONSIN 53147 414-248-3697

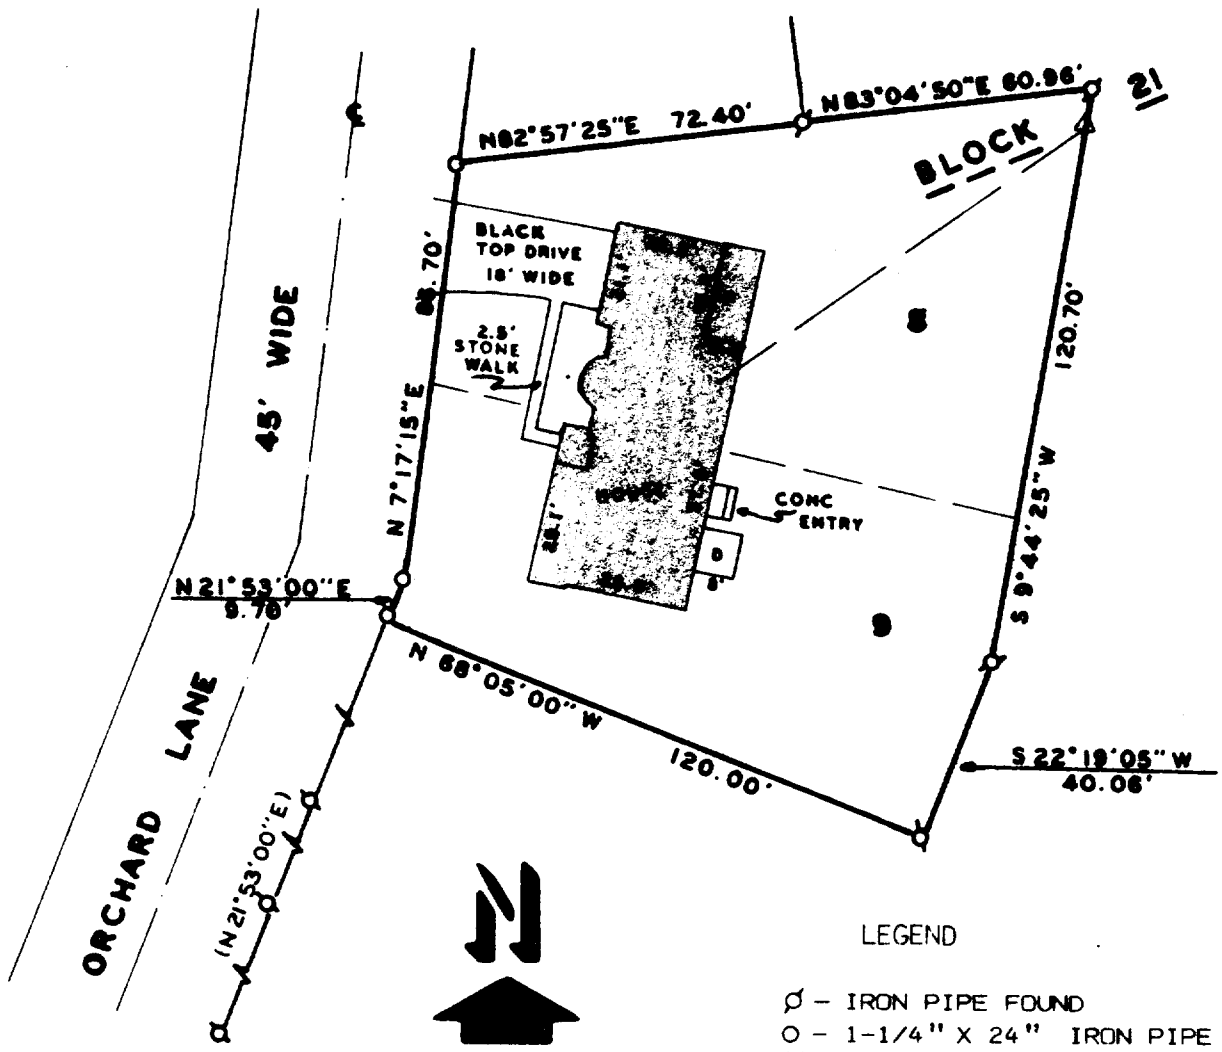

SCALE: 1" = 40'

LEGEND

- ∅ – IRON PIPE FOUND
- O – 1-1/4" X 24" IRON PIPE SET
- ( )– AS RECORDED
- △ – UTILITY POLE
- —— —— – OVERHEAD UTILITY LINE
- P – PORCH
- D – DECK

PLAT OF SURVEY OF

LOTS 8 AND 9 , BLOCK 21, OF THE LAKE GENEVA MANOR SUBDIVISION, CITY OF LAKE GENEVA, WALWORTH COUNTY, WISCONSIN.

ORDERED BY: CAYLOR FINANCIAL, INC.
405 N. CALHOUN RD.
BROOKFIELD, WI. 53005

NOTE: BEARINGS ARE ASSUMED AS SHOWN ON ORIGINAL PLAT.

OWNER: CARL MANCINI

RECEIVED
NOV 13 1986
WISCONSIN
HAROLD H. KOLB
S-187
LAND SURVEYOR

I HEREBY CERTIFY THAT I HAVE SURVEYED THE ABOVE DESCRIBED PROPERTY AND THAT THE ABOVE MAP IS A TRUE REPRESENTATION THEREOF AND SHOWS THE SIZE AND LOCATION OF THE PROPERTY, ITS EXTERIOR BOUNDARIES, THE LOCTION OF ALL VISIBLE STRUCTURES AND DIMENSIONS OF ALL PRINCIPAL BUILDINGS THEREON, BOUNDARY FENCES, APPARENT EASEMENTS, ROADWAYS AND VISIBLE ENCROACHMENTS, IF ANY, TO THE BEST OF MY KNOWLEDGE AND BELIEF.
THIS SURVEY IS MADE FOR THE USE OF THE PRESENT OWNERS OF THE PROPERTY AND ALSO THOSE WHO PURCHASE, MORTGAGE, OR GUARANTEE THE TITLE THERETO WITHIN ONE (1) YEAR FROM DATE HEREOF.

Harold H. Kolb

HAROLD H. KOLB

WISCONSIN REGISTERED LAND SURVEYOR, S- 187

DATE MAY 27, 1986

REVISED _____

REVISED _____

ZLM-58 43-ZLM-58 7-877