
#98-63

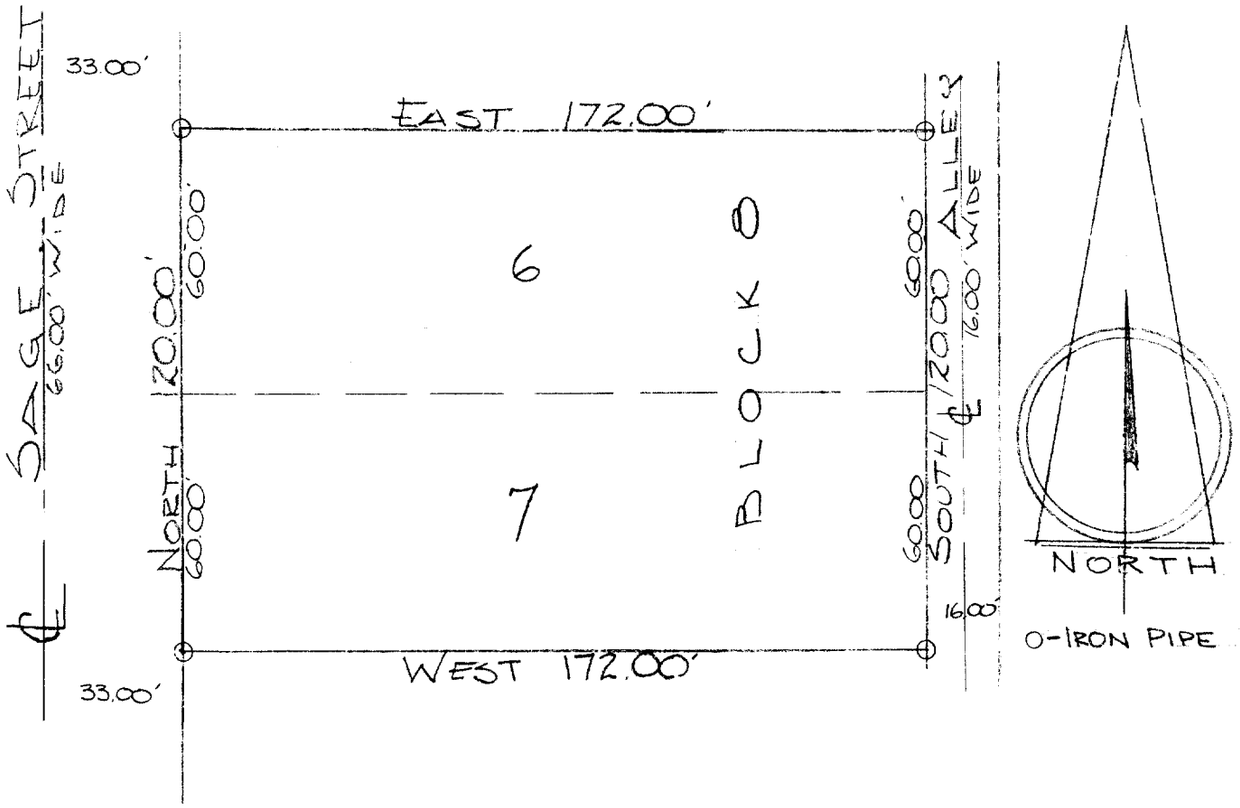

DESCRIPTION:
Lots 6 & 7 Block 8 of Geneva Lake Crawford Manufacturing Company Addition to the City of Lake Geneva, Walworth County, Wisconsin.

CERTIFICATE:
I, James F. Biagi Surveyor, do hereby certify that I have surveyed the property hereon described and portrayed on this the 13th day of August 1963.

Signed and sealed on this the 14th day of ~~August~~, 1963.

James F. Biagi

WISCONSIN
JAMES F. BIAGI
MILWAUKEE, WIS.
LAND SURVEYOR

James F. Biagi. P.E.
RLS 272 Wisconsin.
Elkhorn, Wisconsin.

7-89B