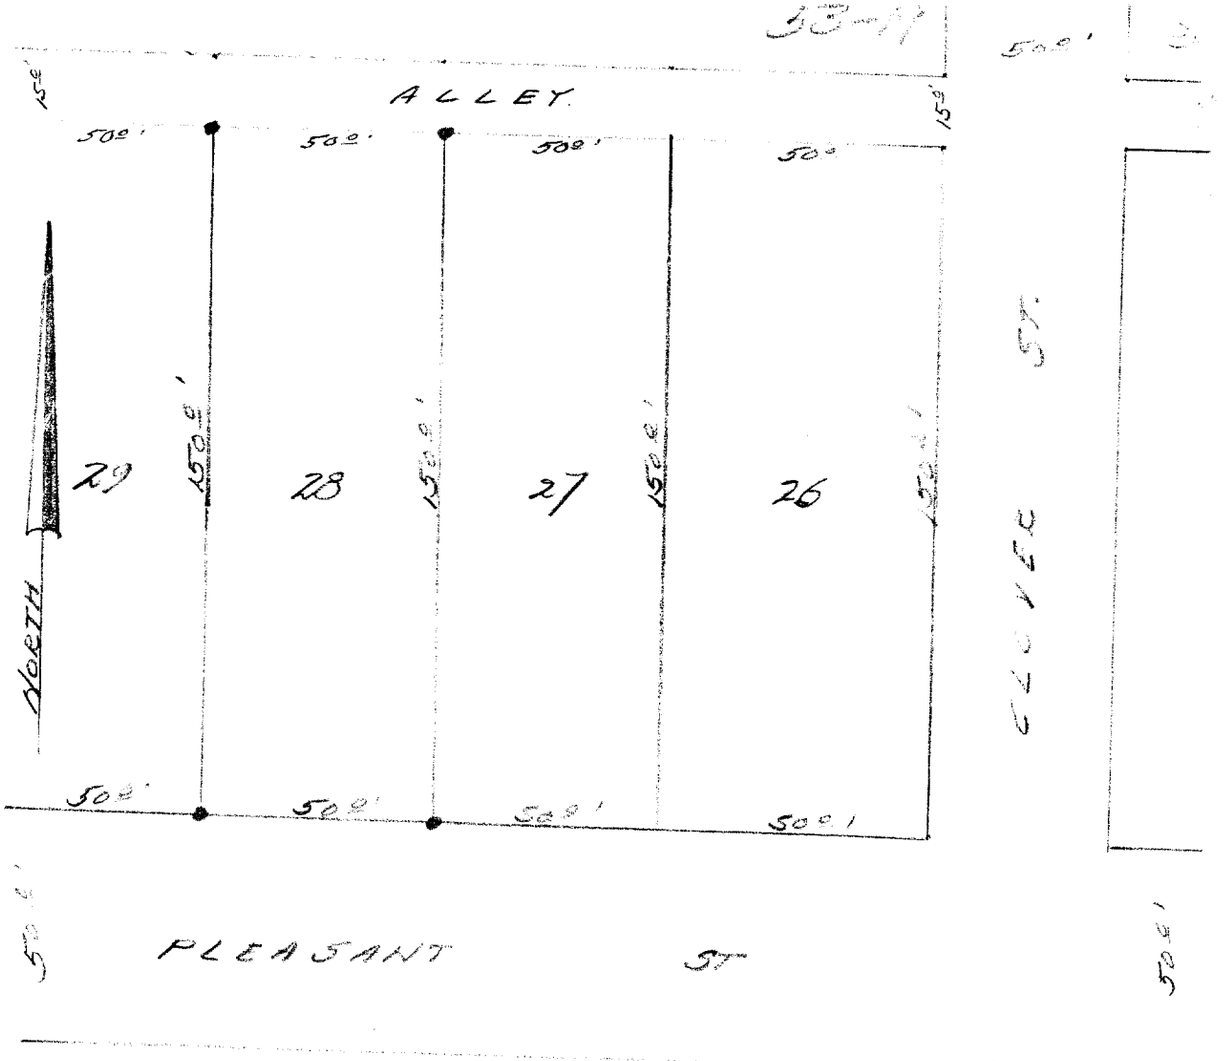

DESCRIPTION: Lot 28 Columbian Subdivision of a portion of the City of Lake Geneva Walworth County, Wisconsin.

CERTIFICATE: I, hereby certify that I have on this the 10th day of September 1953, surveyed the above described property and find that no encroachments exist.
SIGNED AND SEALED THIS 14TH DAY OF SEPTEMBER 1953.

Joseph M. Biagi. Professional Engineer.
Elkhorn Wisconsin.

7-8B