
WALWORTH COUNTY
SURVEYING & MAPPING
LAKE GENEVA, WISCONSIN

RECEIVED

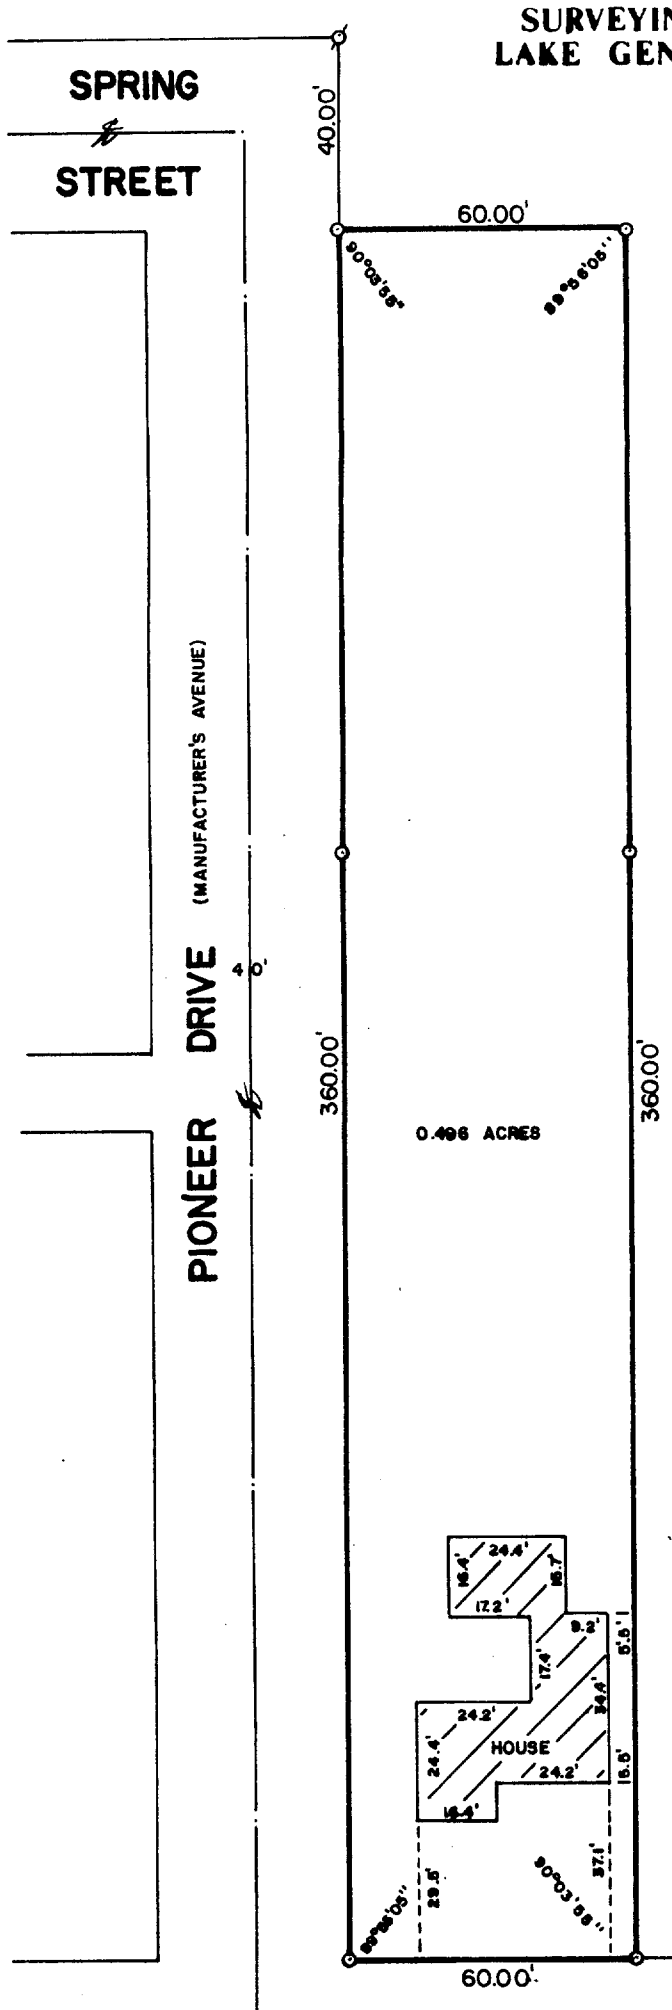

PLAT OF SURVEY OF

A PARCEL OF LAND DESCRIBED AS FOLLOWS: COMMENCING AT THE NORTHEAST CORNER OF HASKINS STREET AND MANUFACTURER'S AVENUE IN THE GENEVA LAKE CRAWFORD MANUFACTURING COMPANY'S ADDITION TO THE VILLAGE OF GENEVA, NOW CITY OF LAKE GENEVA, WALWORTH COUNTY, WISCONSIN, THENCE NORTH ON THE EAST LINE OF MANUFACTURER'S AVENUE TO THE SOUTH LINE OF SPRING STREET IN SAID ADDITION; THENCE EAST 60 FEET; THENCE SOUTH TO THE NORTH LINE OF SAID HASKINS STREET; THENCE WEST 60 FEET TO THE PLACE OF BEGINNING.

ORDERED BY: HARTWIG NOLTING
245 HASKINS STREET
LAKE GENEVA, WISCONSIN 53147

N

SCALE: 1"=40

ø -IRON PIPE FOUND
o -IRON PIPE PLACED
( )-RECORDED AS

I, ROBERT M. BAERENWALD, DO HEREBY CERTIFY THAT I HAVE SURVEYED THE PROPERTY HEREON DESCRIBED ACCORDING TO THE OFFICIAL RECORDS AND THAT THE PLAT HEREON IS A CORRECT REPRESENTATION OF THE PROPERTY LINES TO THE BEST OF MY KNOWLEDGE AND BELIEF.

Robert M. Baerenwald
ROBERT M. BAERENWALD
WISCONSIN REGISTERED LAND SURVEYOR, S-1508

April 2, 1987
DATE JOB NO. 0942

NOTE: THIS IS NOT A CERTIFIED COPY UNLESS SEALED.

24up-5

7-96