
47-13

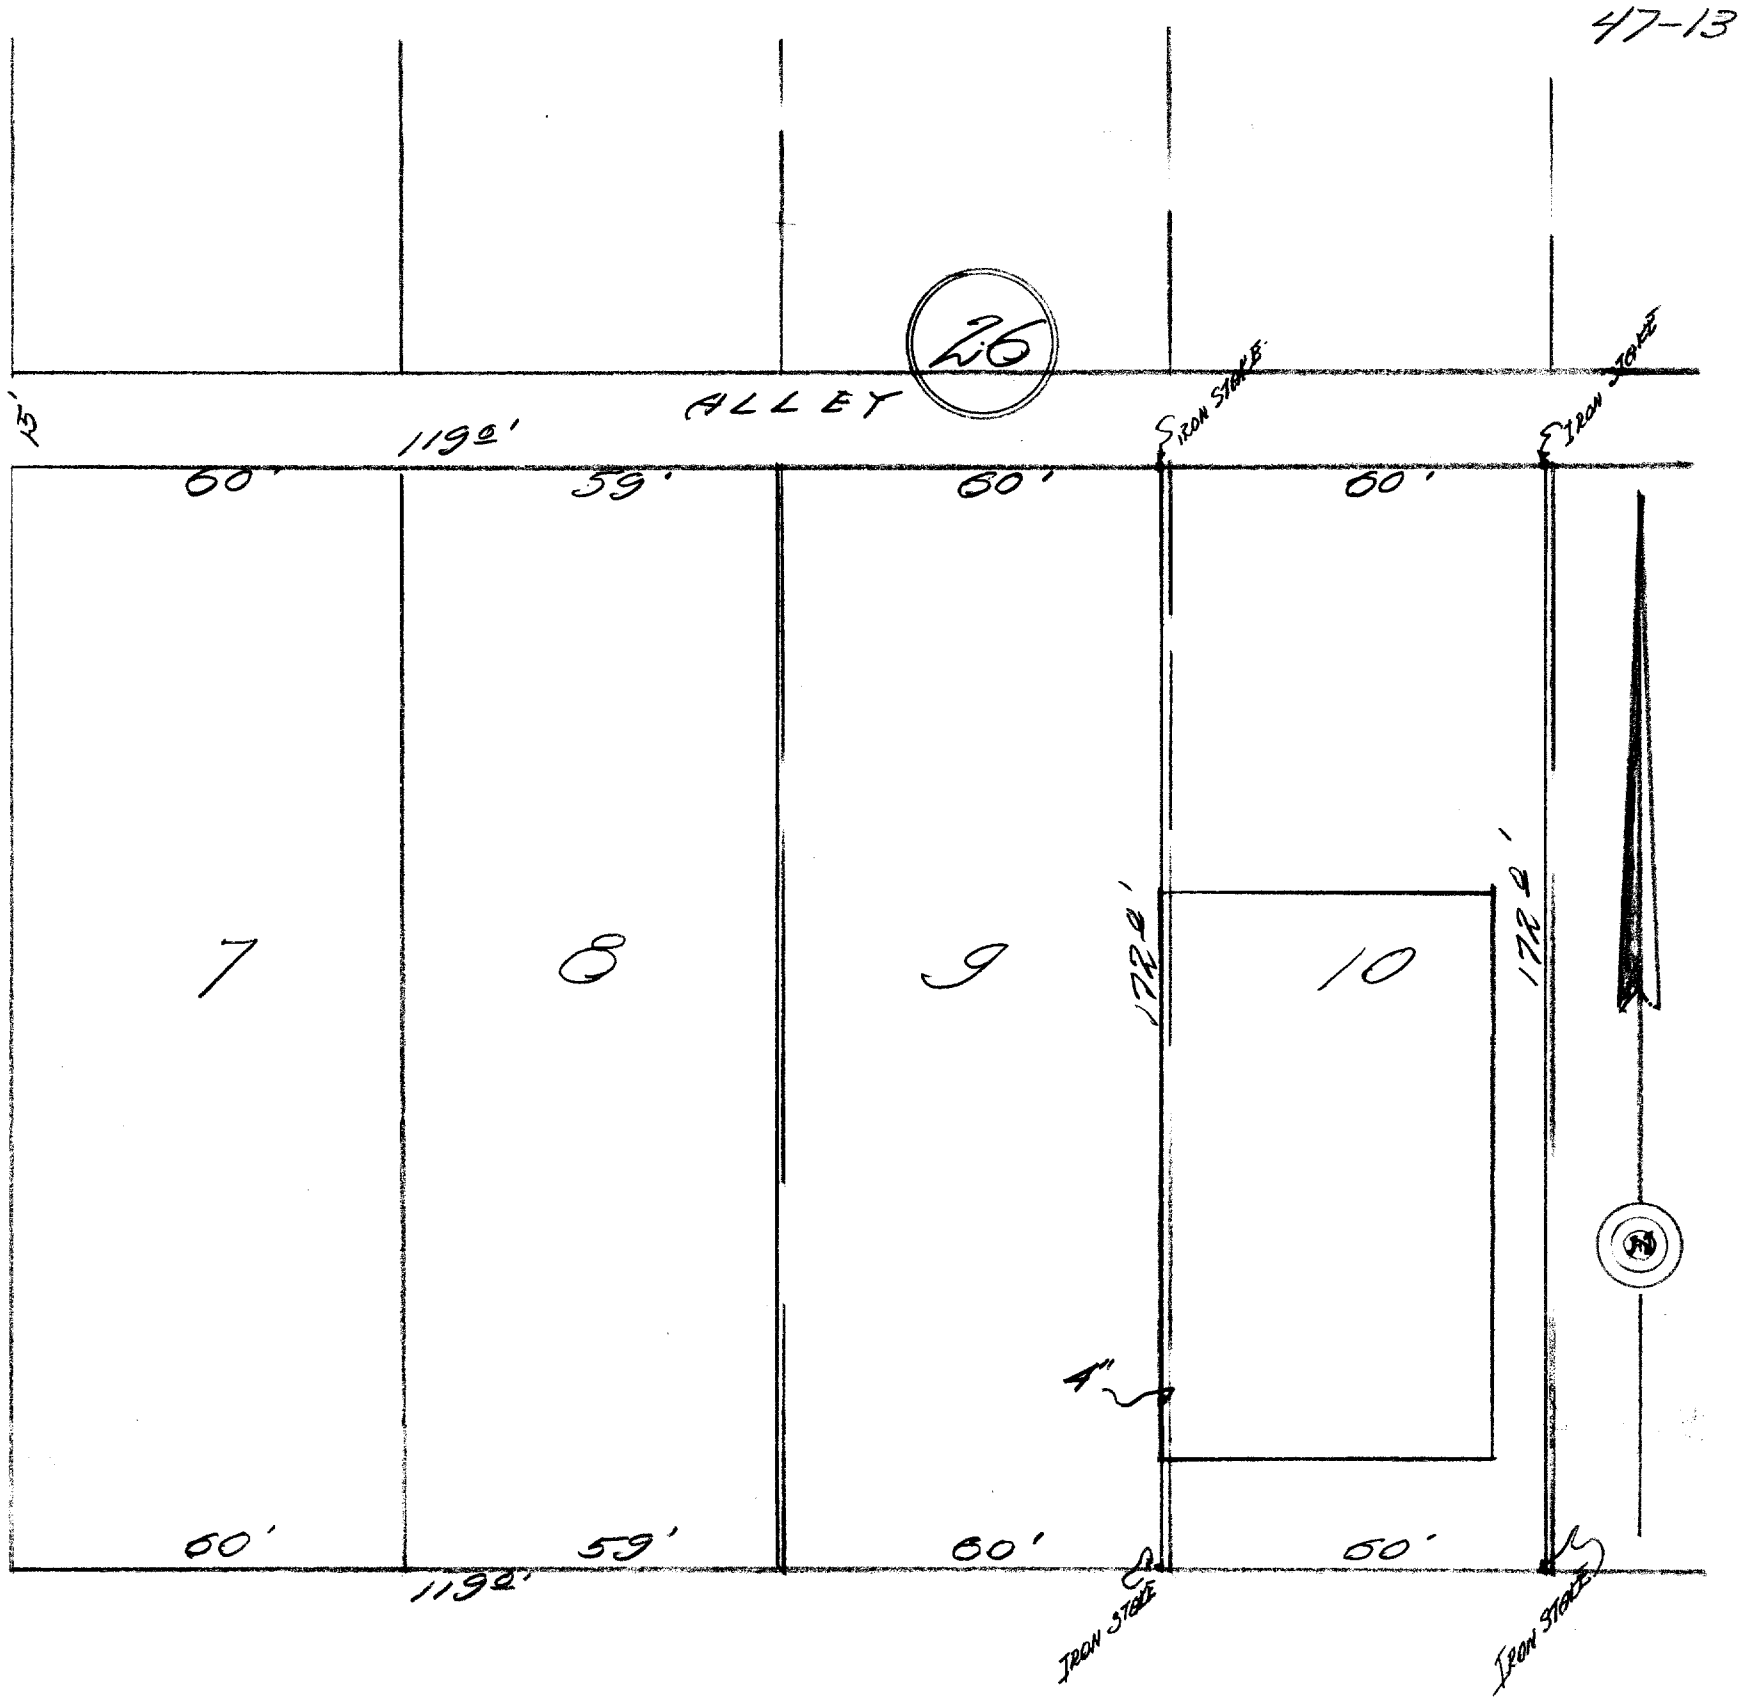

DESCRIPTION:

The West 59 feet of Lot 10, Block 26, and the East 1 foot of Lot 9, Block 26 of the Original Plat of the Village (now city) of Lake Geneva, Walworth County, Wisconsin.

CERTIFICATE:

This is to certify that I have on this the 6th day of June 1947, surveyed the above described property according to the official records on file in the office of the Recorder of Deeds in and for Walworth County, Wisconsin, and find that the measurements and bearings of the boundary lines of said property as taken at the site on this day, substantially agree with those in the above description and that the eaves on the west side of the house on said Lot 10, encroach upon Lot 9, by 4 inches.
SIGNED AND SEALED THIS 8TH DAY OF JUNE 1947.

Joseph M. Biagi.
Professional Engineer
Elkhorn Wisconsin.

OP-255

7-95B