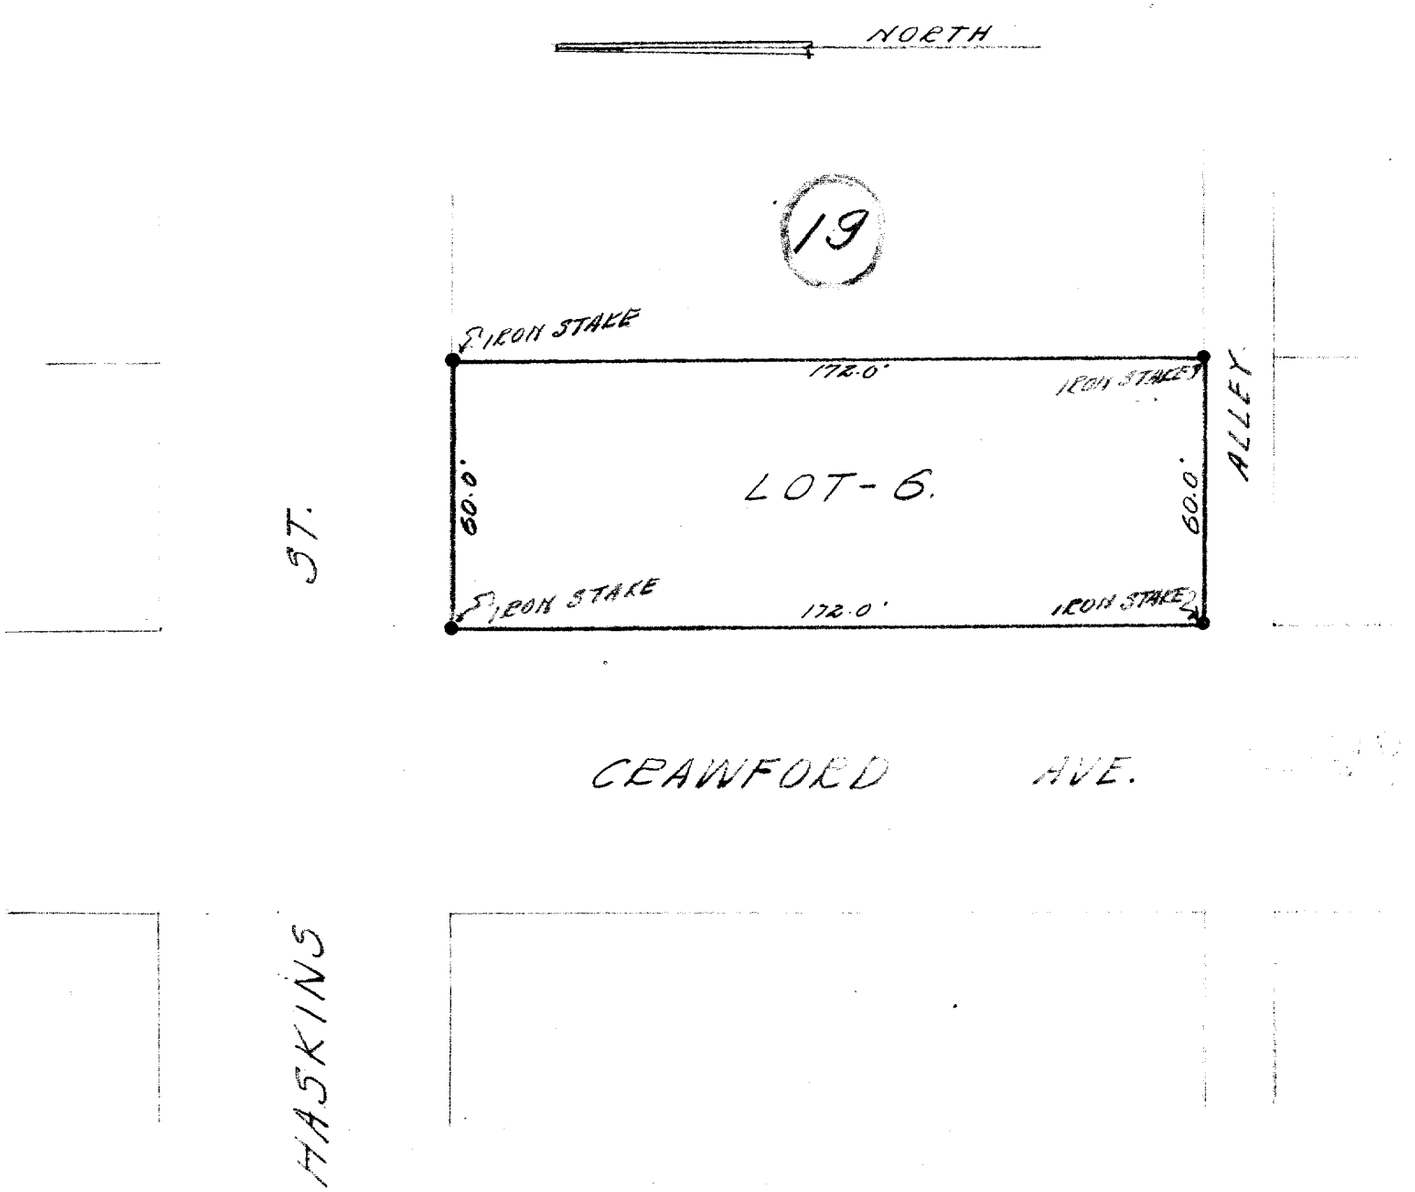


DESCRIPTION:

Lot 6 Block 19 Geneva Lake Crawford Manufacturing Co. Add. to the City of Lake Geneva, Walworth County Wisconsin.

CERTIFICATE:

I, hereby certify that I have on this the 21 st Day of April L945, surveyed the above described property according to the off icial records on file in the office of the Recorder of Deeds in and for Walworth County Wisconsin, and pre sent the above portrayed plat as an exact reproduction of the measurements and bearings taken at the site of date.
SIGNED AND SEALED THIS 23rd DAY OF APRIL 1945.

Joseph M. Biagi,
Elkhorn Wisconsin

Joseph M Biagi.

7-98B 2