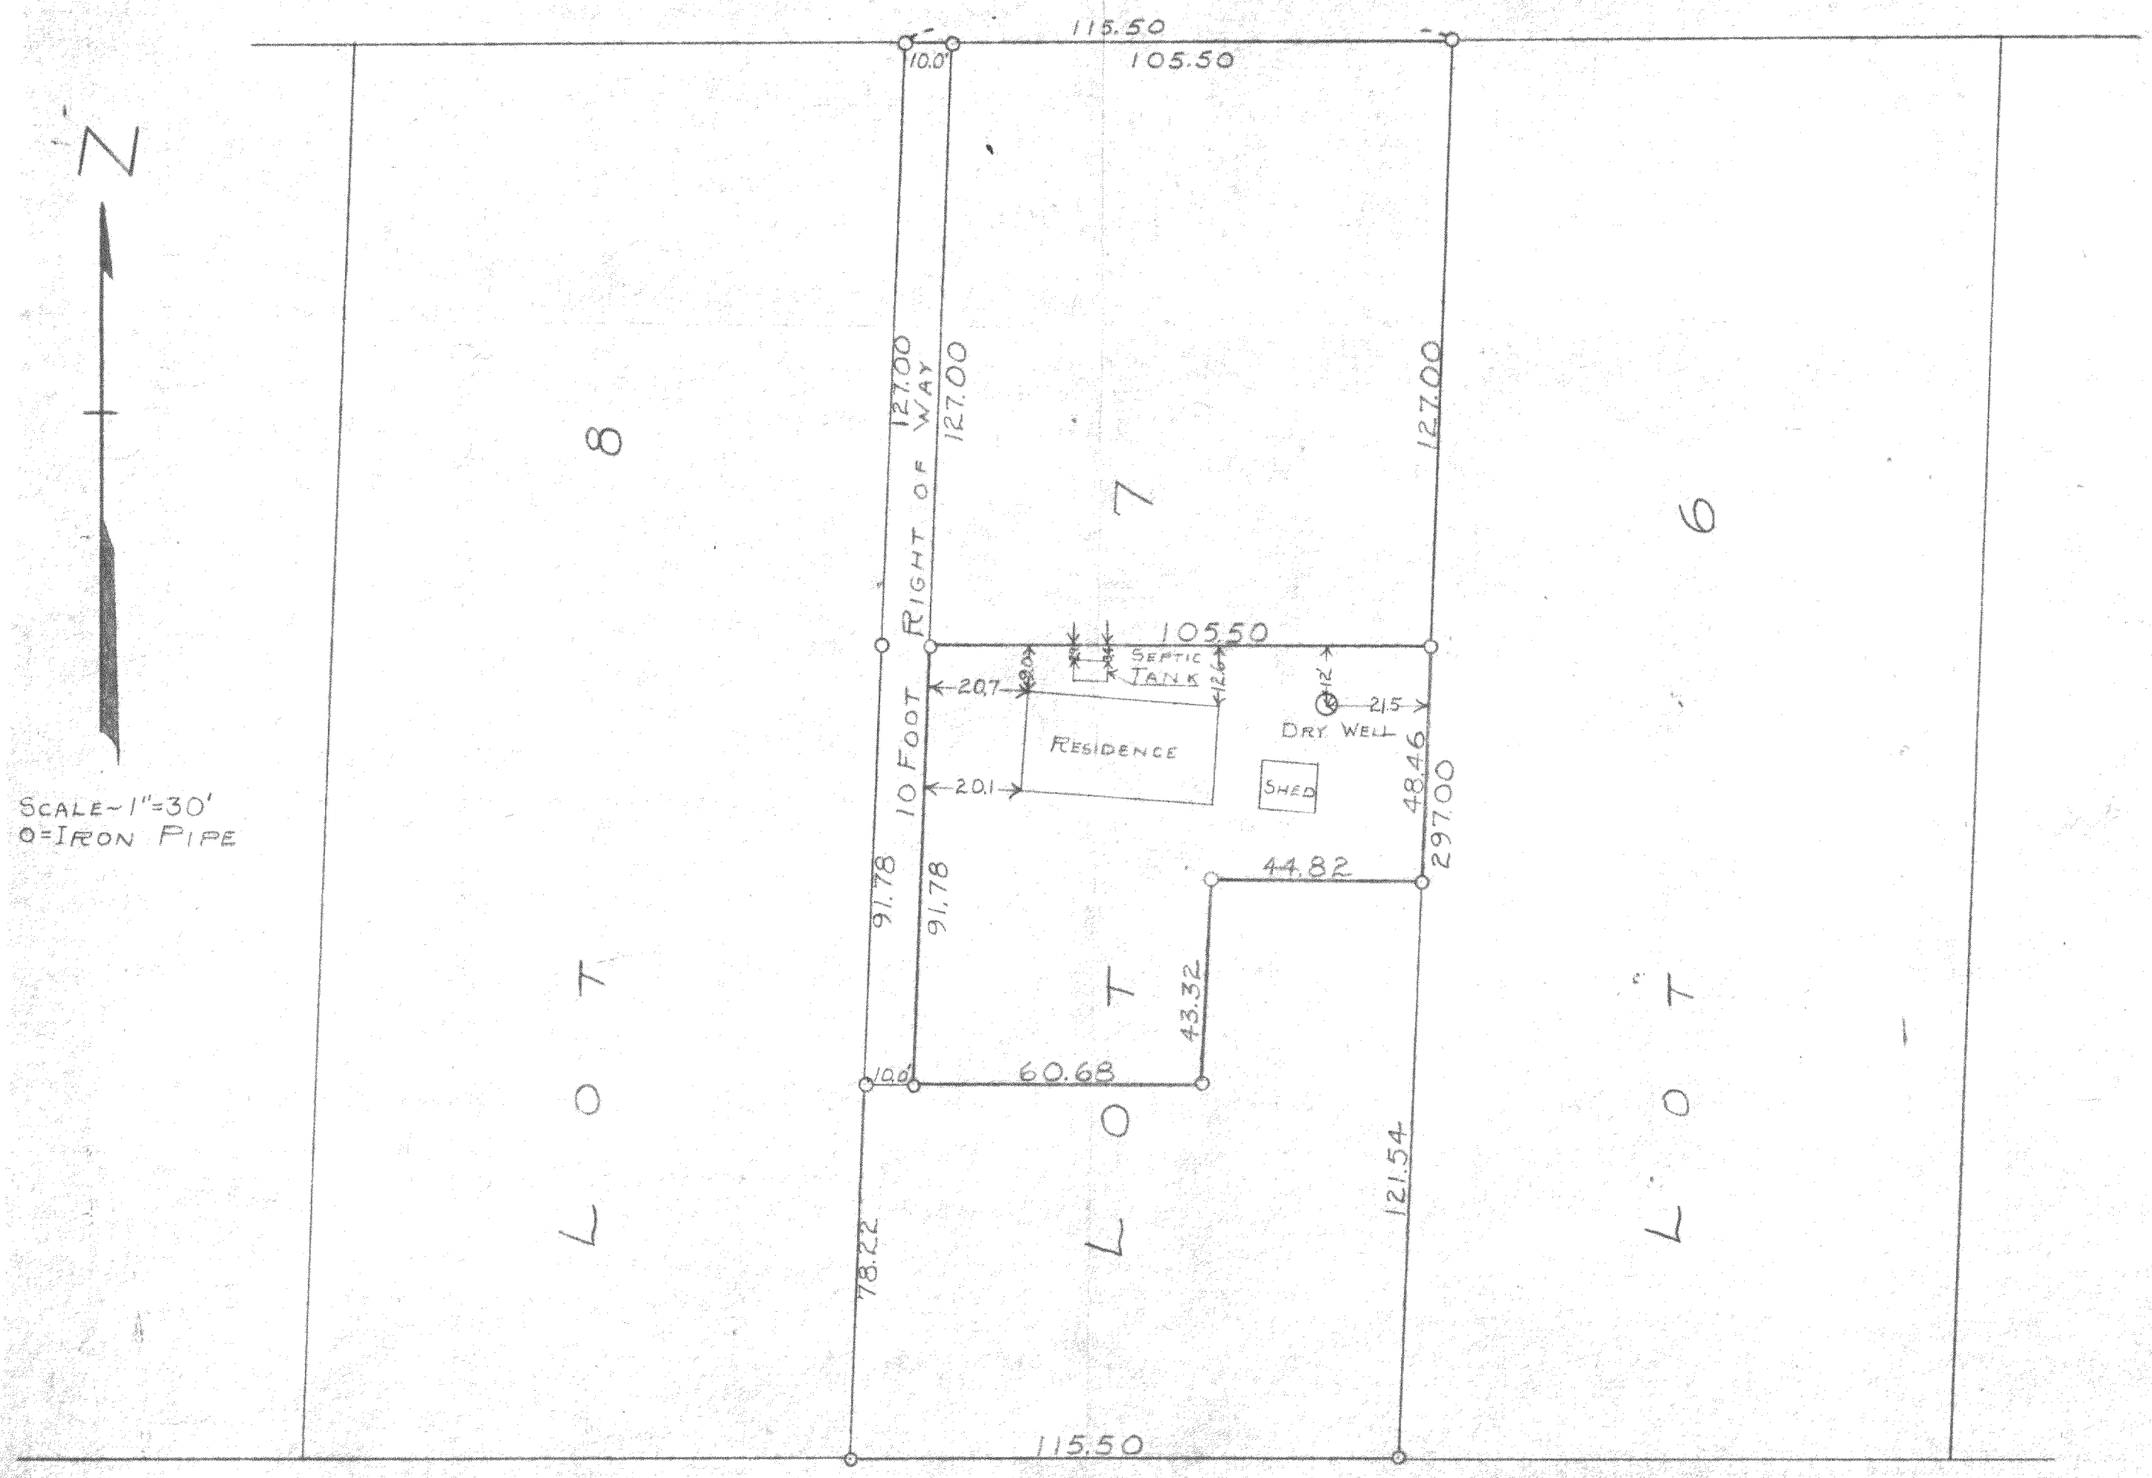

STATE OF WISCONSIN)
COUNTY OF WALWORTH) SS

I, GEORGE T. DUNHAM, DO HEREBY CERTIFY THAT I HAVE SURVEYED THE PROPERTY DESCRIBED AS FOLLOWS:

A PARCEL OF LAND LOCATED IN LOT 7, BLOCK 2 OF WISE AND NELSONS SOUTH SIDE ADDITION TO THE VILLAGE OF SHARON, WALWORTH COUNTY, WISCONSIN, DESCRIBED AS FOLLOWS, TO WIT; COMMENCING AT THE NORTHWEST CORNER OF SAID LOT 7; THENCE SOUTH ALONG THE WEST LINE OF LOT 7, 127.00 FEET; THENCE EAST PARALLEL TO THE NORTH LINE OF SAID LOT 7, 10.00 FEET TO THE PLACE OF BEGINNING, THENCE CONTINUE ALONG SAID LINE 105.50 FEET TO THE EAST LINE OF SAID LOT 7; THENCE SOUTH ALONG THE EAST LINE OF SAID LOT 7, 48.46 FEET; THENCE WEST PARALLEL TO THE NORTH LINE OF SAID LOT 7, 44.82 FEET, THENCE SOUTH PARALLEL TO THE EAST LINE OF SAID LOT 7, 43.32 FEET, THENCE WEST PARALLEL TO THE NORTH LINE OF SAID LOT 7, 60.68 FEET TO A POINT 10.00 FEET EAST OF THE WEST LINE OF SAID LOT 7; THENCE NORTH 91.78 FEET TO THE PLACE OF BEGINNING. ALSO A RIGHT OF WAY OVER THE WEST 10.00 FEET OF THE NORTH 218.78 FEET OF SAID LOT 7.

AND THAT THE PLAT SHOWN ABOVE IS A CORRECT REPRESENTATION OF THE PROPERTY LINES

SEPTEMBER 11, 1952

George T. Dunham
SURVEYOR

4 Wis SS-15

8-1