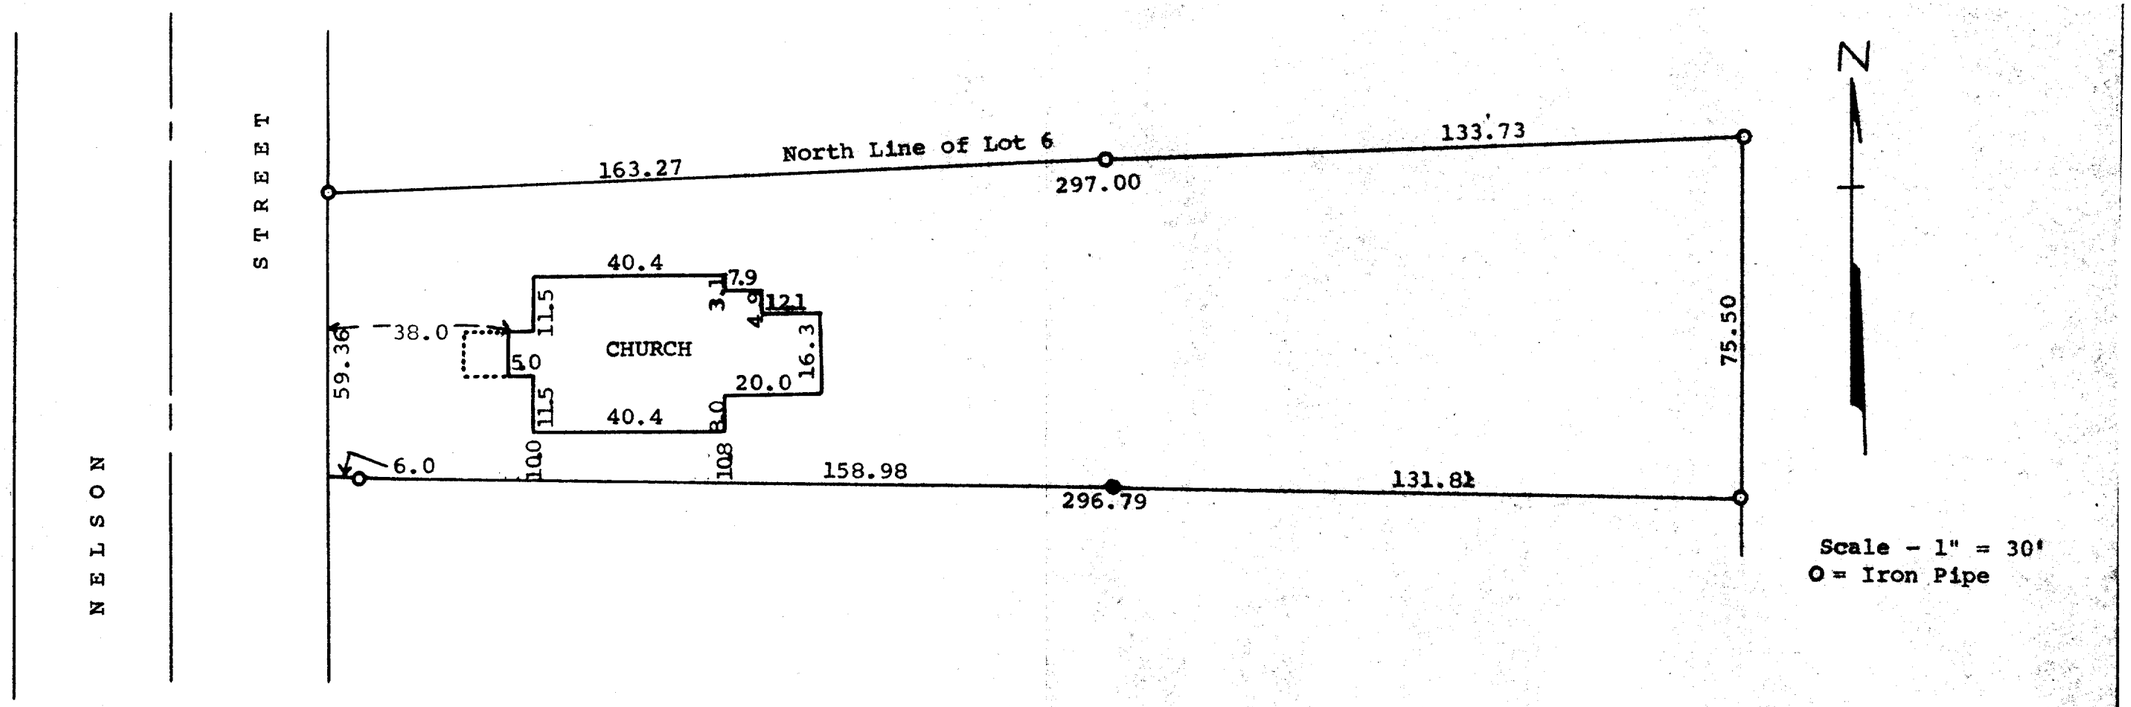

STATE OF WISCONSIN)
WALWORTH COUNTY) ss

I, George T. Dunham, do hereby certify that I have surveyed the property described as follows,

A part of Lot 6, Block 1, Wise and Nelson's Addition to the Village of Sharon, Walworth County, Wisconsin, described as follows, to-wit: Beginning at the northwest corner of said Lot 6; thence easterly along the north line of said Lot 6, 297.00 feet; thenee southerly along the east line of said Lot 6, 75.50 feet; thence westerly 296.79 feet to a point on the west line of said Lot 6 located 59.36 feet south of the place of beginning; thence northerly along the west line of said Lot 6, 59.36 feet to the place of beginning

and that the plat shown above is a correct representation of the property lines and of the improvements located thereon.

Sept. 18, 1962

George T. Dunham

George T. Dunham, Surveyor
Delavan, Wisconsin

8-10