
#47-69

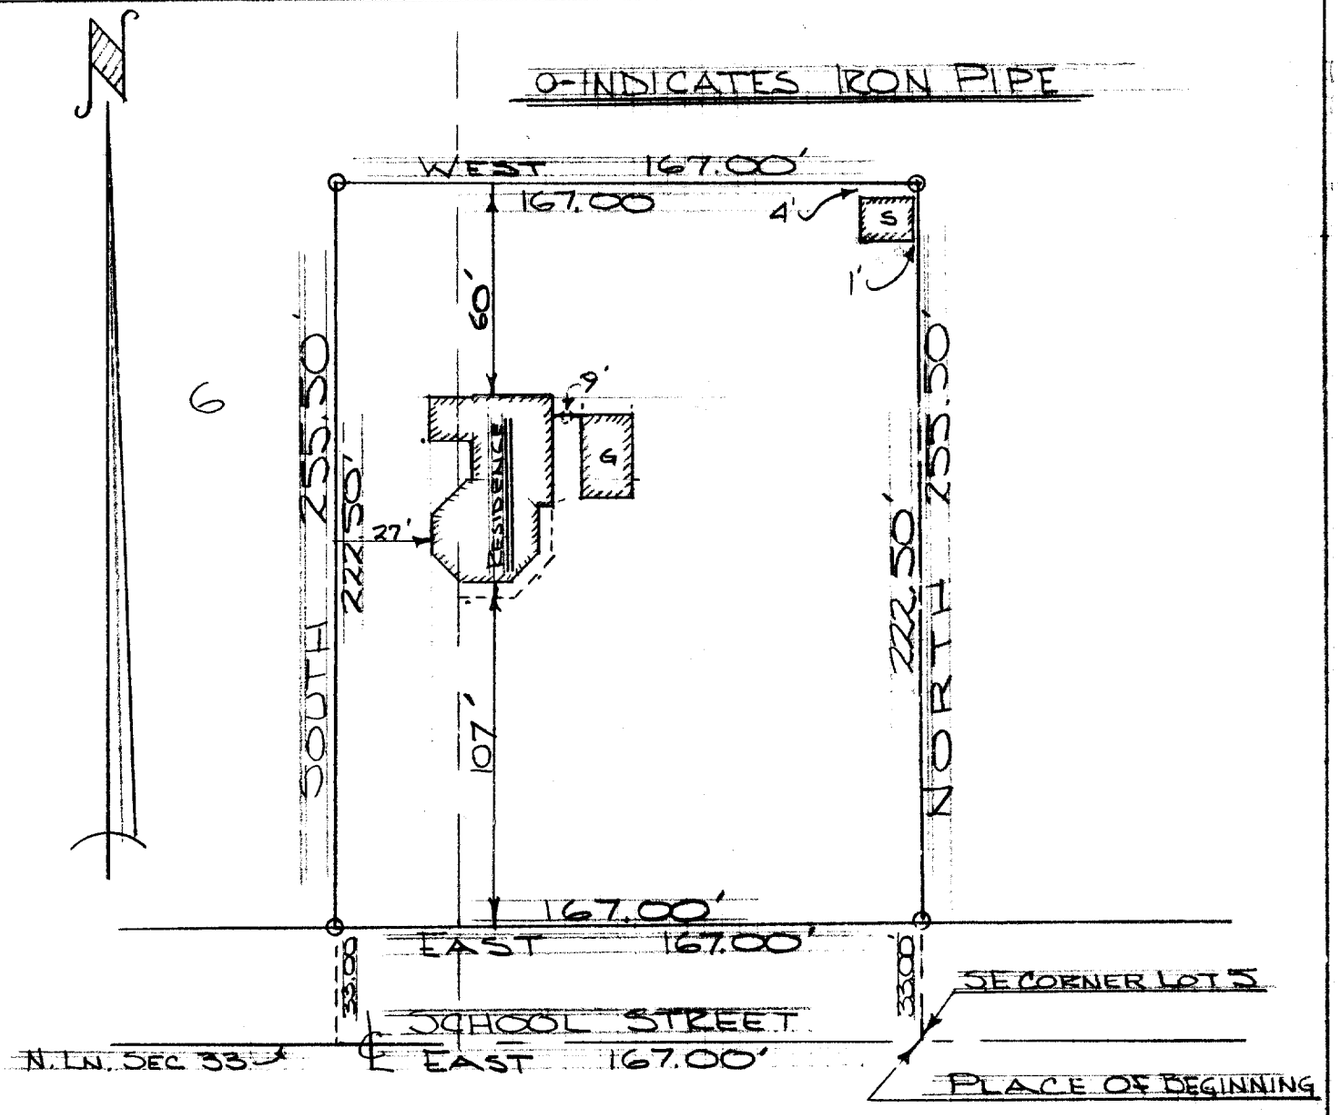

DESCRIPTION: Commencing at the SE corner of Lot 5 of Block 1 of Citizens Addition to the Village of Sharon, Walworth County, Wisconsin, thence North along the East line of Lot 5, 15 rods and 8 feet (255.50 feet), thence West 10 rods and 2 feet (167.00 feet), thence South 15 rods and 8 feet (255.50 feet), thence East 10 rods and 2 feet (167.00 feet) to the place of beginning.

CERTIFICATE: I, James F. Biagi, surveyor, do hereby certify that I have surveyed the property hereon described and that the location of the improvements are as shown.

April 23, 1969

James F. Biagi

James F. Biagi, RLS 272

WISCONSIN JAMES F. BIAGI 272 LAND SURVEYOR

UCA-12

8-10B