


RECEIVED
MAY 5 1986
W. S.

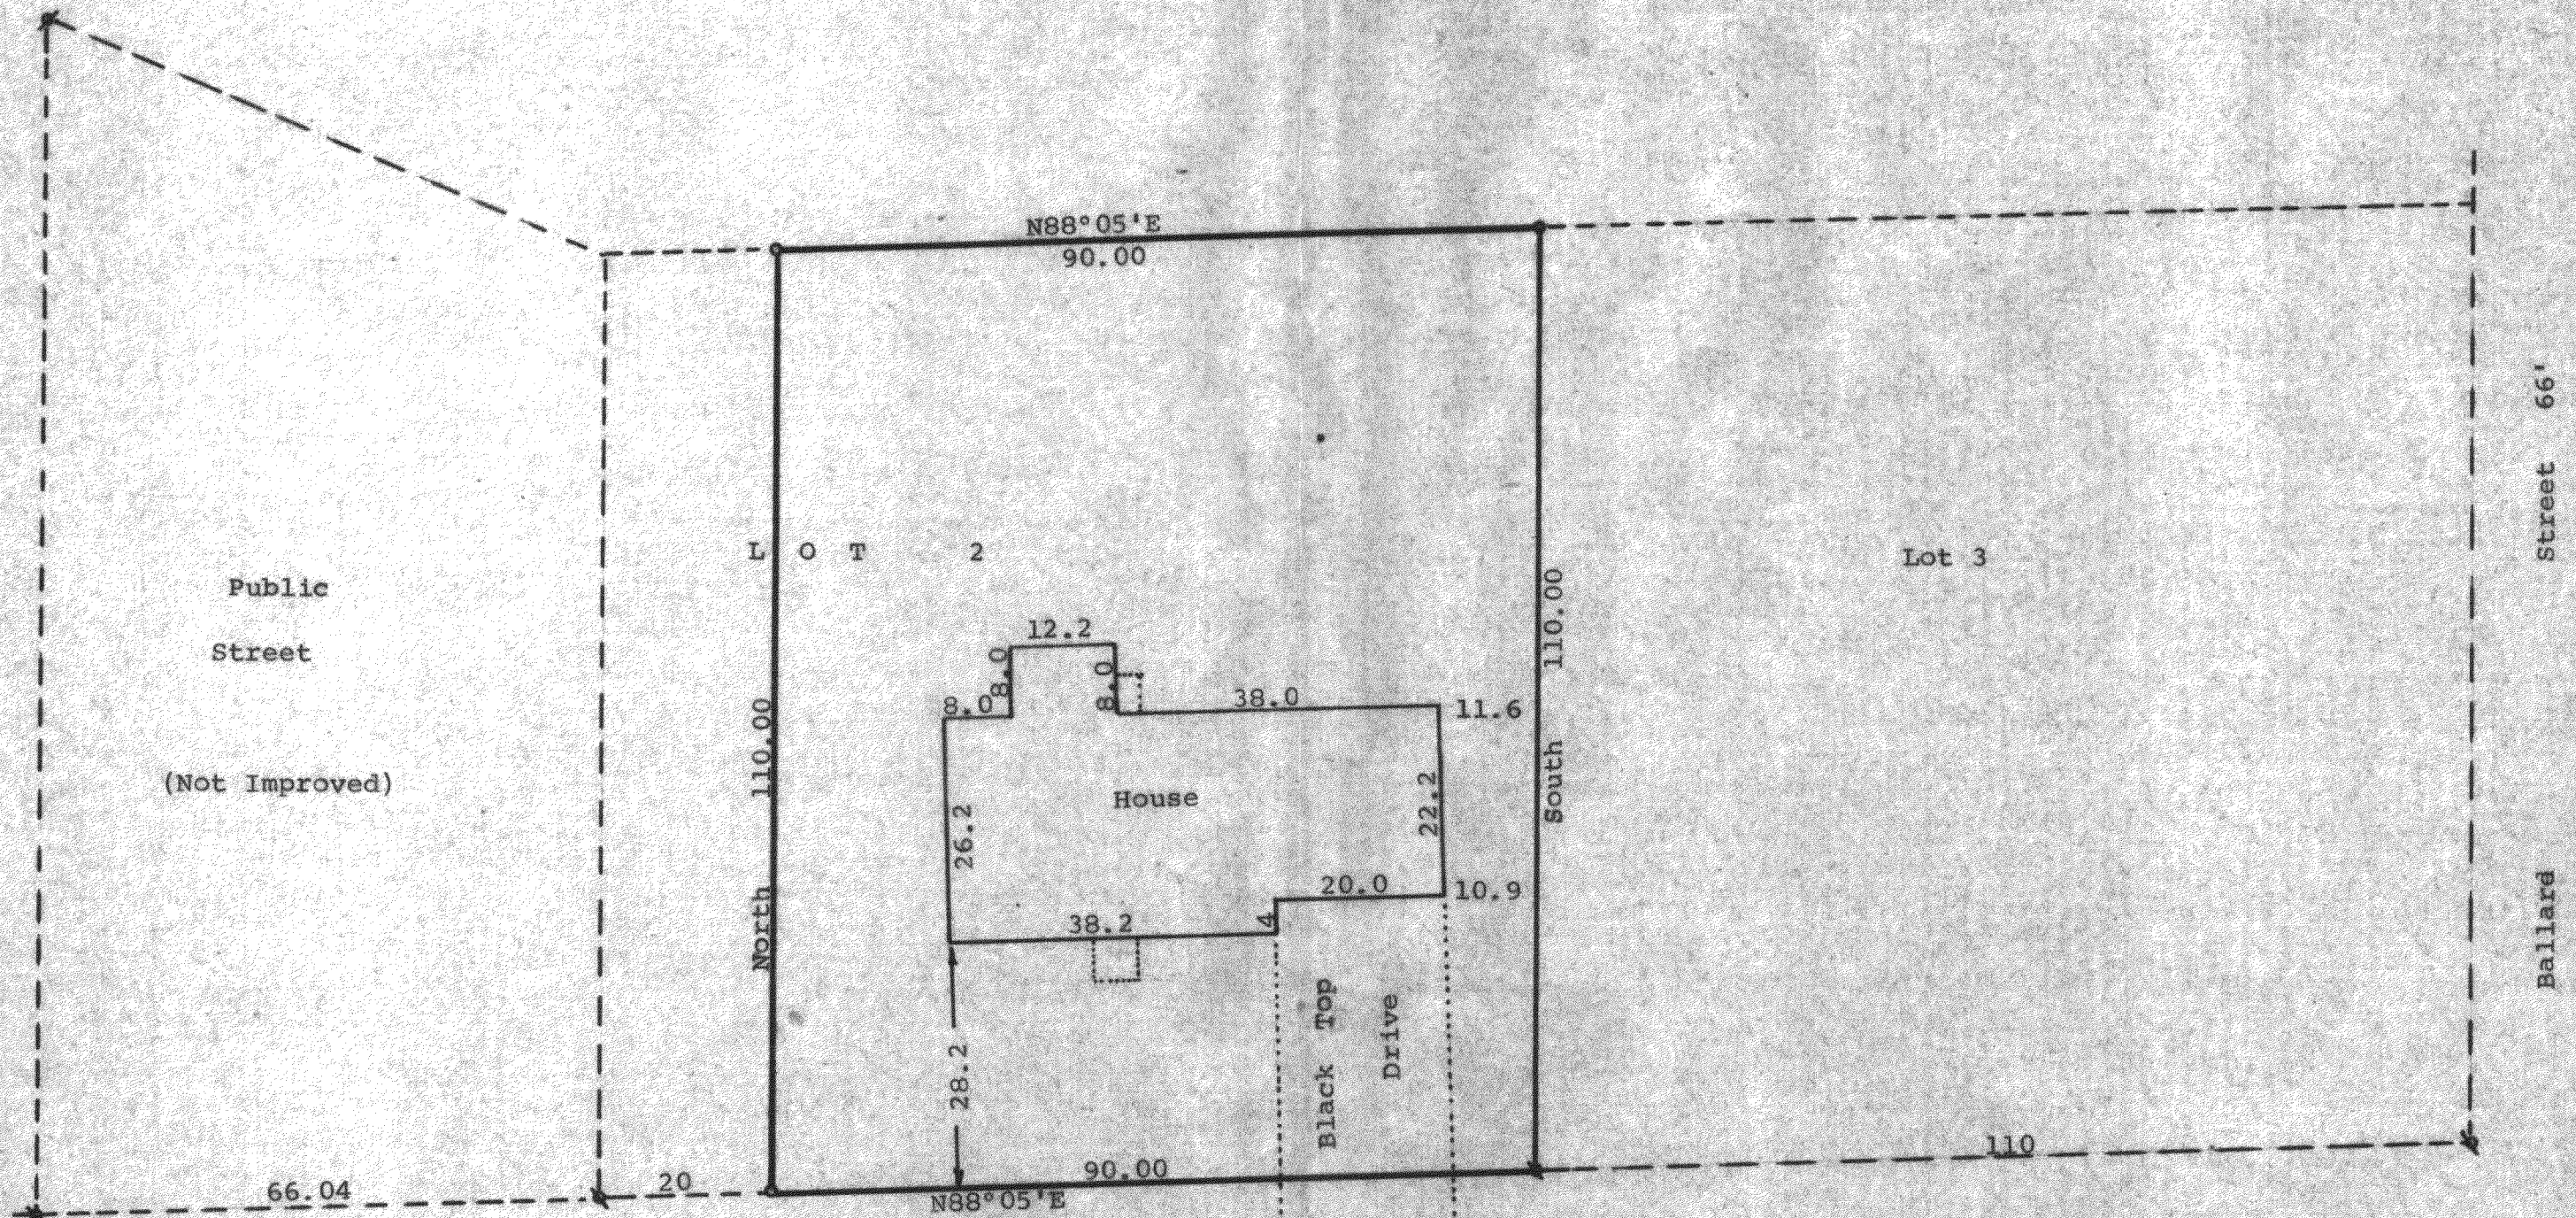

G E O R G E

S T R E E T

George T. Dunham
George T. Dunham, Surveyor

Sharon, WI 53585

