


DUNHAM SURVEYING, S.C.
SURVEYING & SUBDIVIDING
DELAVER, WISCONSIN 53115

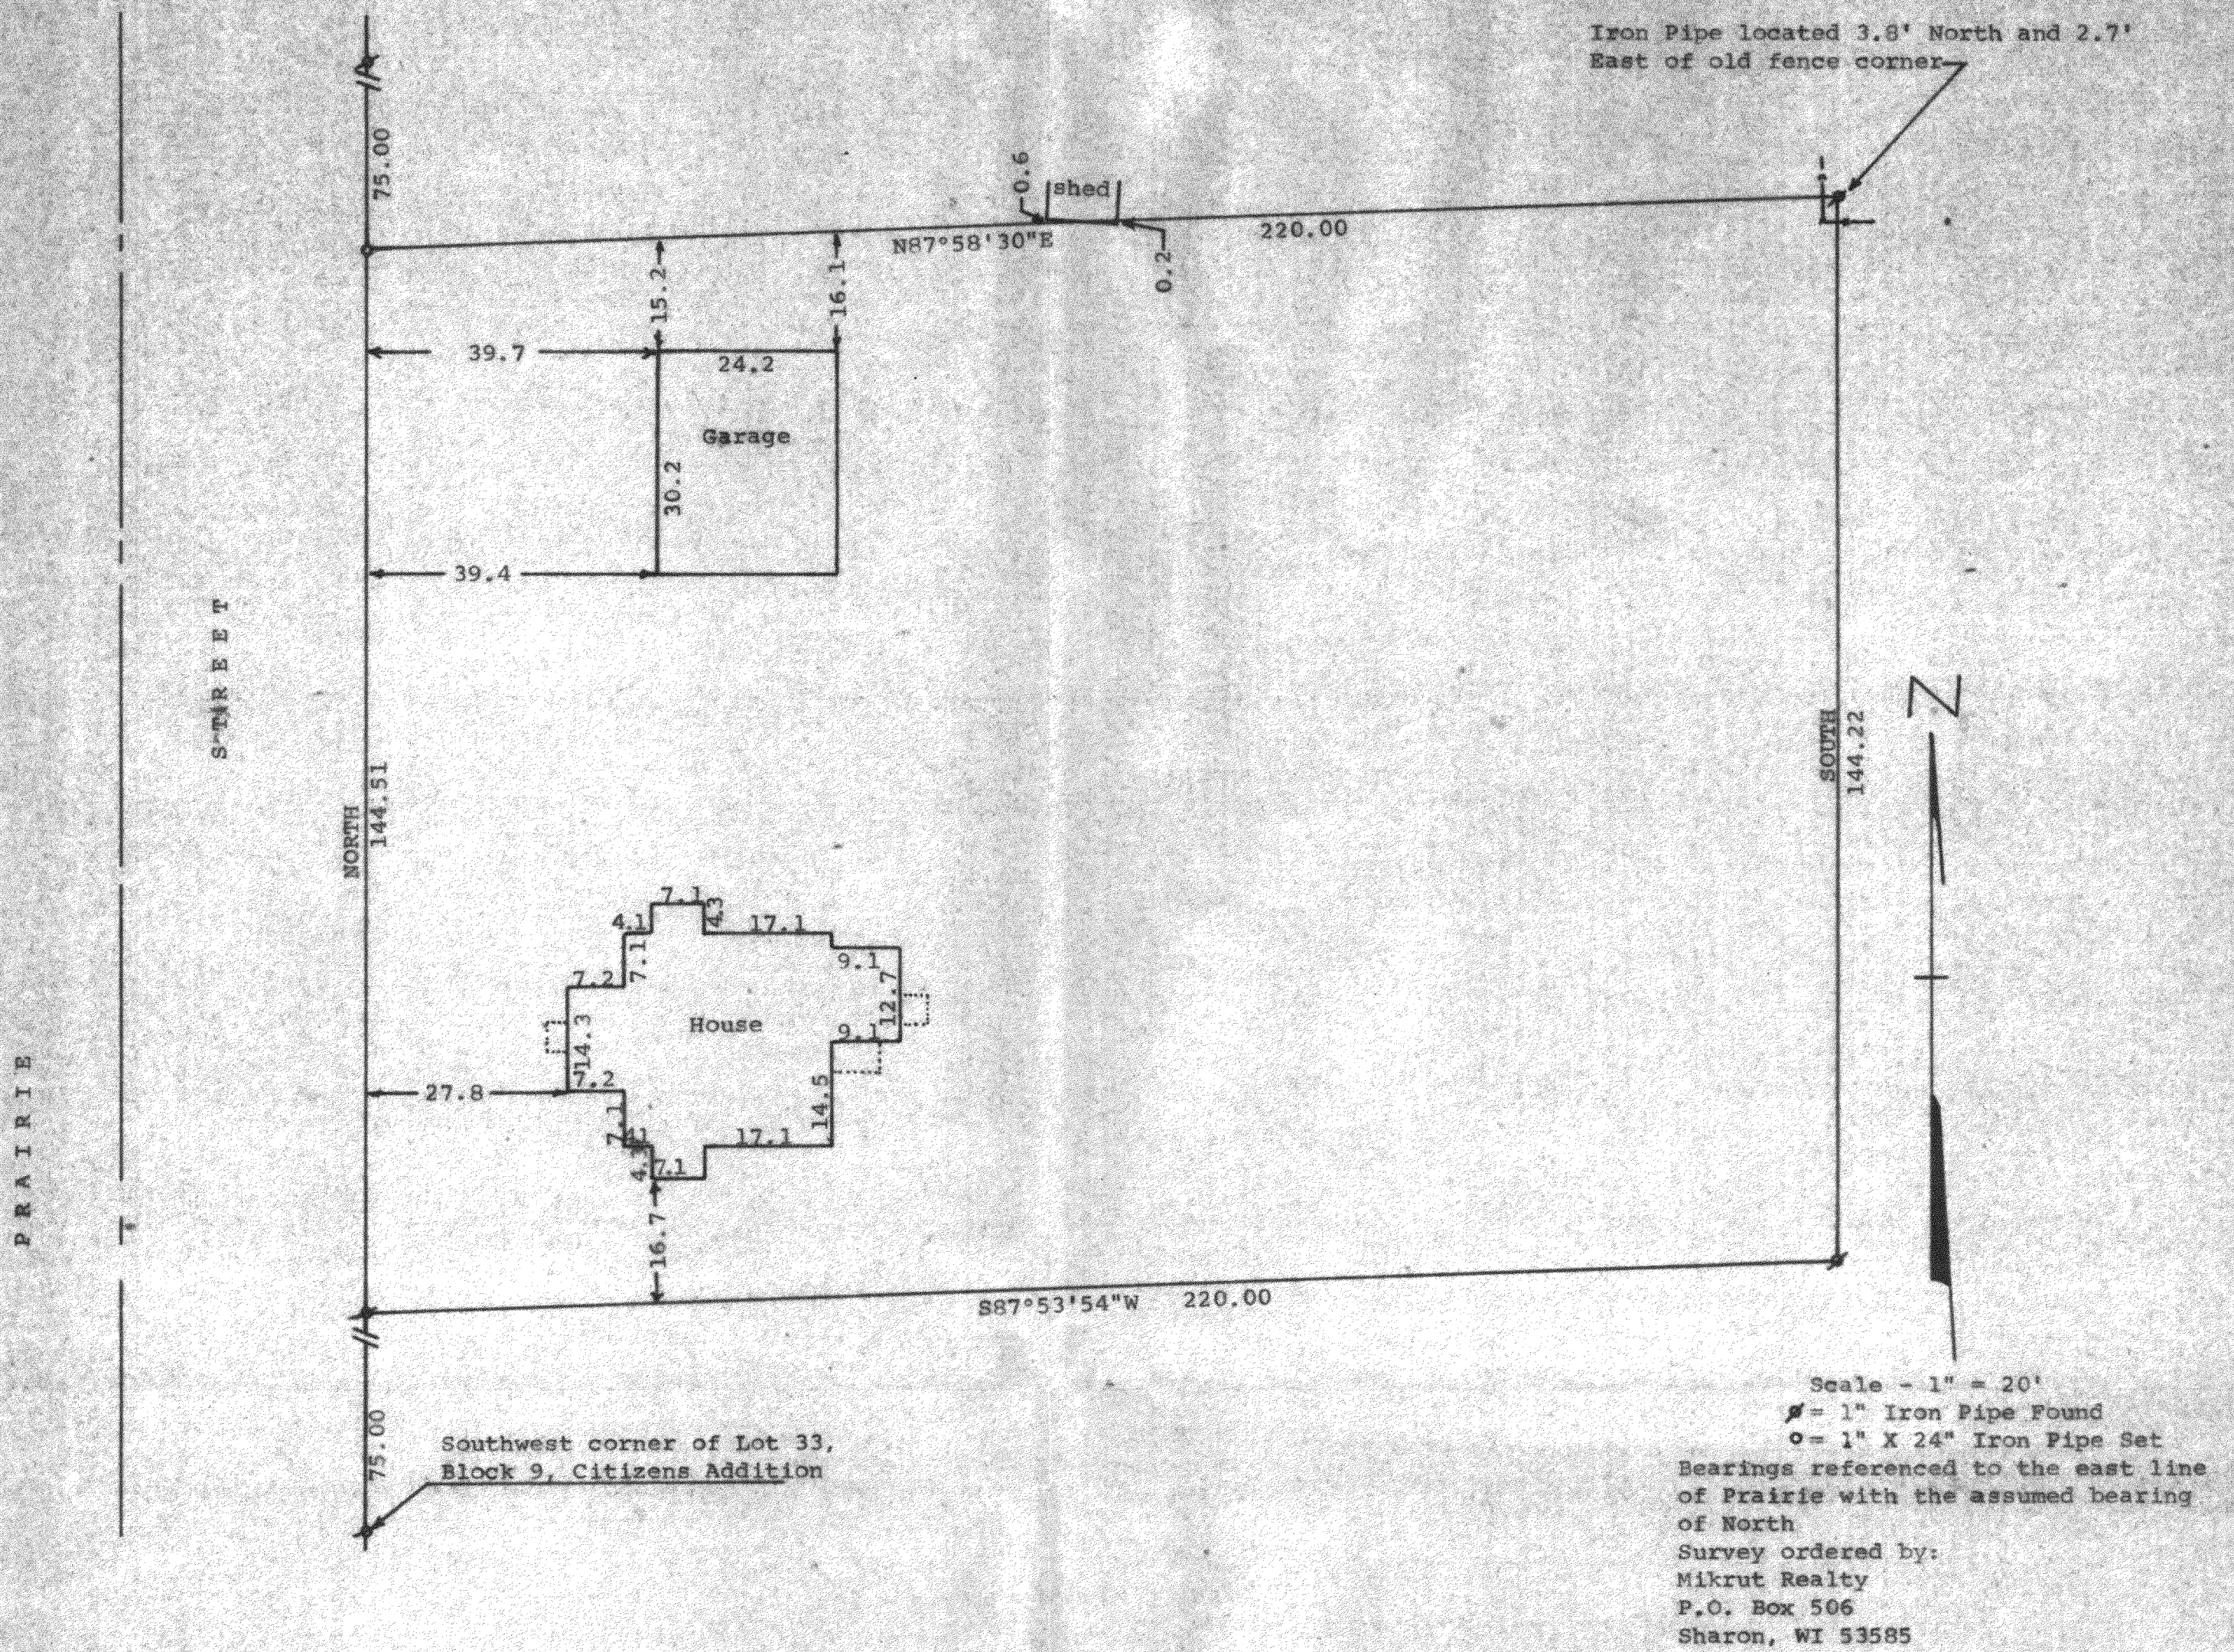


STATE OF WISCONSIN) SS
COUNTY OF WALWORTH)

I, George T. Dunham, Surveyor, certify that I have surveyed the property described as follows:

A part of Lot 33, Block 9, Citizens Addition to the Village of Sharon, Walworth County, Wisconsin described as follows: Beginning at a point 75.00 feet North of the southwest corner of said Lot 33; thence North along the west line of said Lot 33, 144.51 feet; thence N87°58'30"E parallel with the north line of said Lot 33, 220.00 feet; thence South 144.22 feet; thence S87°53'54"W parallel with the south line of said Lot 33, 220.00 feet to the place of beginning.

and that the map shown above is a correct representation thereof and shows the size and location of the property, its exterior boundaries, the location of all visible structures and dimensions of all principal buildings thereon, boundary fences, apparent easements, roadways and visible encroachments, if any, and that I have surveyed the property hereon described according to the official records, to the best of my knowledge and belief.

January 7, 1988

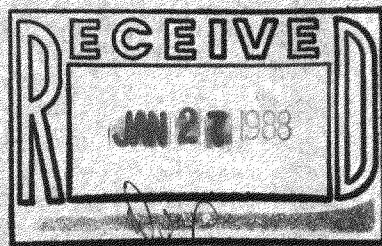

George T. Dunham
George T. Dunham, Surveyor

