


DUNHAM SURVEYING, S.C.

SURVEYING & SUBDIVIDING
DELAVER, WISCONSIN 53115

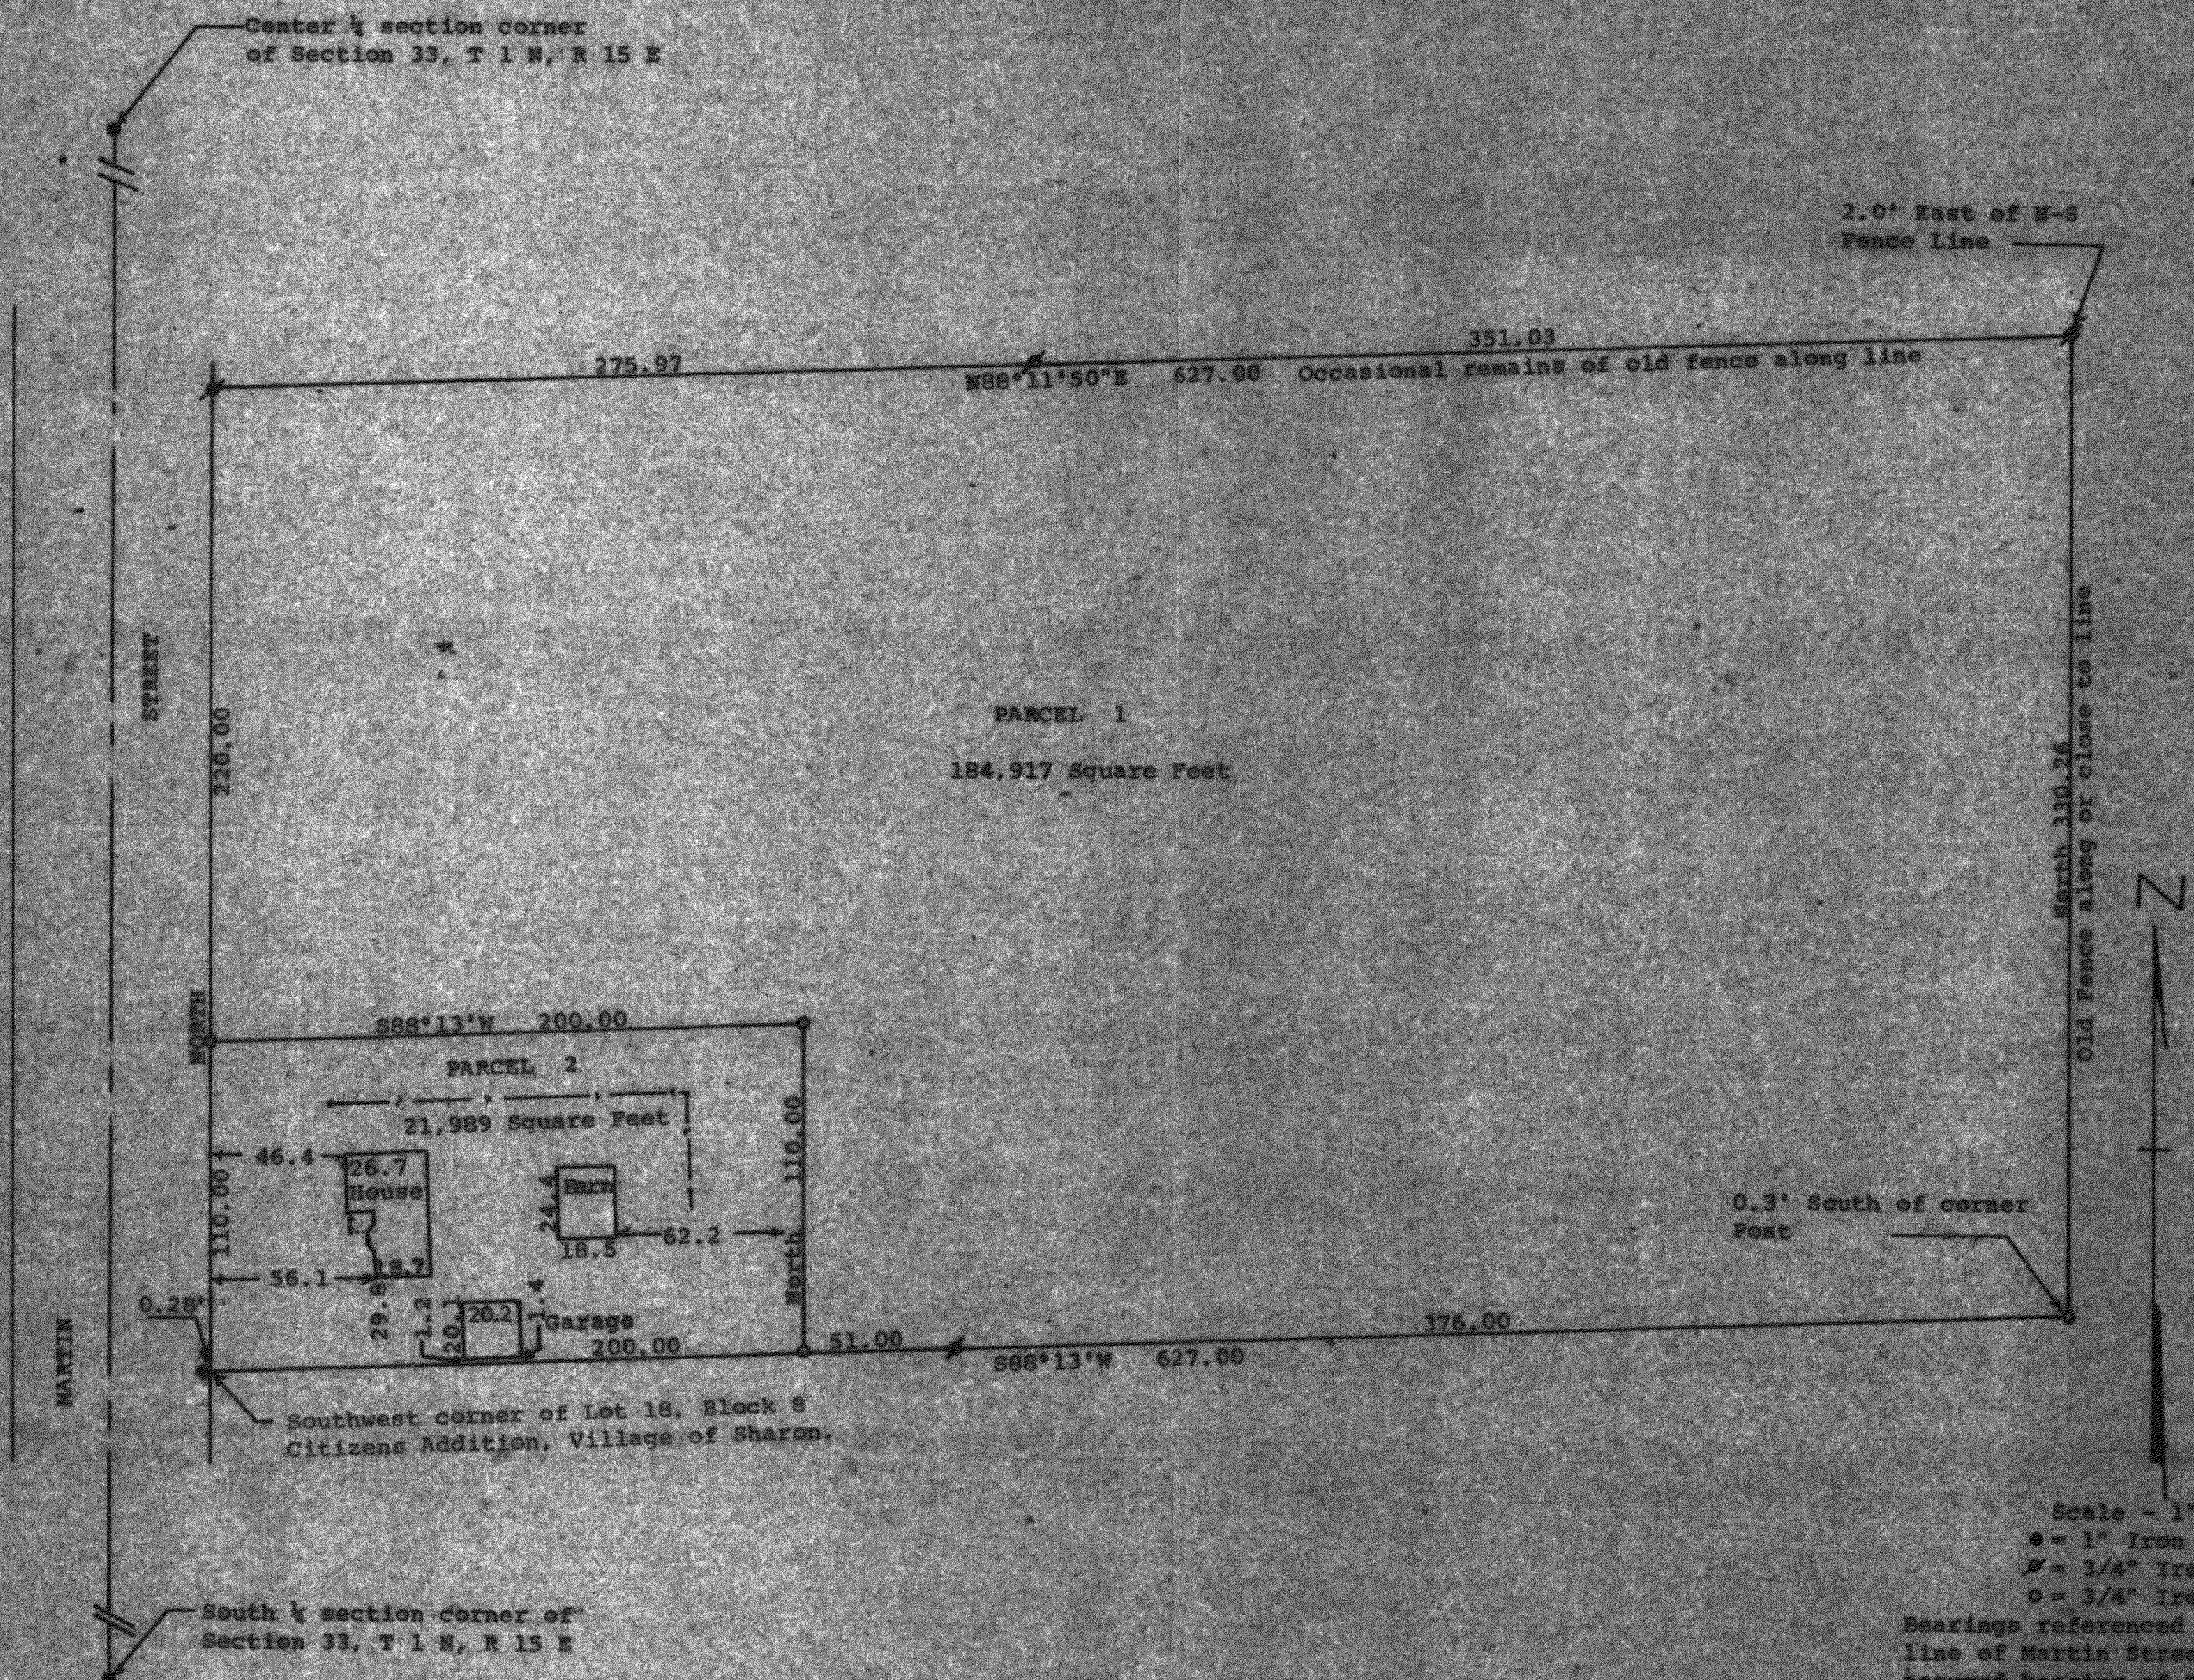

STATE OF WISCONSIN)
COUNTY OF WALWORTH)


I, George T. Dunham, Surveyor, certify that I have surveyed the property described as follows:

Parcel 1: A parcel of land located in Lot 18, Block 8, Citizens Addition, Village of Sharon, Walworth County, Wisconsin, described as follows: Commencing at the southwest corner of said Lot 18; thence North along the west line of said Lot 18, 110.00 feet to the place of beginning; thence continue North along said west line 220.00 feet; thence N88°11'50"E along the north line of said Lot 18, 627.00 feet to the northeast corner of said Lot 18; thence South along the east line of said Lot 18, 130.26 feet to the southeast corner of said Lot 18; thence S88°13'W along the south line of said Lot 18, 427.00 feet to a point located 200.00 feet east of the southwest corner of said Lot 18; thence North 110.00 feet; thence S88°13'W 200.00 feet to the place of beginning containing 184,917 square feet of land.

Parcel 2: A parcel of land located in Lot 18, Block 8, Citizens Addition, Village of Sharon, Walworth County, Wisconsin, described as follows: Beginning at the southwest corner of said Lot 18; thence North along the west line of said Lot 18, 110.00 feet; thence N88°13'E parallel with the south line of said Lot 18, 200.00 feet; thence South 110.00 feet to the south line of said Lot 18; thence S88°13'W along said south line 200.00 feet to the place of beginning containing 21,989 Square feet of land.

and that the plat shown hereon is a correct representation thereof and shows the size and location of the property, its exterior boundaries, the location of all visible structures and dimensions of all principal buildings thereon, apparent easements, roadways and visible encroachments, if any, and that I have surveyed the property hereon described, according to the official records, to the best of my knowledge and belief.

September 8, 1988

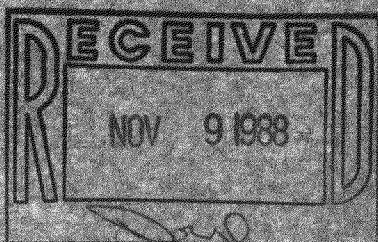

George T. Dunham
George T. Dunham, Surveyor



UCA-134,134A

8-14/2