
DUNHAM SURVEYING, S. C.

SURVEYING & SUBDIVIDING
DELAVAN, WISCONSIN 53115



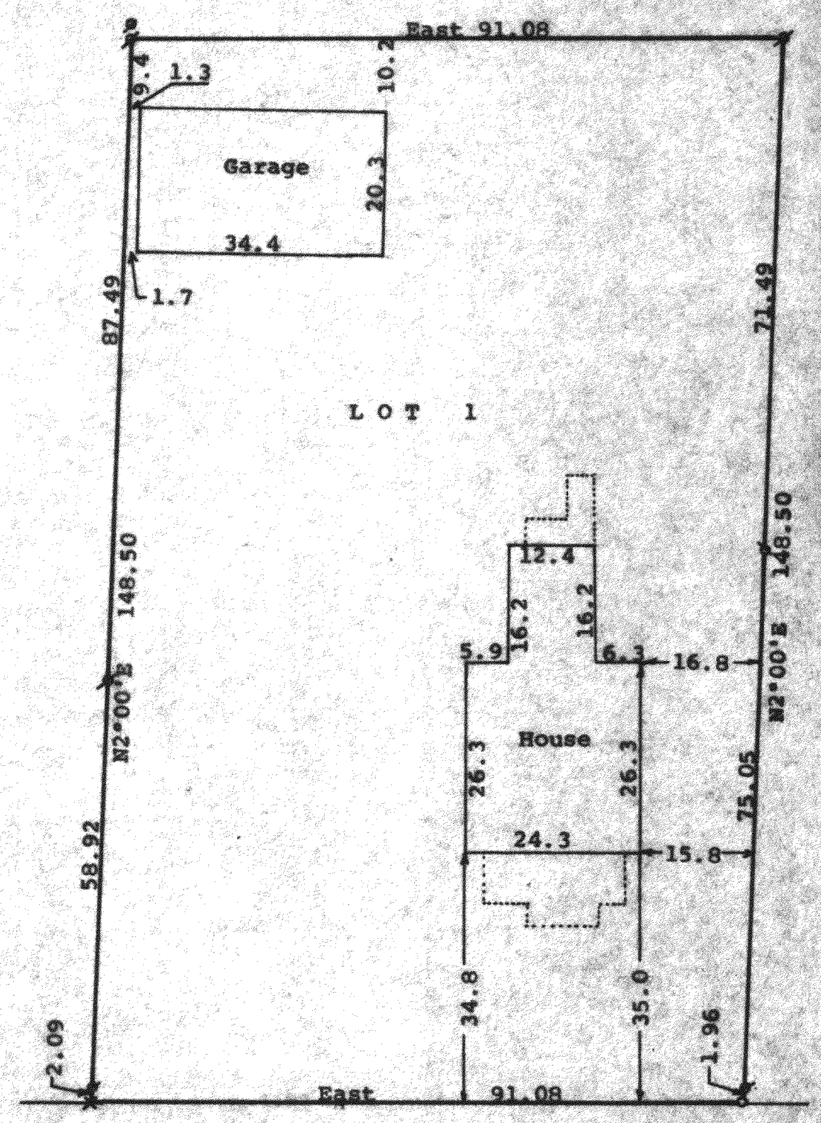

Scale - 1" = 20'
X = cross in concrete found
ø = 1" Iron Pipe Found
o = ½" X 24" Iron Pipe Set
Bearings referenced to the assumed bearing of East along the north line of Grace Street
Survey ordered by: Mikrut Realty
199 Baldwin Street
Sharon, WI 53585
b = ½" Iron Pipe Found

STATE OF WISCONSIN)
SS
COUNTY OF WALWORTH)

I, George T. Dunham, Surveyor, certify that I have surveyed the property described as follows:

Lot 1, Block 1 of Sharon Land and Improvement Company's Addition to the Village of Sharon, Walworth County, Wisconsin,

and that the plat shown hereon is a correct representation thereof and shows the size and location of the property, its exterior boundaries, the location of all visible structures and dimensions of all principal buildings thereon, boundary fences, apparent easements, roadways and visible encroachments, if any, and that I have surveyed the property hereon described, according to the official records, to the best of my knowledge and belief.

October 10, 1989

George T. Dunham, Surveyor

RECEIVED
AUG 16 1990

WISCONSIN
GEORGE T. DUNHAM
S-306
DELAVAN WIS.
LAND SURVEYOR

TAX KEY # USLI 00001

SURVEY # 008-161

QMB 1020