


DUNHAM SURVEYING, S.C.
SURVEYING & SUBDIVIDING
DELAVER, WISCONSIN 53115

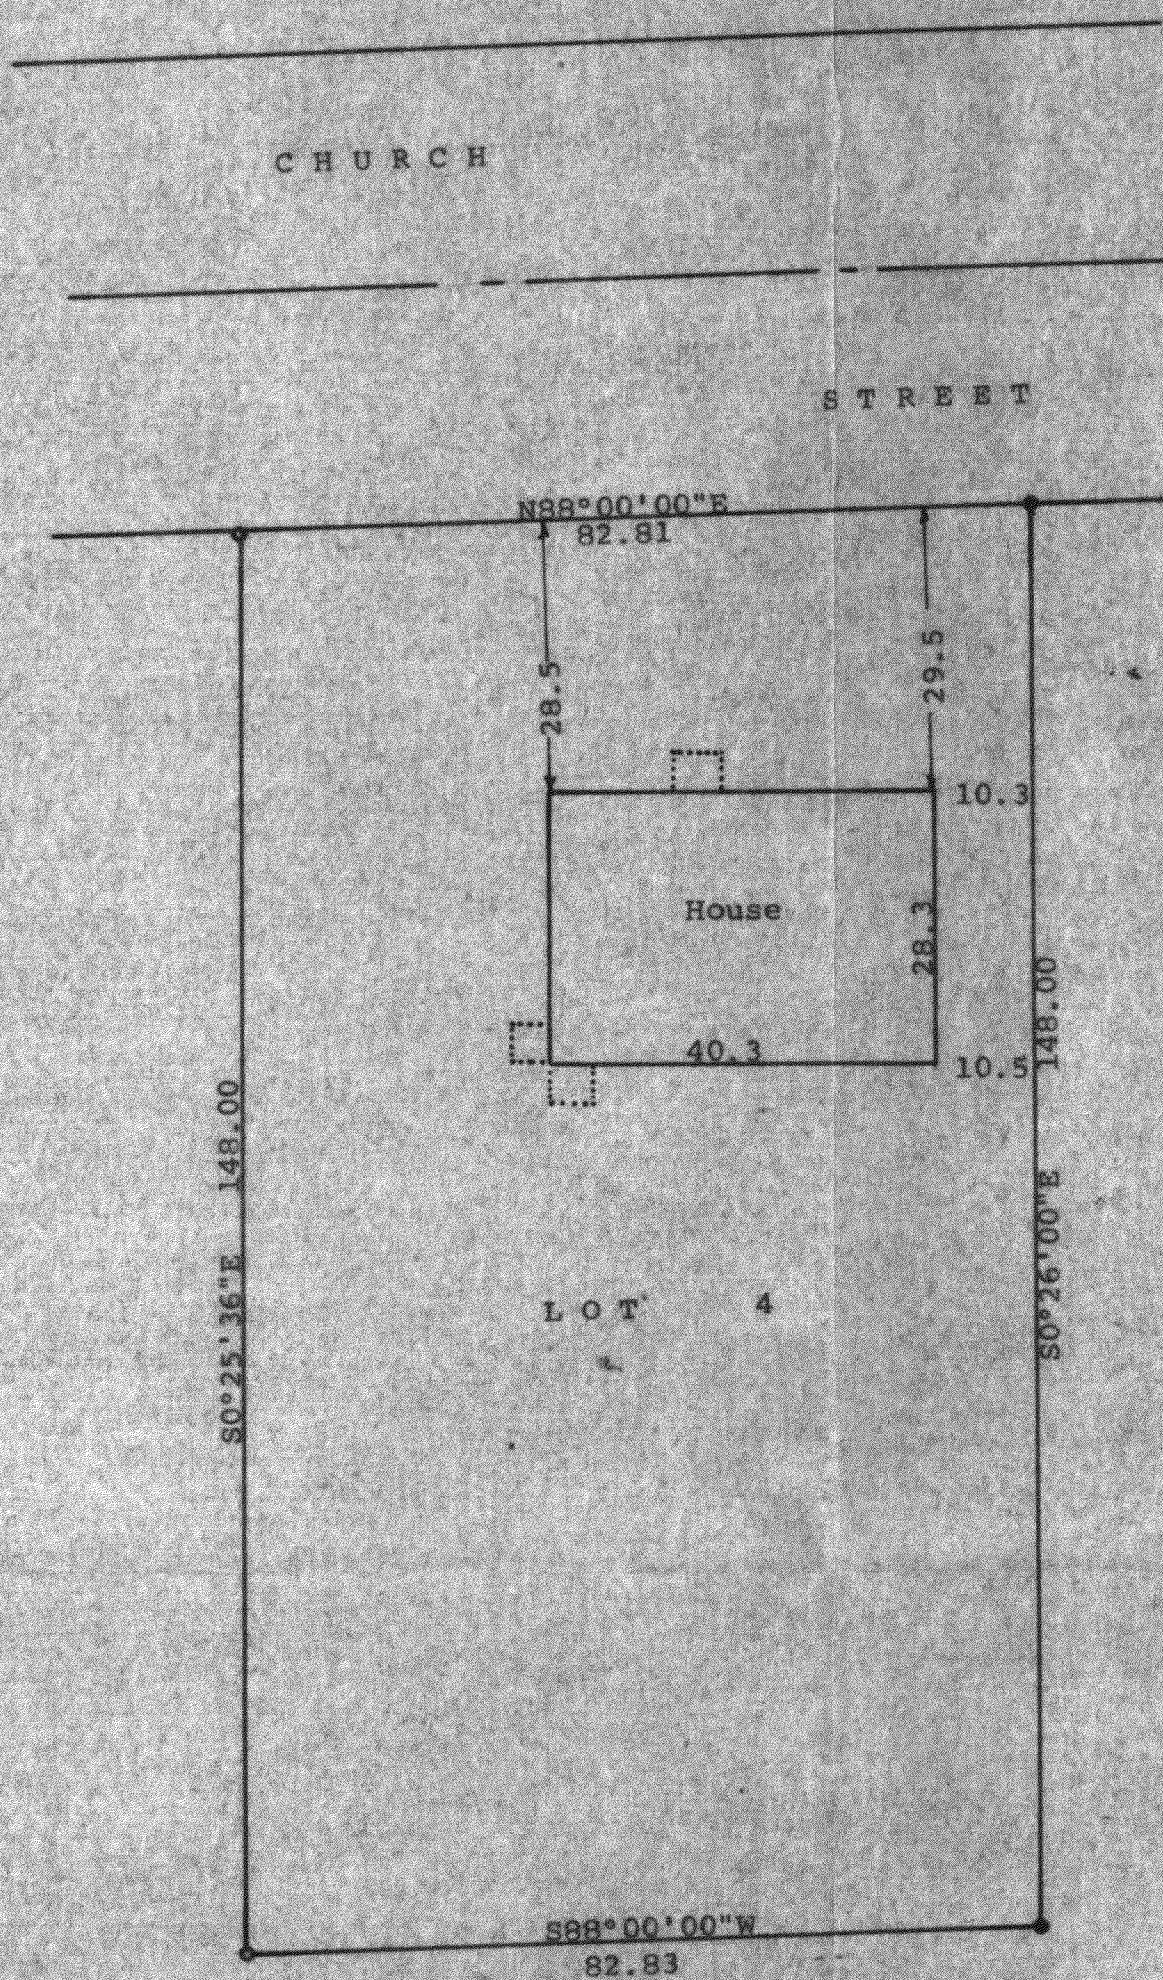

N

Scale - 1" = 20'
● = 2" Iron Pipe Found
○ = 1" Iron Pipe Found
Bearings used are those on the recorded plat of
Certified Survey Map No. 980
Survey ordered by: Dari State Realty
Six Corners Road
Walworth, WI 53184

STATE OF WISCONSIN) SS
COUNTY OF WALWORTH)

I, George T. Dunham, Surveyor, certify that I have surveyed the property described as follows:

Lot 4 of Certified Survey Map No. 980, recorded in Volume 4 of Certified Surveys on Page 245, on November 15, 1979, Document No. 53506 in the Office of the Register of Deeds, Elkhorn, Wisconsin, being a parcel of land located in Block 7 of the Citizens Addition to the Village of Sharon, Walworth County, Wisconsin.

and that the plat shown hereon is a correct representation thereof and shows the size and location of the property, its exterior boundaries, the location of all visible structures and dimensions of all principal buildings thereon, boundary fences, apparent easements, roadways and visible encroachments, if any, and that I have surveyed the property hereon described, according to the official records, to the best of my knowledge and belief.

February 6, 1991

George T. Dunham
George T. Dunham, Surveyor

