ABELL
SURVEYING & MAPPING

DELAVAN, WISCONSIN 53115
414-728-6737

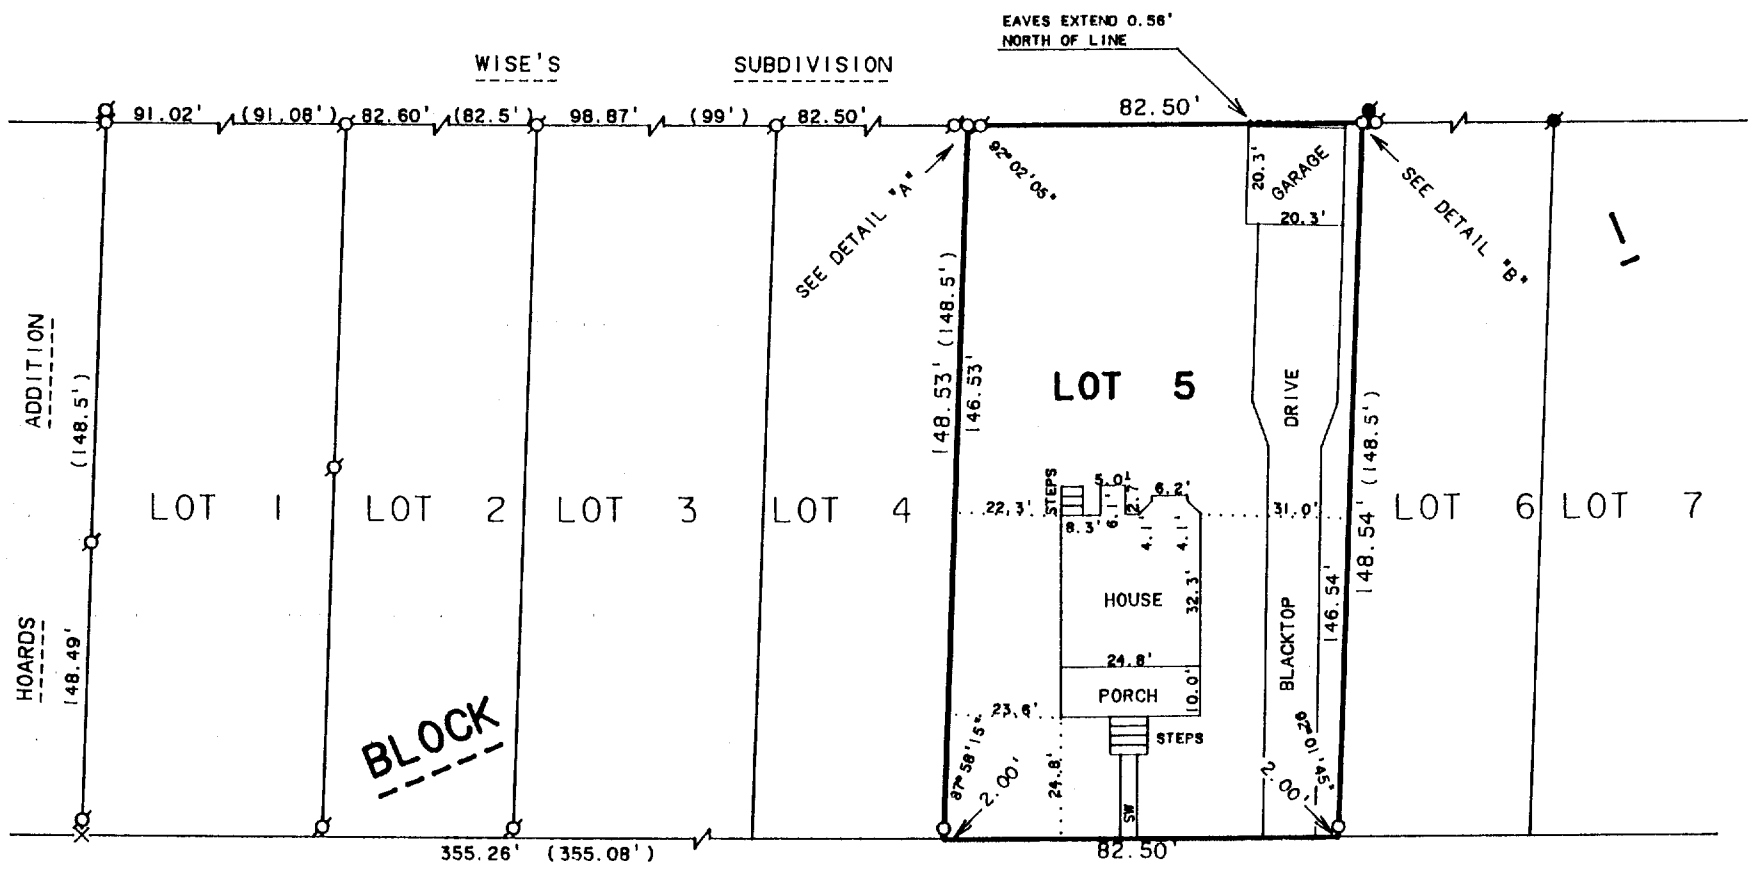

GRACE STREET

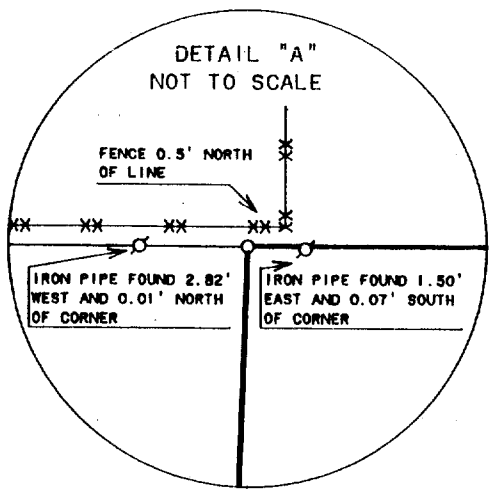

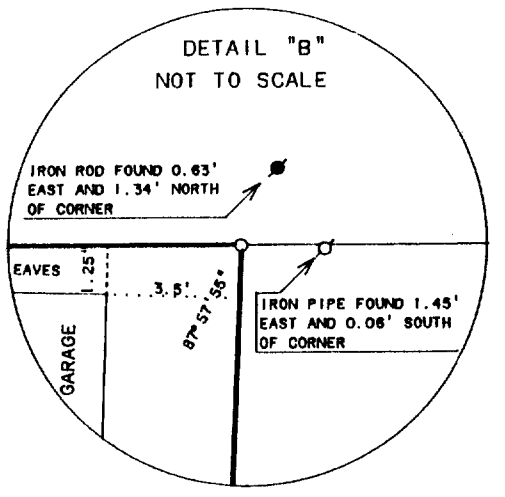

PLAT OF SURVEY OF

LOT 5, BLOCK 1, SHARON LAND AND IMPROVEMENT COMPANY ADDITION TO THE VILLAGE OF SHARON, WALWORTH COUNTY, WISCONSIN.

N

SCALE 1"=40'

LEGEND

- Ø - IRON PIPE FOUND
- ø - IRON ROD FOUND
- X - CUT CROSS IN CONCRETE FOUND
- O - IRON PIPE SET
- XX——XX - WOOD FENCE
- SW - SIDEWALK
- ( ) - RECORDED AS

ORDERED BY: KEEFE REAL ESTATE
704 MAIN STREET
LAKE GENEVA, WI. 53147

RECEIVED
NOV 1 9 1991

I HEREBY CERTIFY THAT I HAVE SURVEYED THE ABOVE DESCRIBED PROPERTY AND THAT THE ABOVE MAP IS A TRUE REPRESENTATION THEREOF AND SHOWS THE SIZE AND LOCATION OF THE PROPERTY, ITS EXTERIOR BOUNDARIES, THE LOCATION OF ALL VISIBLE STRUCTURES AND DIMENSIONS OF ALL PRINCIPAL BUILDINGS THEREON, BOUNDARY FENCES, APPARENT EASEMENTS, ROADWAYS AND VISIBLE ENCROACHMENTS, IF ANY, TO THE BEST OF MY KNOWLEDGE AND BELIEF.

THIS SURVEY IS MADE FOR THE USE OF THE PRESENT OWNERS OF THE PROPERTY, AND ALSO THOSE WHO PURCHASE, MORTGAGE, OR GUARANTEE THE TITLE THERETO WITHIN ONE (1) YEAR FROM DATE HEREOF.

David F. Abell

DAVID F. ABELL
WISCONSIN REGISTERED LAND SURVEYOR, S-1596

June 3, 1991

DATE JOB NUMBER - 91105

NOTE: THIS IS NOT A CERTIFIED COPY UNLESS SEALED.

008-187

USLI-5