


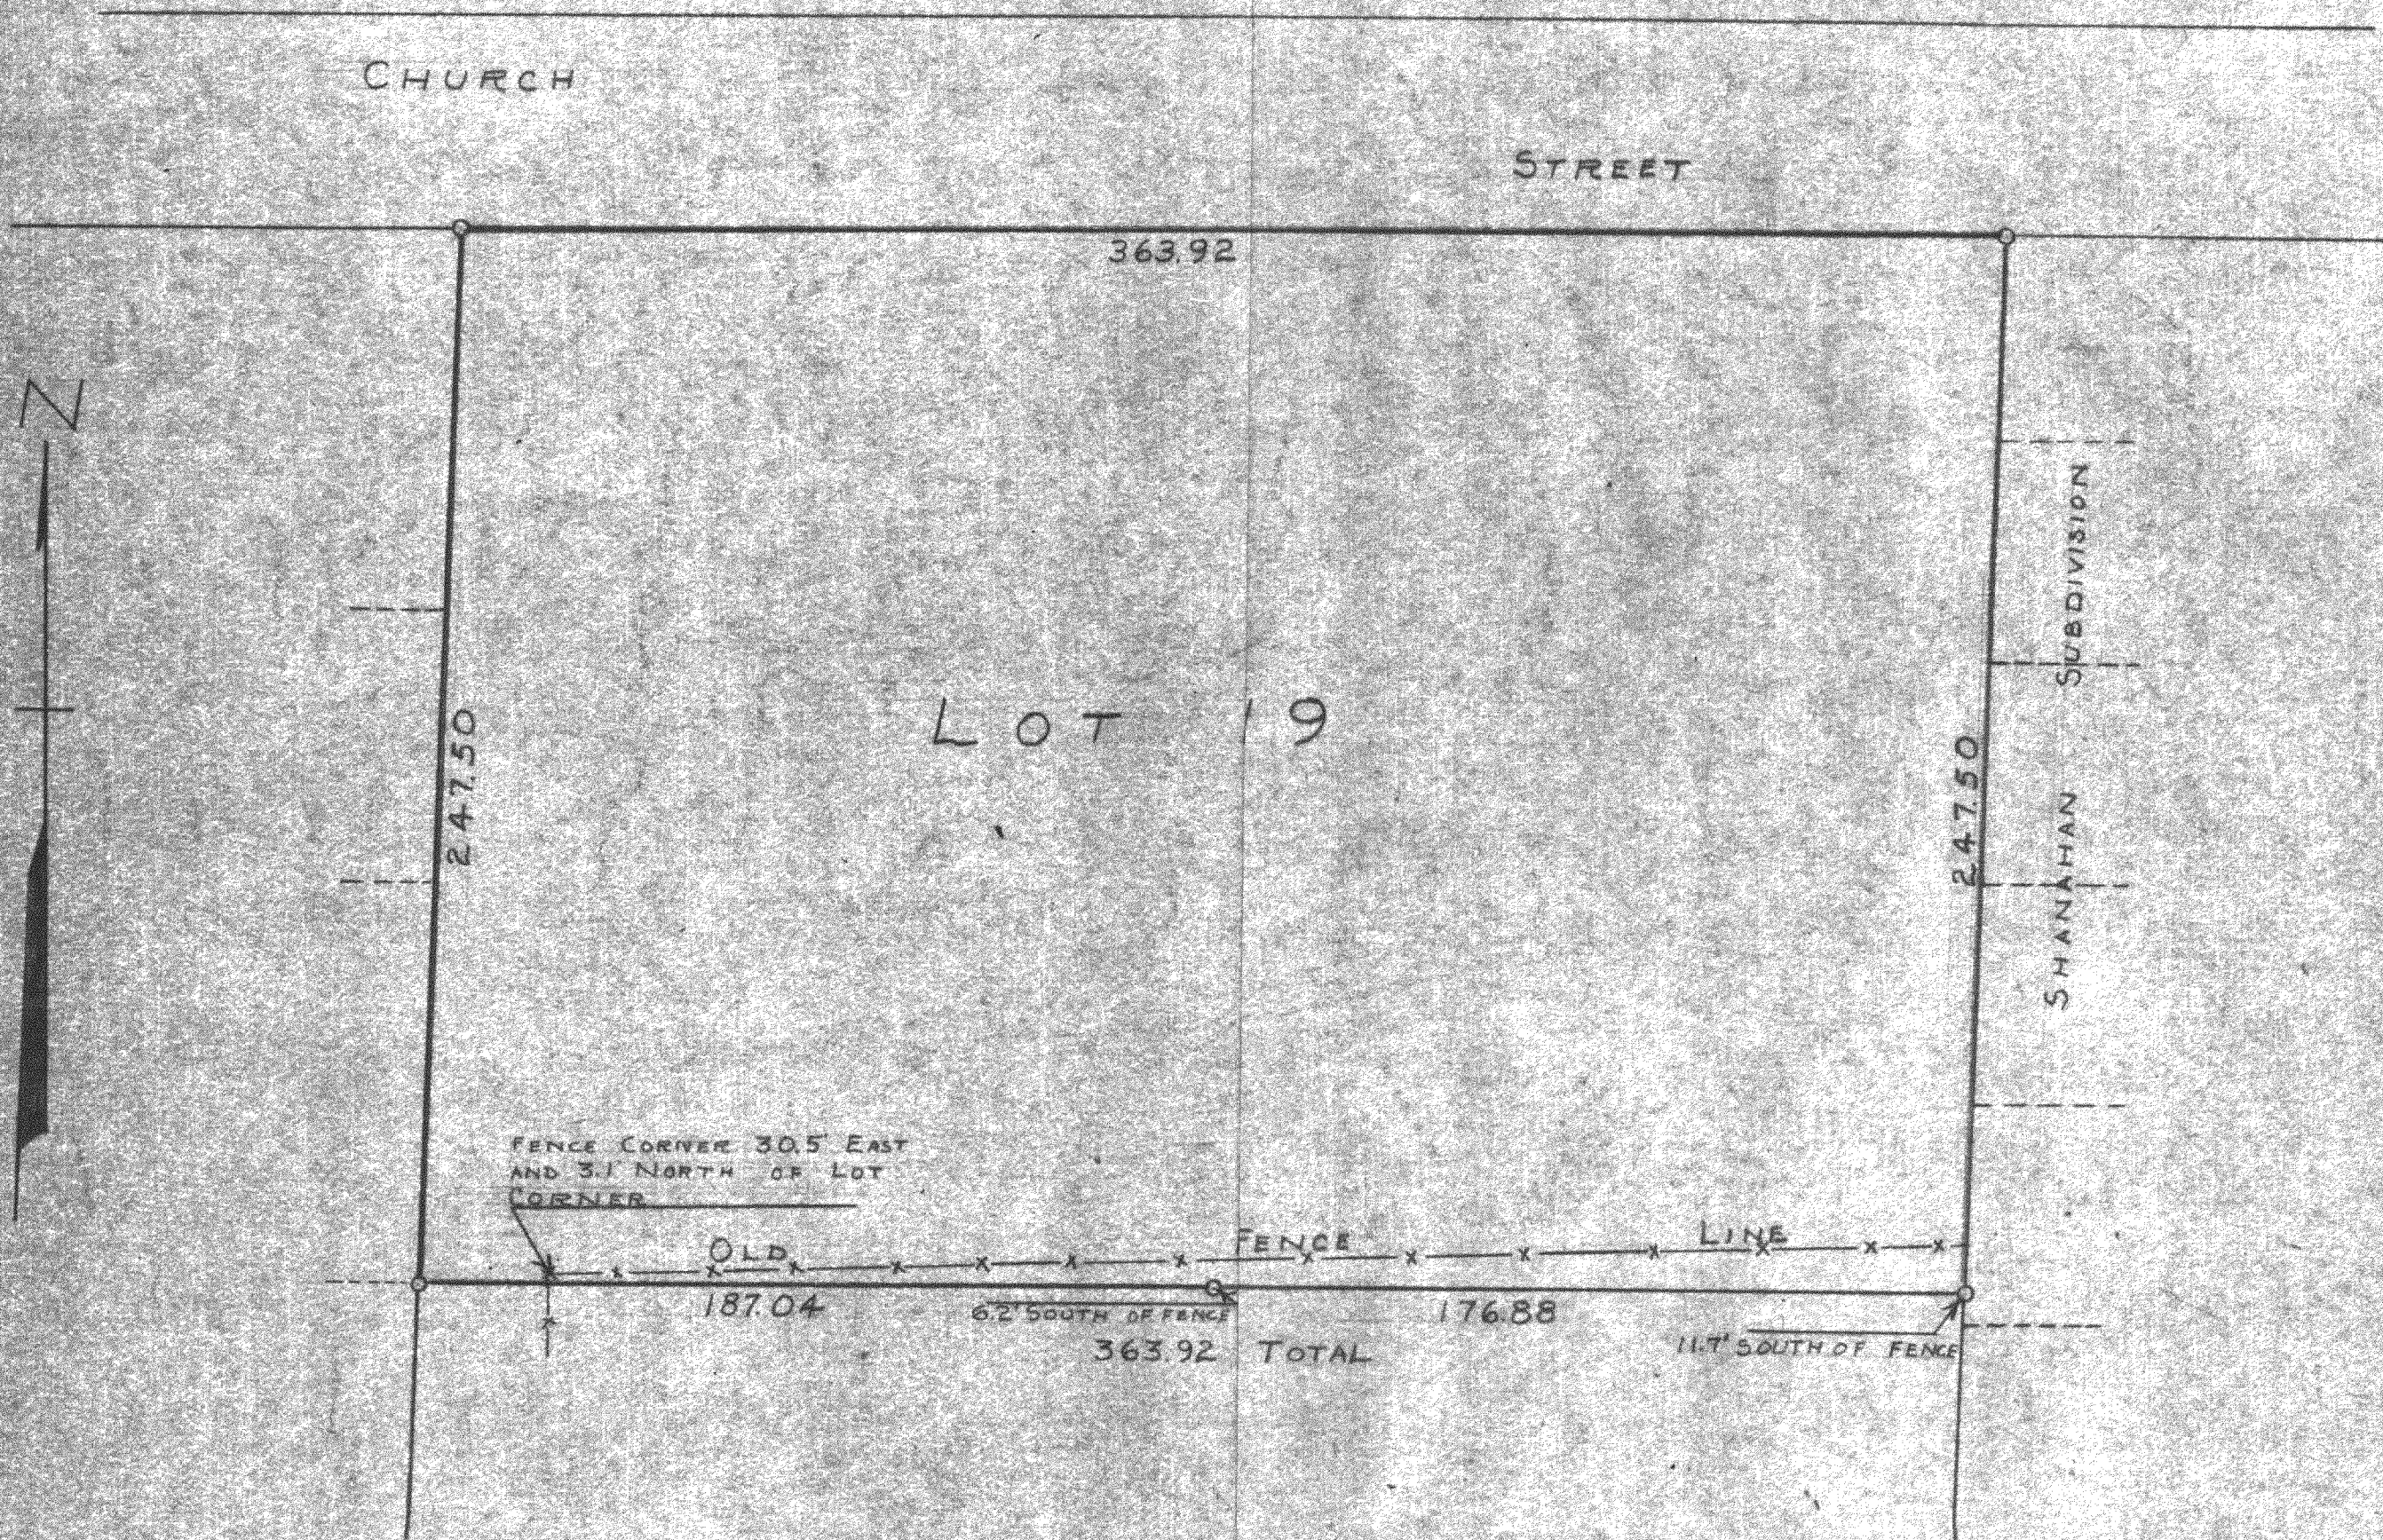

PLAT OF SURVEY OF LOT 19, BLOCK 7, CITIZENS ADDITION TO
THE VILLAGE OF SHARON, WALWORTH COUNTY, WISCONSIN
SEPTEMBER, 1952

45 980 XUCA-115

8-3

Bernard T. Amrhein
SURVEYOR