


ALTA\ACSM LAND TITLE SURVEY

LOTS 1 AND 2 OF CERTIFIED SURVEY MAP NO. 2724, RECORDED IN THE WALWORTH COUNTY REGISTER OF DEEDS OFFICE JULY 12, 1996 IN VOLUME 14, PAGE 63, AS DOCUMENT NO. 333973; BEING A RESUBDIVISION OF LOTS 8 THROUGH 18, BLOCK 1, CITIZEN'S ADDITION TO THE VILLAGE OF SHARON, WALWORTH COUNTY, WISCONSIN, BEING PART OF THE SOUTHWEST QUARTER OF SECTION 28, TOWN 1 NORTH, RANGE 15 EAST, IN THE VILLAGE OF SHARON, WALWORTH COUNTY, WISCONSIN.

(Rec. = 1461.90)
N 87°08'58" E 1469.80

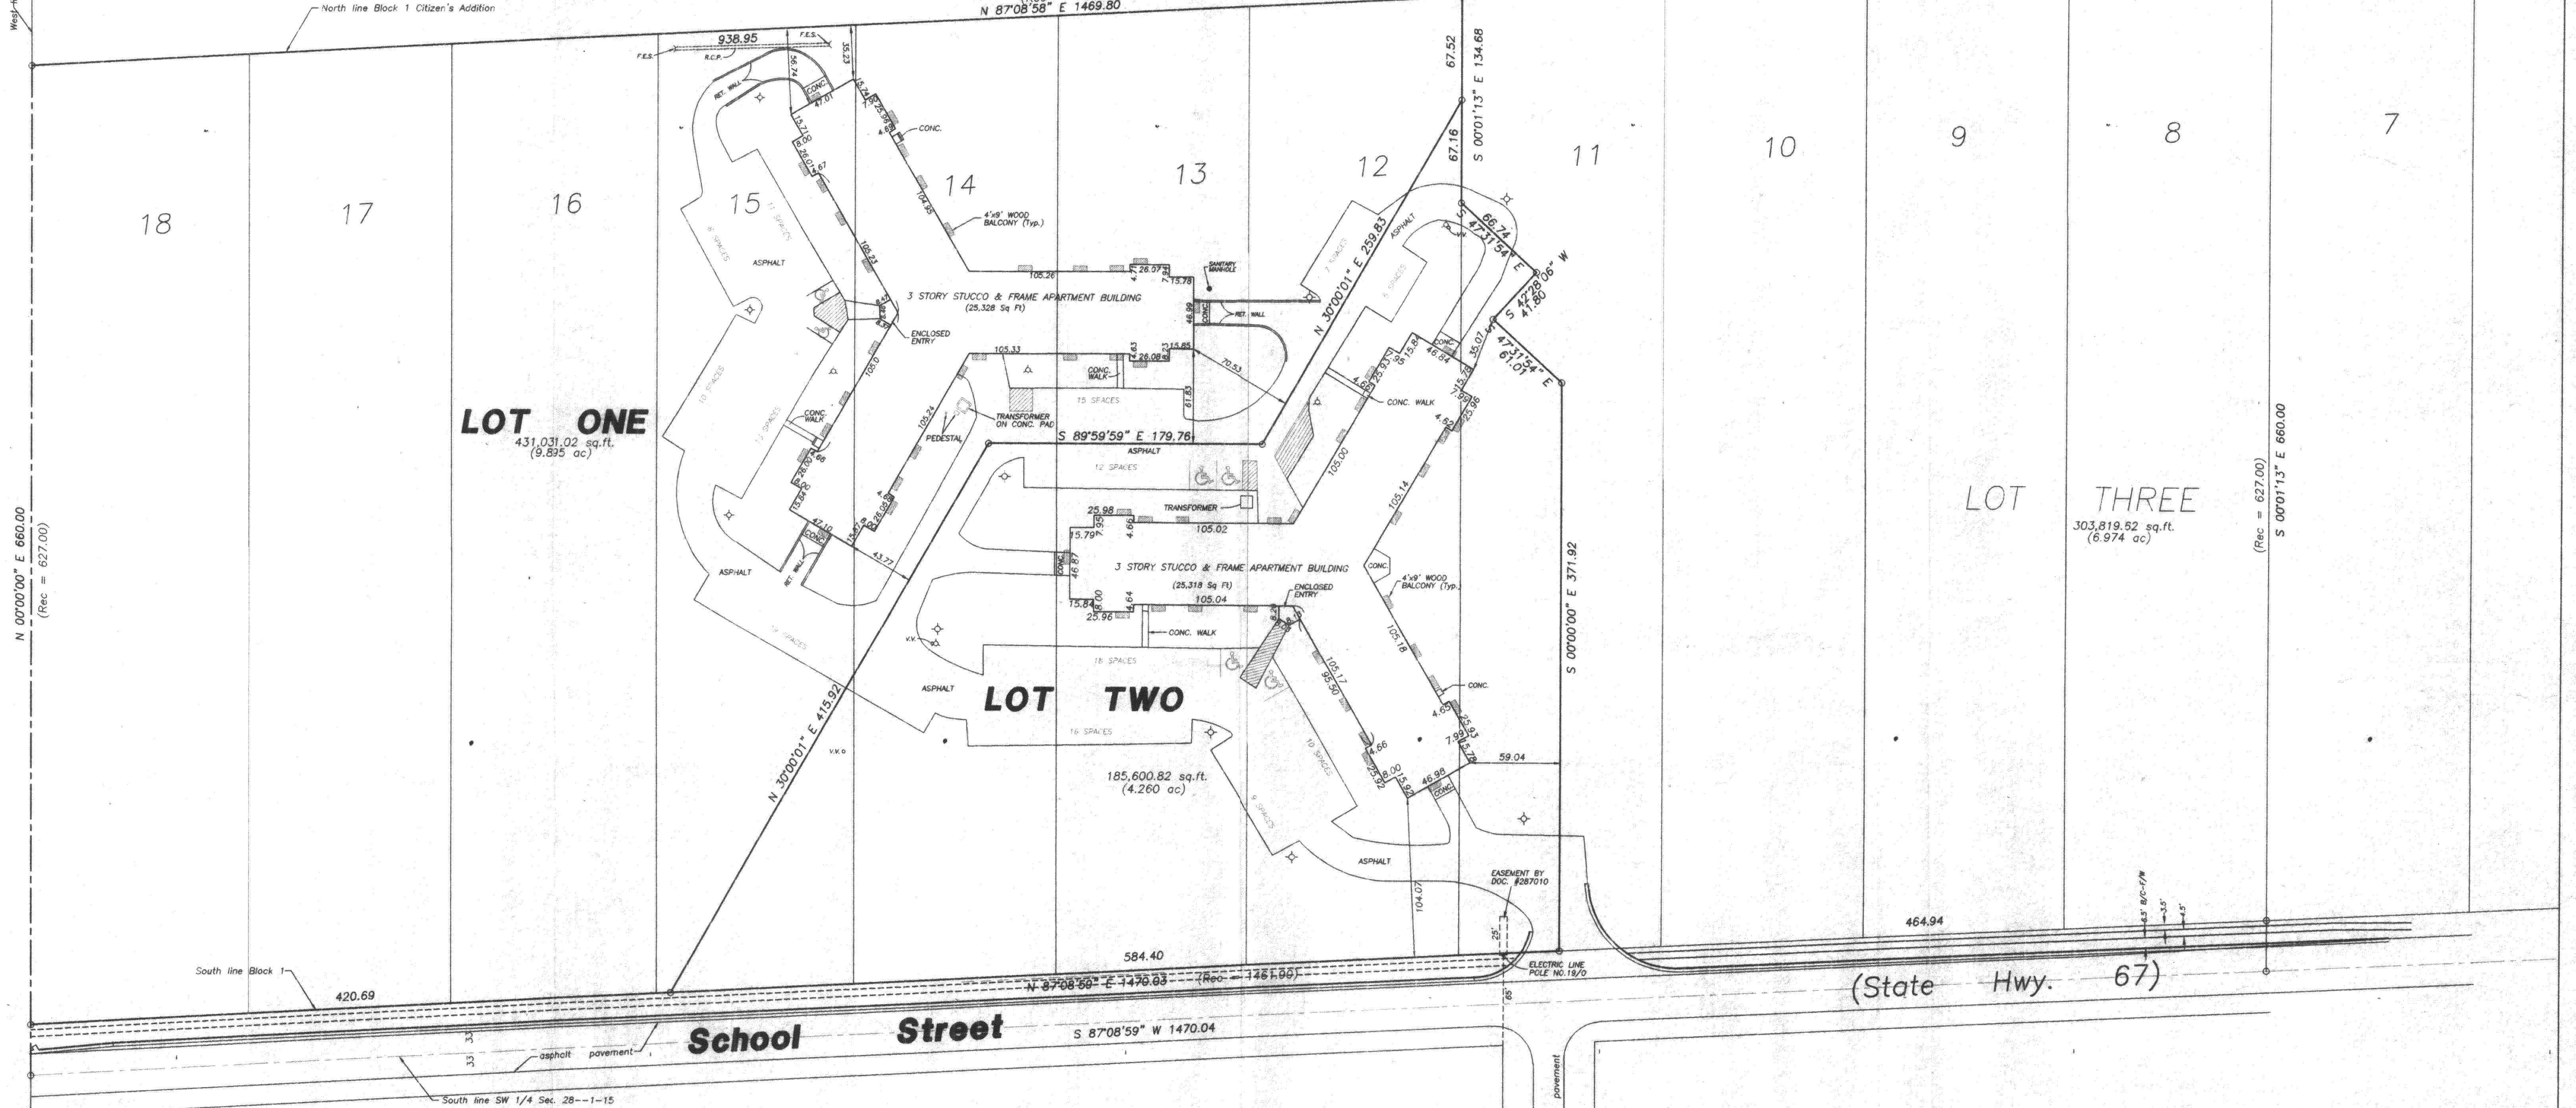

ALL DISTANCE IN FEET AND DECIMAL PARTS THEREOF. NO DIMENSIONS TO BE ASSUMED BY SCALING.

SCALE: One inch = 50 feet

FILE NO. 94-1588-S

ORDERED BY: Kangas Construction

PROPERTY ADDRESS:

Sharon, Wisconsin

PELAY SURVEYING CO., LTD

1810 N. DELANY ROAD
SUITE M
GURNEE, IL. 60031-1263
(847) 336-0069 PHONE
(847) 336-8753 FAX




NORTH

LEGEND


- ◊ = LIGHT POLE
- △ = FIRE HYDRANT
- W = WALK
- F.E.S. = PLACED END SECTION
- R.C.P. = REINFORCED CONCRETE PIPE

NOTE: BUILDING DIMENSIONS AND BUILDING TIES ARE TO CONCRETE FOUNDATION.

153 OUTSIDE PARKING SPACES
8 OUTSIDE HANDICAPPED PARKING SPACES
134 INSIDE PARKING SPACES

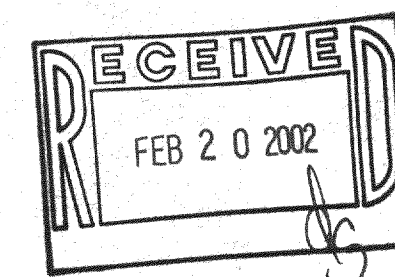

Compare your description and site markings with this plat and AT ONCE report any discrepancies which you may find.

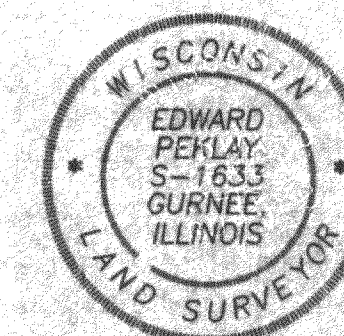

WA-2724-2

WA-2724-1

008-361

TO:

STATE OF ILLINOIS
COUNTY OF LAKE

This is to certify that this plat and the survey on which it is based were made in accordance with Minimum Standard Detail Requirements for ALTA\ACSM Land Title Surveys, jointly established and adopted by ALTA and ACSM in 1992 and pursuant to the Accuracy Standards (as adopted by ALTA and ACSM and in effect on the date of this certification of an Urban Survey).

Gurnee, IL. January 16th A.D., 20 01

By Edward Perlay
Wisconsin Registered Land Surveyor No. 1633