
PLAT OF SURVEY

LOT 14, BLOCK 8 OF CITIZENS ADDITIONS, VILLAGE OF SHARON, WALWORTH COUNTY, WISCONSIN

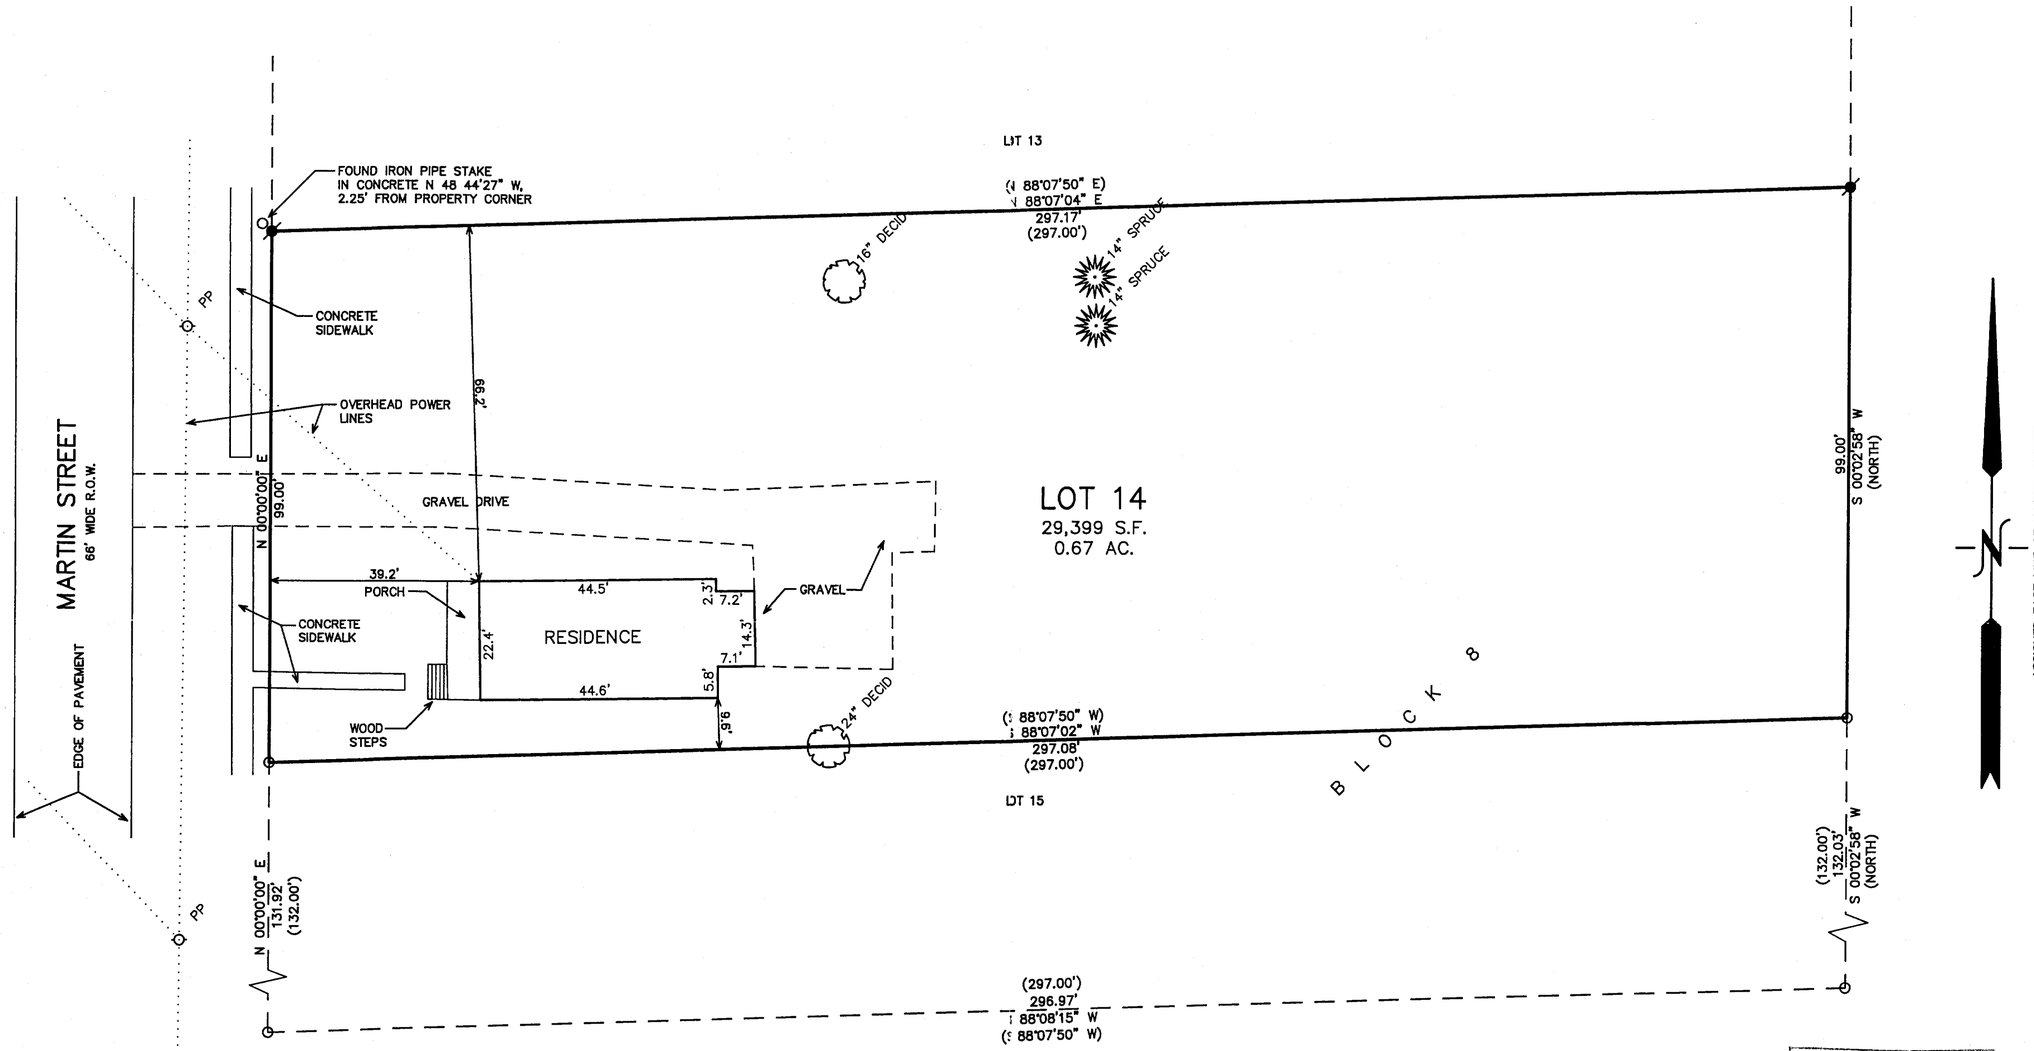

RECEIVED
APR 5 2004
KW

LEGEND

- O = FOUND IRON PIPE STAKE
- ⌀ = SET IRON REBAR STAKE
- (XXX) = RECORDED AS

10 5 0 10 20 30 40 50 60 70 80 90 100

MAP SCALE IN FEET ORIGINAL 1" = 20'

NOTE: COPIES OF THIS MAP TO WHICH THE FOLLOWING CERTIFICATE WILL APPLY SHOW THE SURVEYOR'S ORIGINAL SEAL AND SIGNATURE IN RED INK. COPIES BY ANY OTHER MEANS MAY HAVE ALTERATIONS WHICH DO NOT REPRESENT THE SURVEYOR'S WORK PRODUCT.

I HEREBY CERTIFY THAT THE ABOVE DESCRIBED PROPERTY HAS BEEN SURVEYED UNDER MY DIRECTION AND THAT THE ABOVE MAP IS A TRUE REPRESENTATION THEREOF AND SHOWS THE SIZE AND LOCATION OF THE PROPERTY AND ITS EXTERIOR BOUNDARIES. THIS SURVEY IS MADE FOR THE USE OF THE PRESENT OWNERS OF THE PROPERTY, AND ALSO THOSE WHO PURCHASE, MORTGAGE, OR GUARANTEE THE TITLE THERETO WITHIN ONE YEAR FROM THE DATE HEREOF.

DATED: MARCH 17, 2004

PETER S. GORDON R.L.S. 2101

3/19/2004 X:\Projects\6509\Dcad\SURVEY

– WORK ORDERED BY –
LES ROSS
136 MARTIN STREET
SHARON, WI 53585

FARRIS, HANSEN & ASSOCIATES, INC.
ENGINEERING – ARCHITECTURE – SURVEYING
7 RIDGWAY COURT P.O. BOX 437
ELKHORN, WISCONSIN 53121
OFFICE: (262) 723-2098 FAX: (262) 723-5886

REVISIONS

PROJECT NO. 6509
DATE: 03/17/04
SHEET NO. 1 OF 1

UCA-130

008-395