


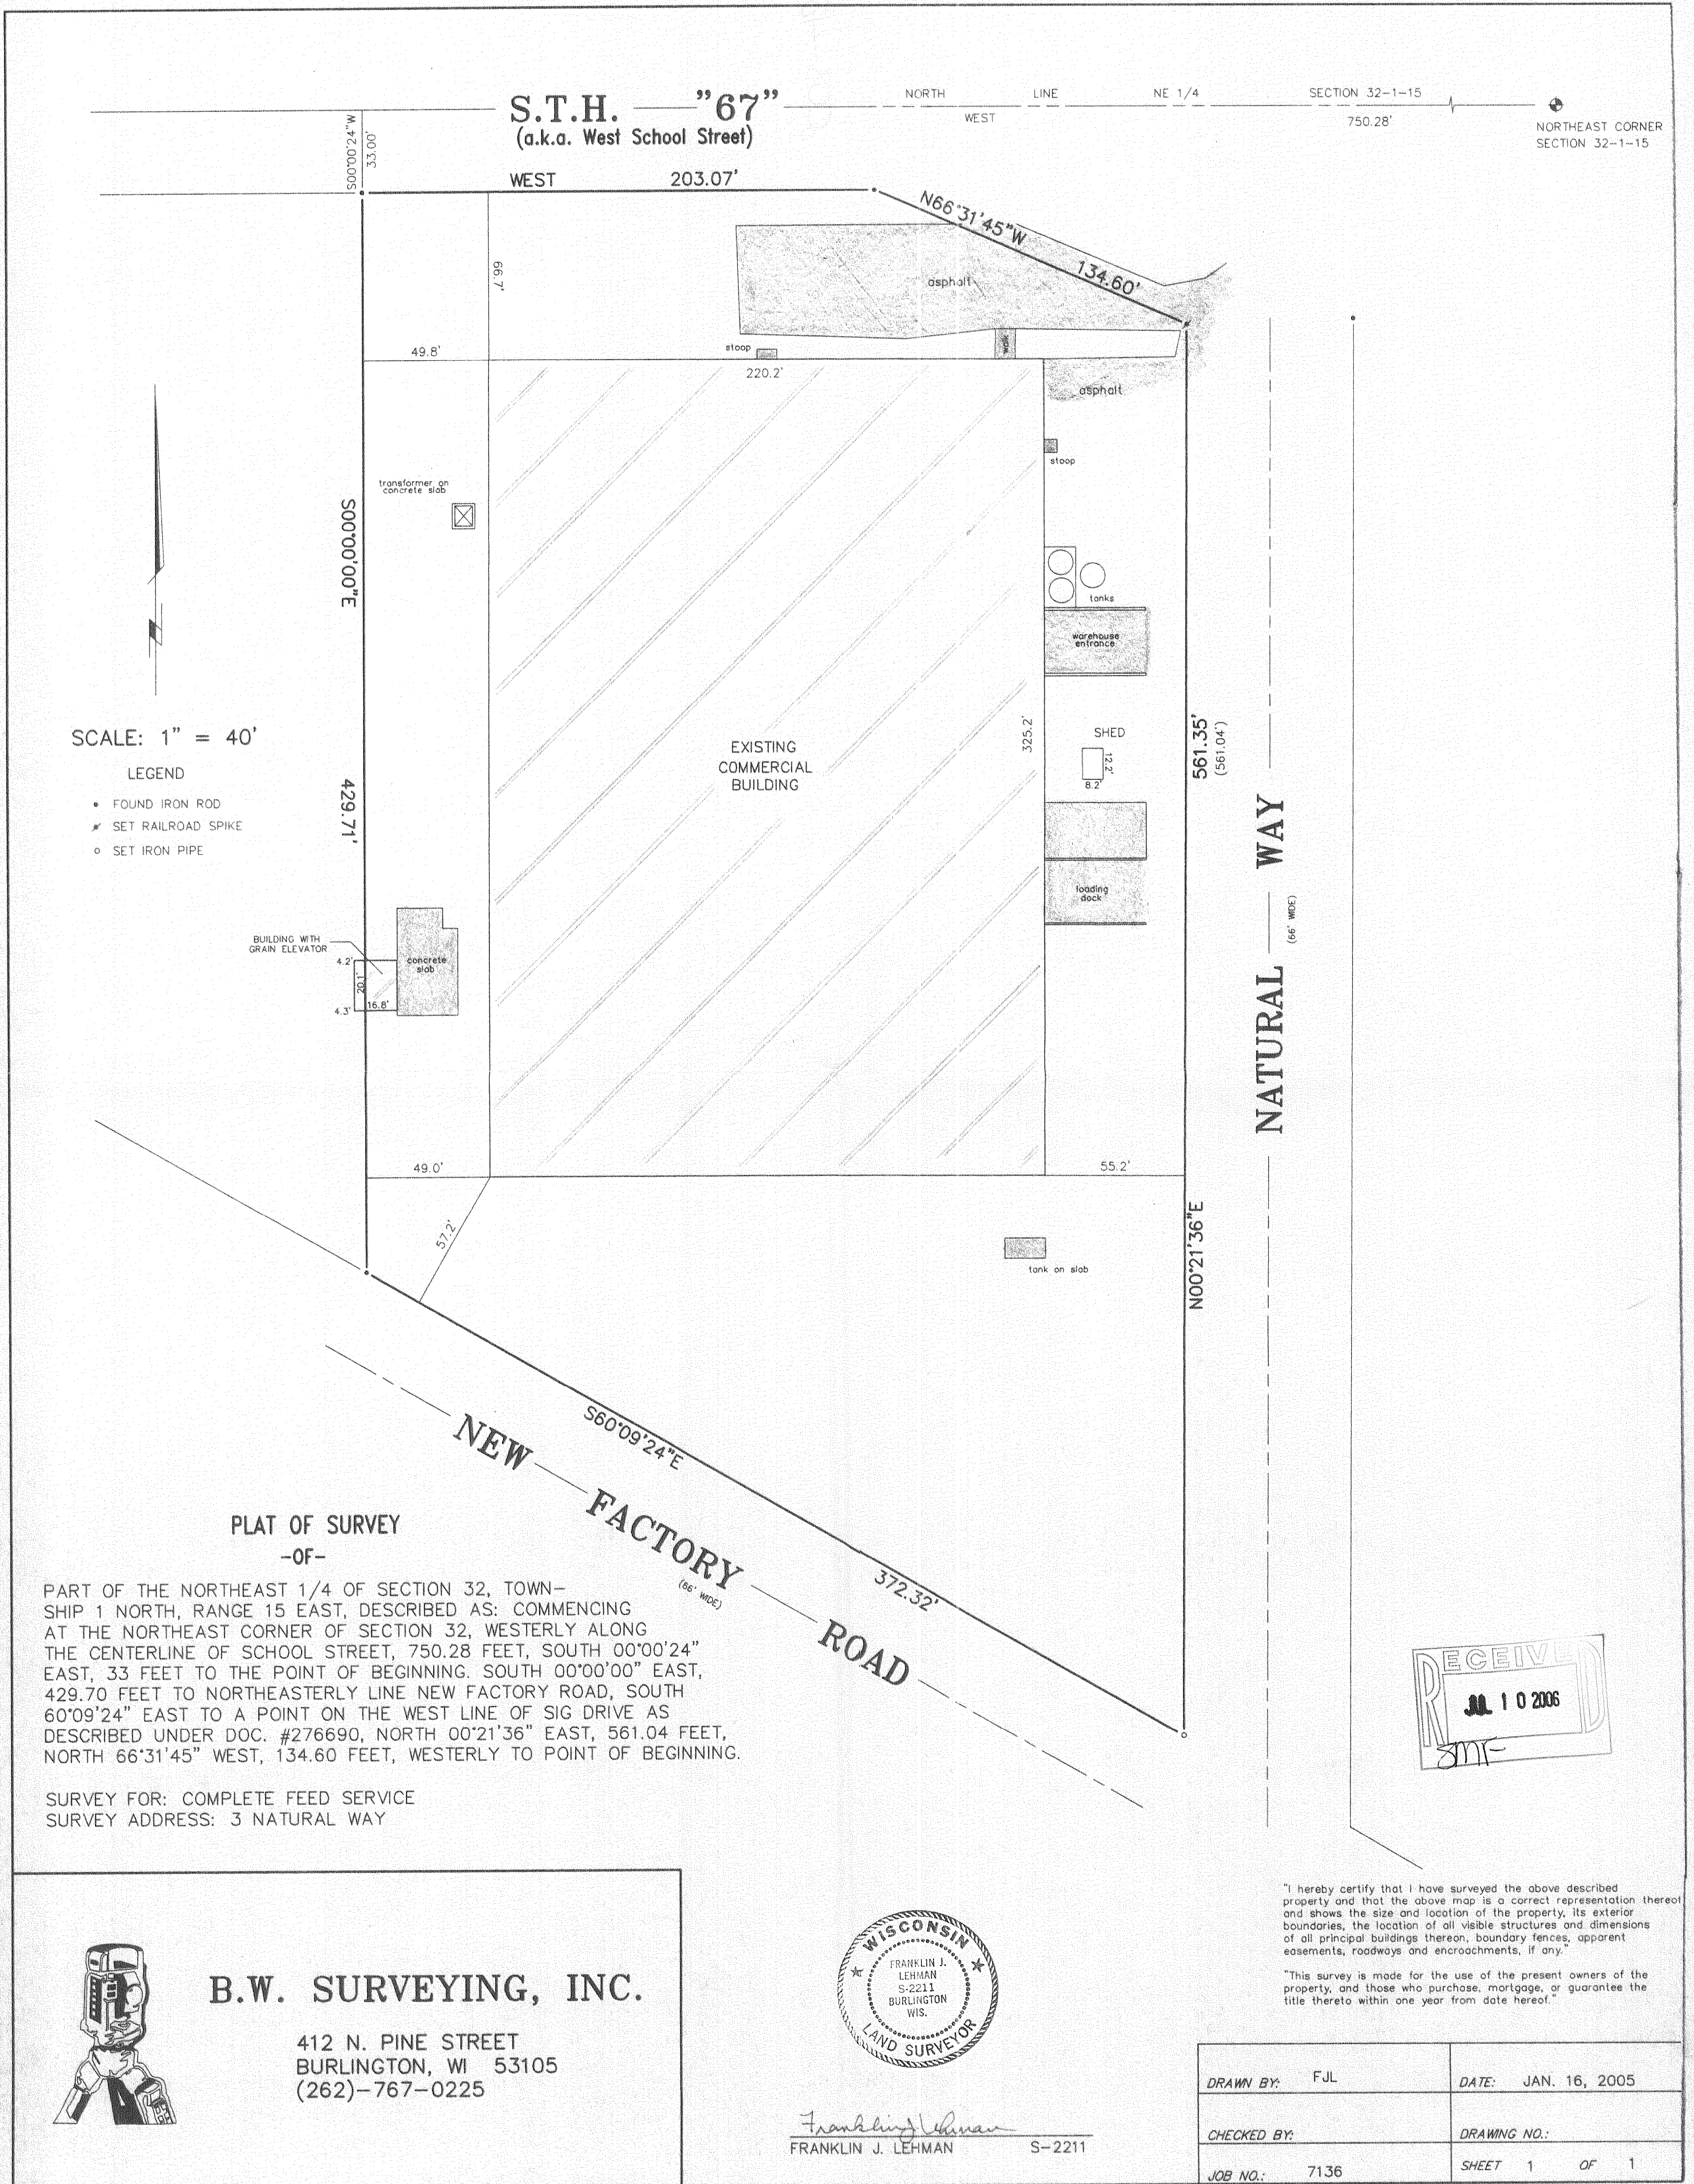

UWV-1

008-421