
ABELL
SURVEYING & MAPPING
1140 SEQUOIA STREET · DELAVAN, WISCONSIN 53115
262-728-6737

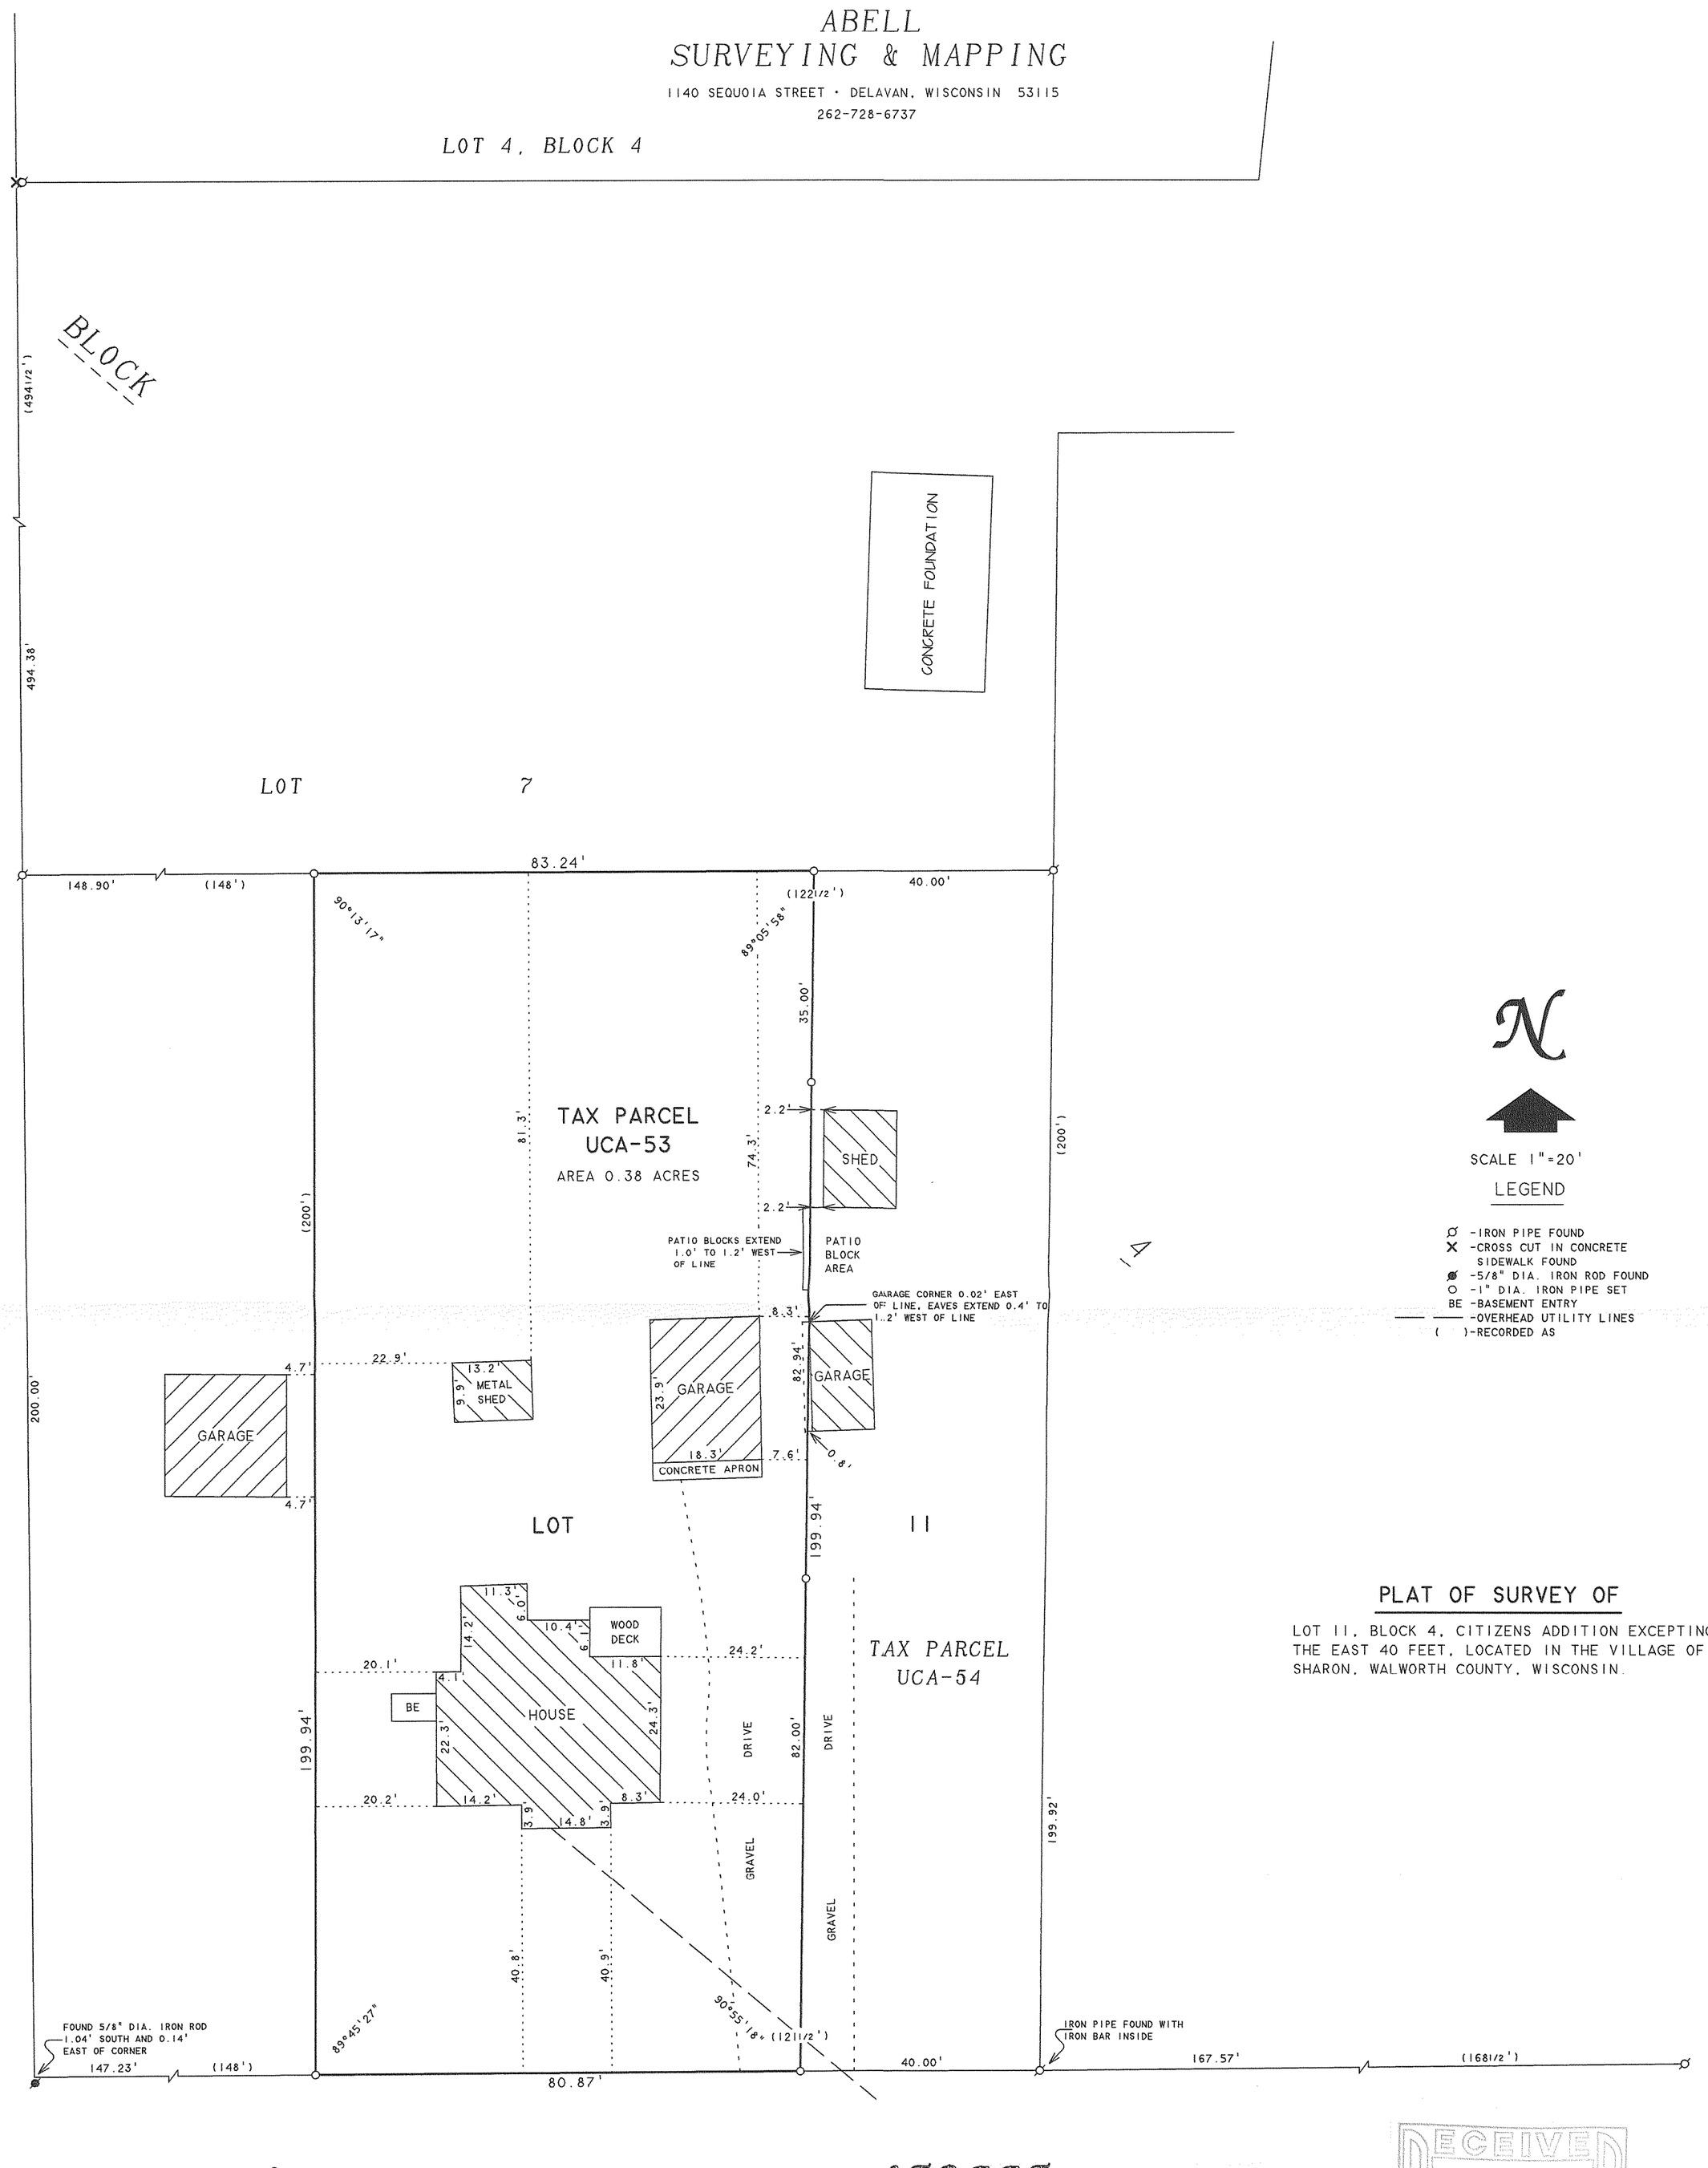

PLAT OF SURVEY OF

LOT 11, BLOCK 4, CITIZENS ADDITION EXCEPTING THE EAST 40 FEET, LOCATED IN THE VILLAGE OF SHARON, WALWORTH COUNTY, WISCONSIN.

RECEIVED
OCT 25 2006
SMF

ORDERED BY: RASMUSSEN LAW OFFICE
113 KENOSHA STREET
WALWORTH, WI 53184

I HEREBY CERTIFY THAT I HAVE SURVEYED THE ABOVE DESCRIBED PROPERTY AND THAT THE ABOVE MAP IS A TRUE REPRESENTATION THEREOF AND SHOWS THE SIZE AND LOCATION OF THE PROPERTY, ITS EXTERIOR BOUNDARIES, THE LOCATION OF ALL VISIBLE STRUCTURES AND DIMENSIONS OF ALL PRINCIPAL BUILDINGS THEREON, BOUNDARY FENCES, APPARENT EASEMENTS, ROADWAYS AND VISIBLE ENCROACHMENTS, IF ANY, TO THE BEST OF MY KNOWLEDGE AND BELIEF.

THIS SURVEY IS MADE FOR THE USE OF THE PRESENT OWNERS OF THE PROPERTY, AND ALSO THOSE WHO PURCHASE, MORTGAGE, OR GUARANTEE THE TITLE THERETO WITHIN ONE (1) YEAR FROM DATE HEREON.

David F. Abell

DAVID F. ABELL
WISCONSIN REGISTERED LAND SURVEYOR, S-1596

August 31, 2006

DATE JOB NUMBER - 05081
NOTE: THIS IS NOT A CERTIFIED COPY UNLESS SEALED.

UCA-53

008-425