
#101-66

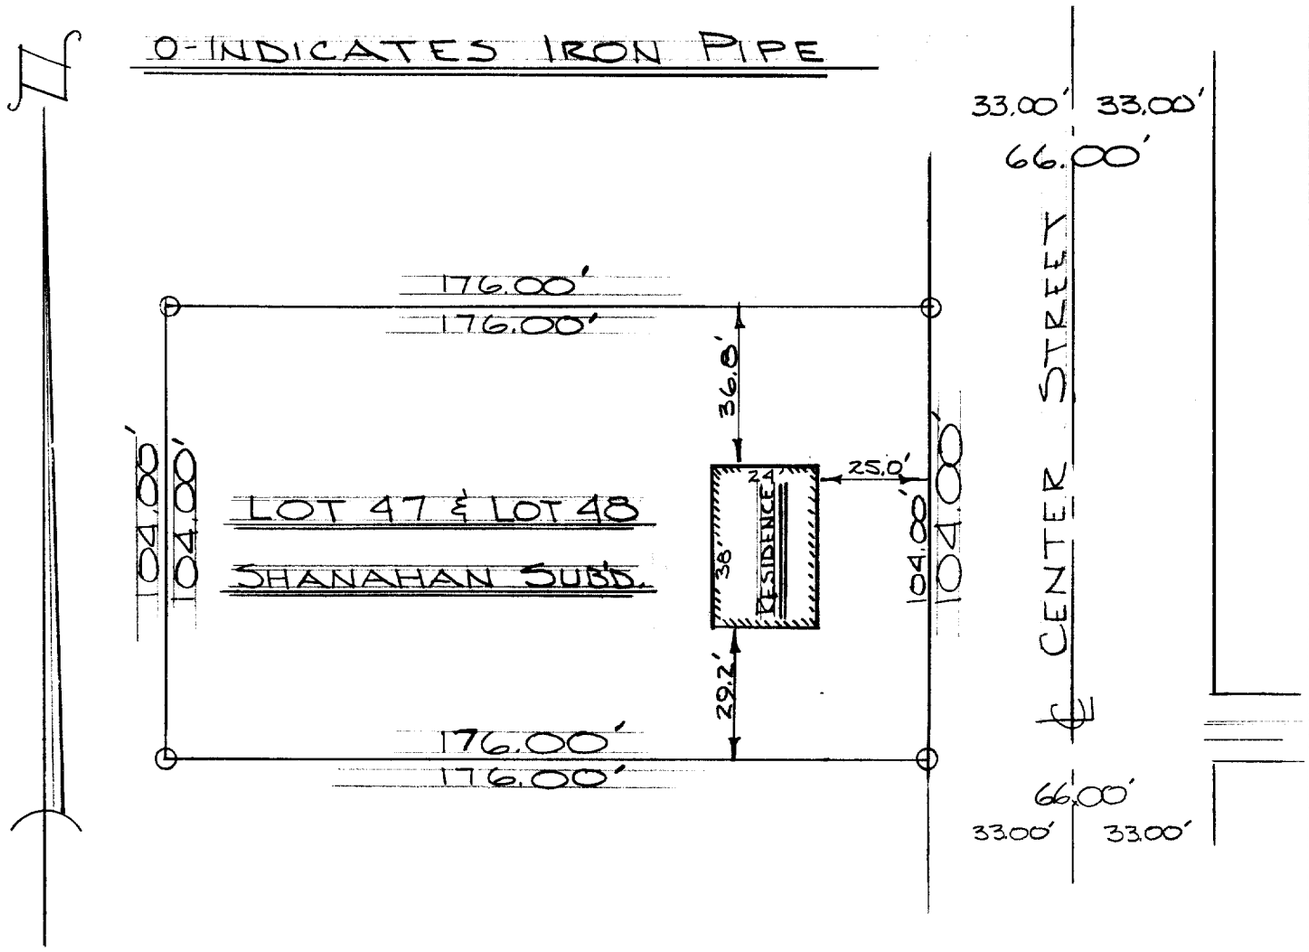

DESCRIPTION: Lots 47 and 48 of Shanahan's Subdivision, in the Village of Sharon, Walworth County, Wisconsin.

CERTIFICATE: I, hereby certify that I have surveyed the above mentioned property and that the hereon portrayed is an accurate survey and a true representation thereof and correctly shows the exterior boundary lines and the location of the buildings and other improvements thereof.

July 20, 1966.

James F. Biagi RLS 272

WISCONSIN
JAMES F.
BIAGI
LAND SURVEYOR

8-4B