
60-55 3

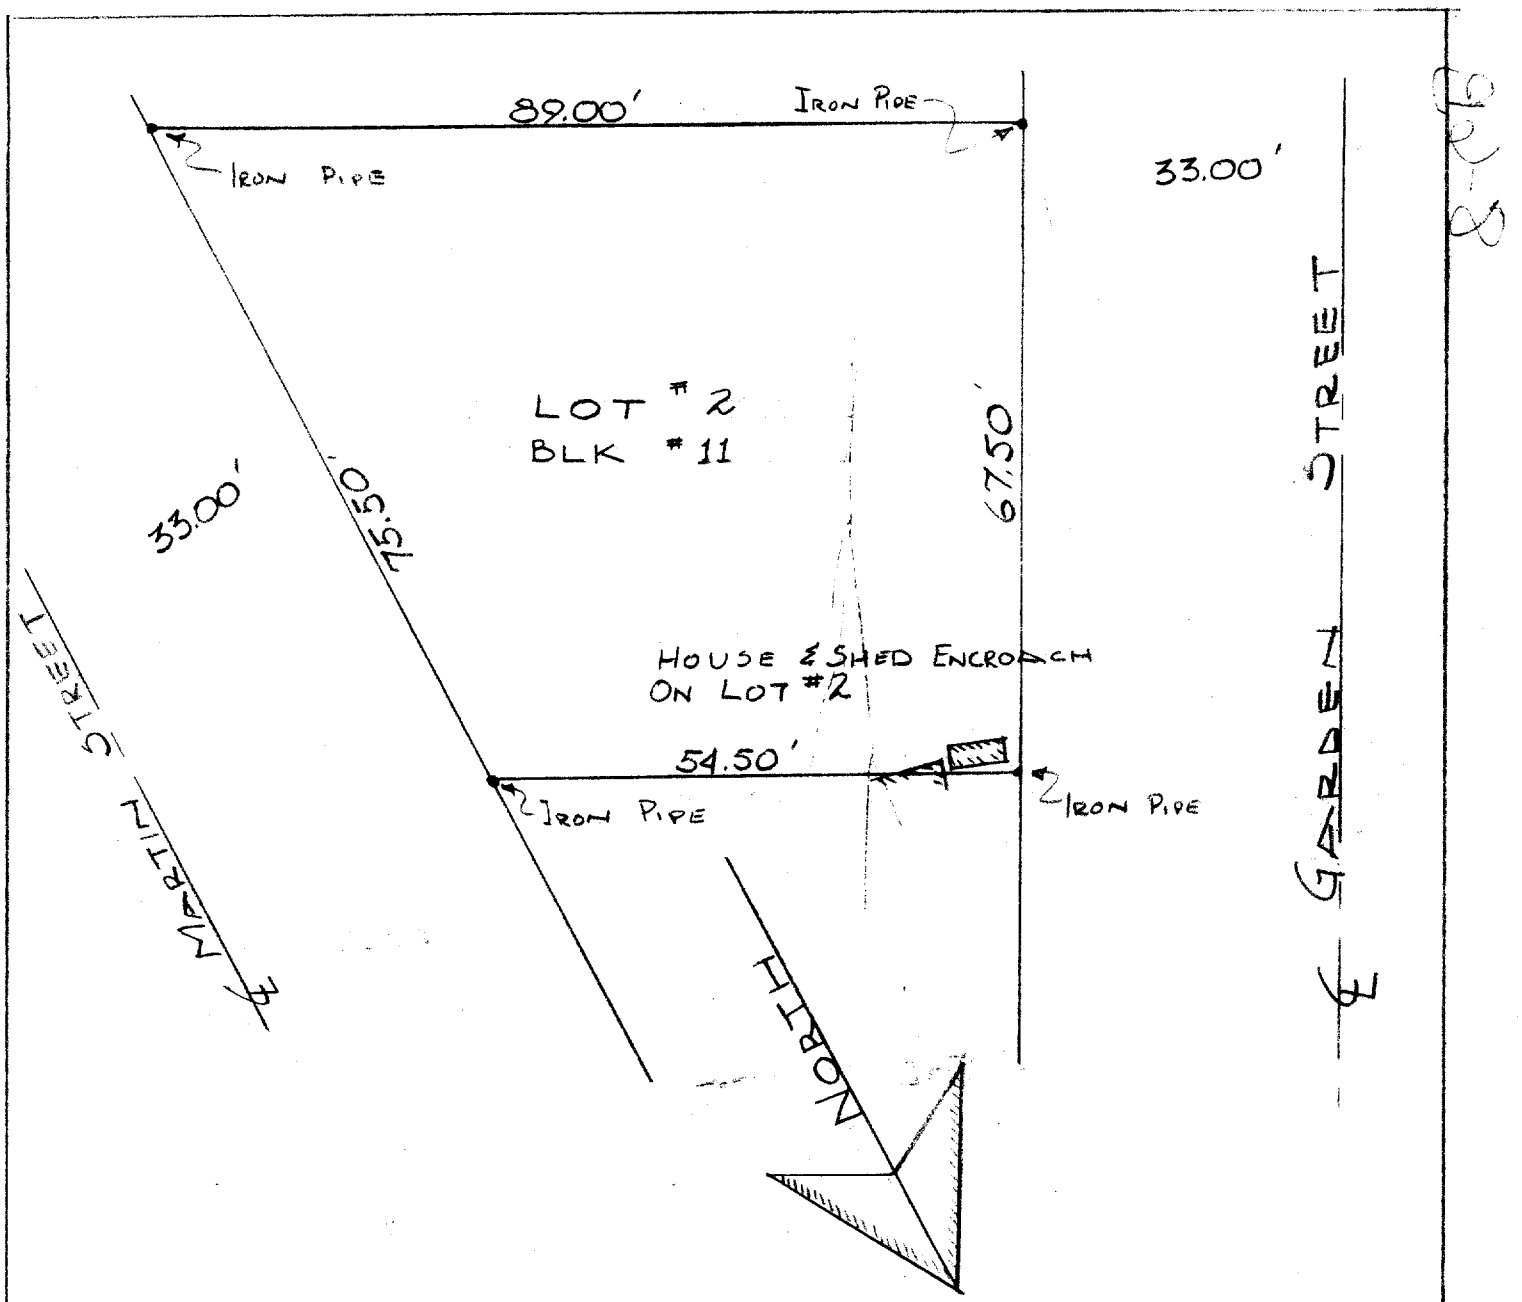

DESCRIPTION: Lot #2 of Block #11 of the Original Plat of the Village of Sharon, Walworth County, Wisconsin.

Plat of survey by James F. Biagi

May 27, 1960.

James F. Biagi RLS 272

WISCONSIN
JAMES F.
BIAGI
MILWAUKEE, WIS.
LAND SURVEYOR

8-6B