
60-57

8-8B

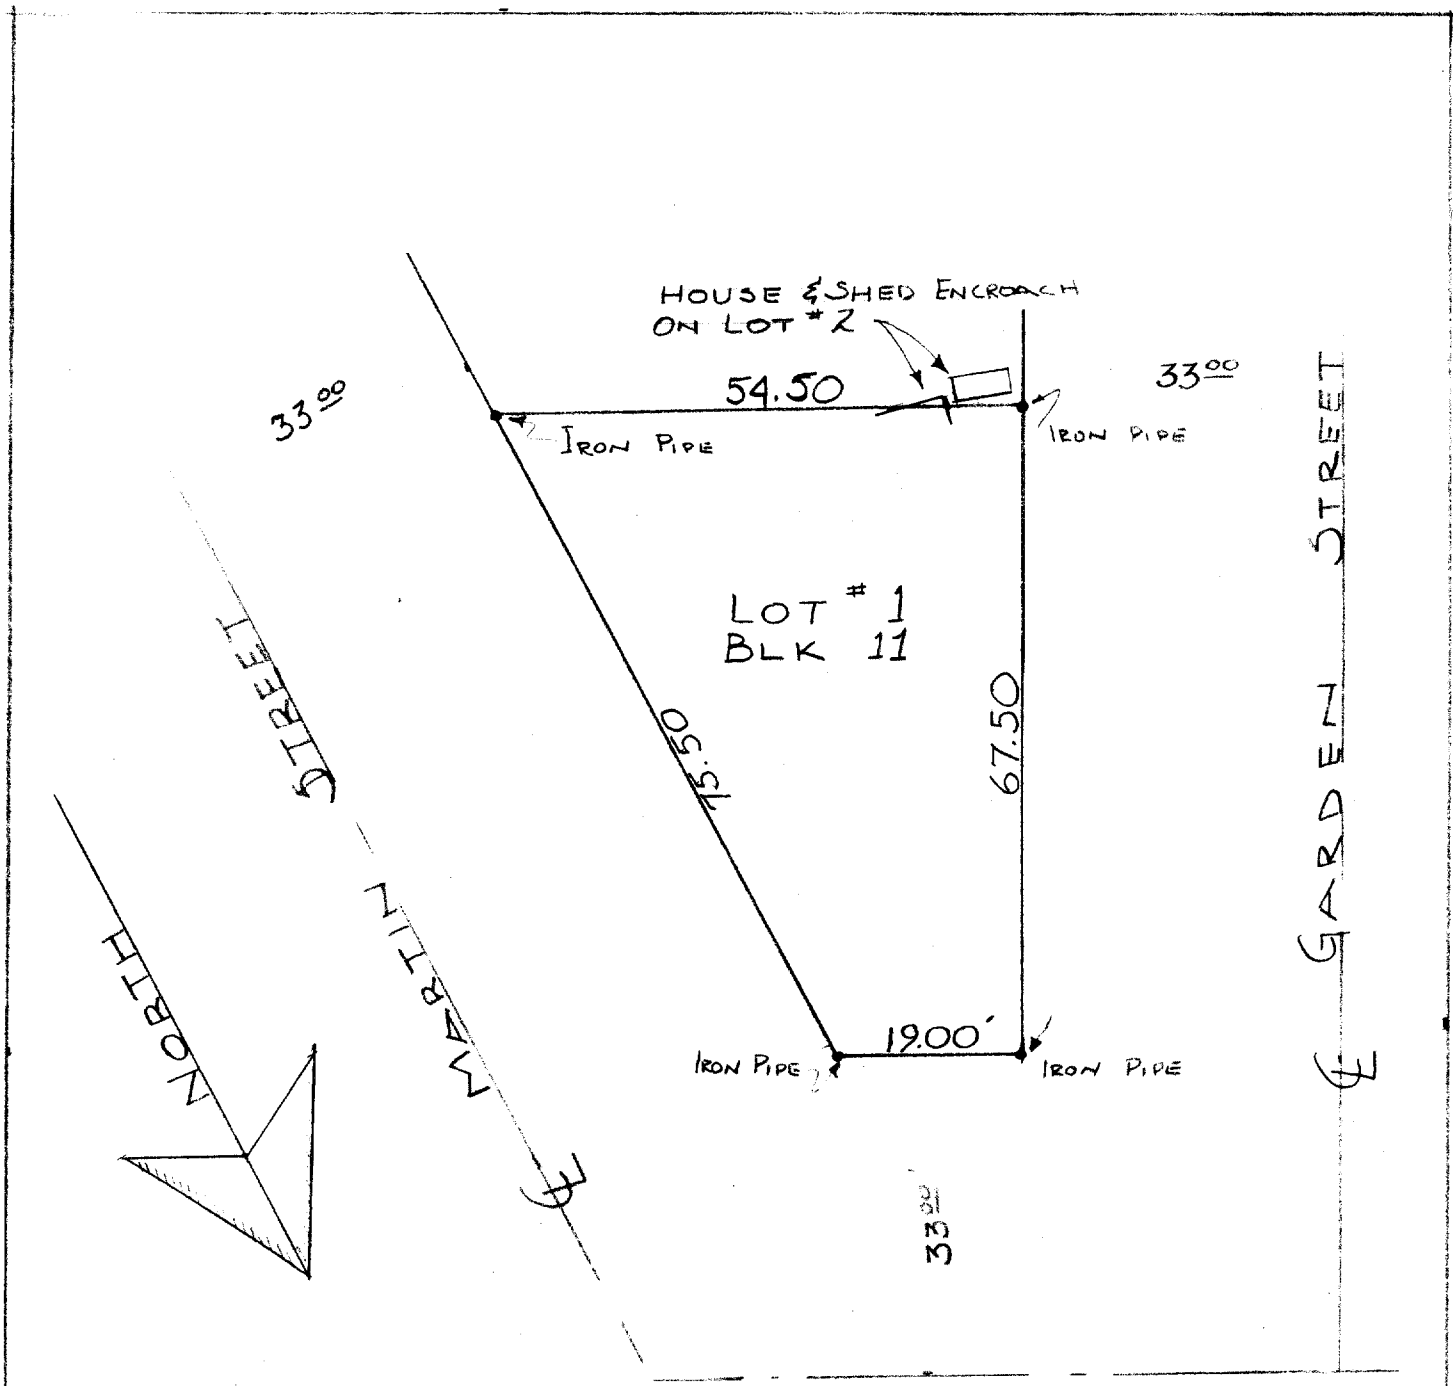

Description: Lot #1 of Block #11 of the Original Plat of the Village of Sharon, Walworth County, Wisconsin.

Plat of survey by James F. Biagi.

Surveyed May 27, 1960.

WISCONSIN
JAMES F. BIAGI
MILWAUKEE, WIS.
LAND SURVEYOR

James F. Biagi RLS 272

8-8B