
PLAT OF SURVEY

OF AREA DISTURBED BY CONSTRUCTION OF A LIFT STATION

LAND LOCATED IN THE N.E. 1/4 OF SECTION 32 AND THE N.W. 1/4 OF SECTION 33, BEING PART OF LOTS 1 & 3, BLOCK 6 OF CITIZENS ADDITION TO THE VILLAGE OF SHARON, T1N, R15E, WALWORTH COUNTY, WISCONSIN.

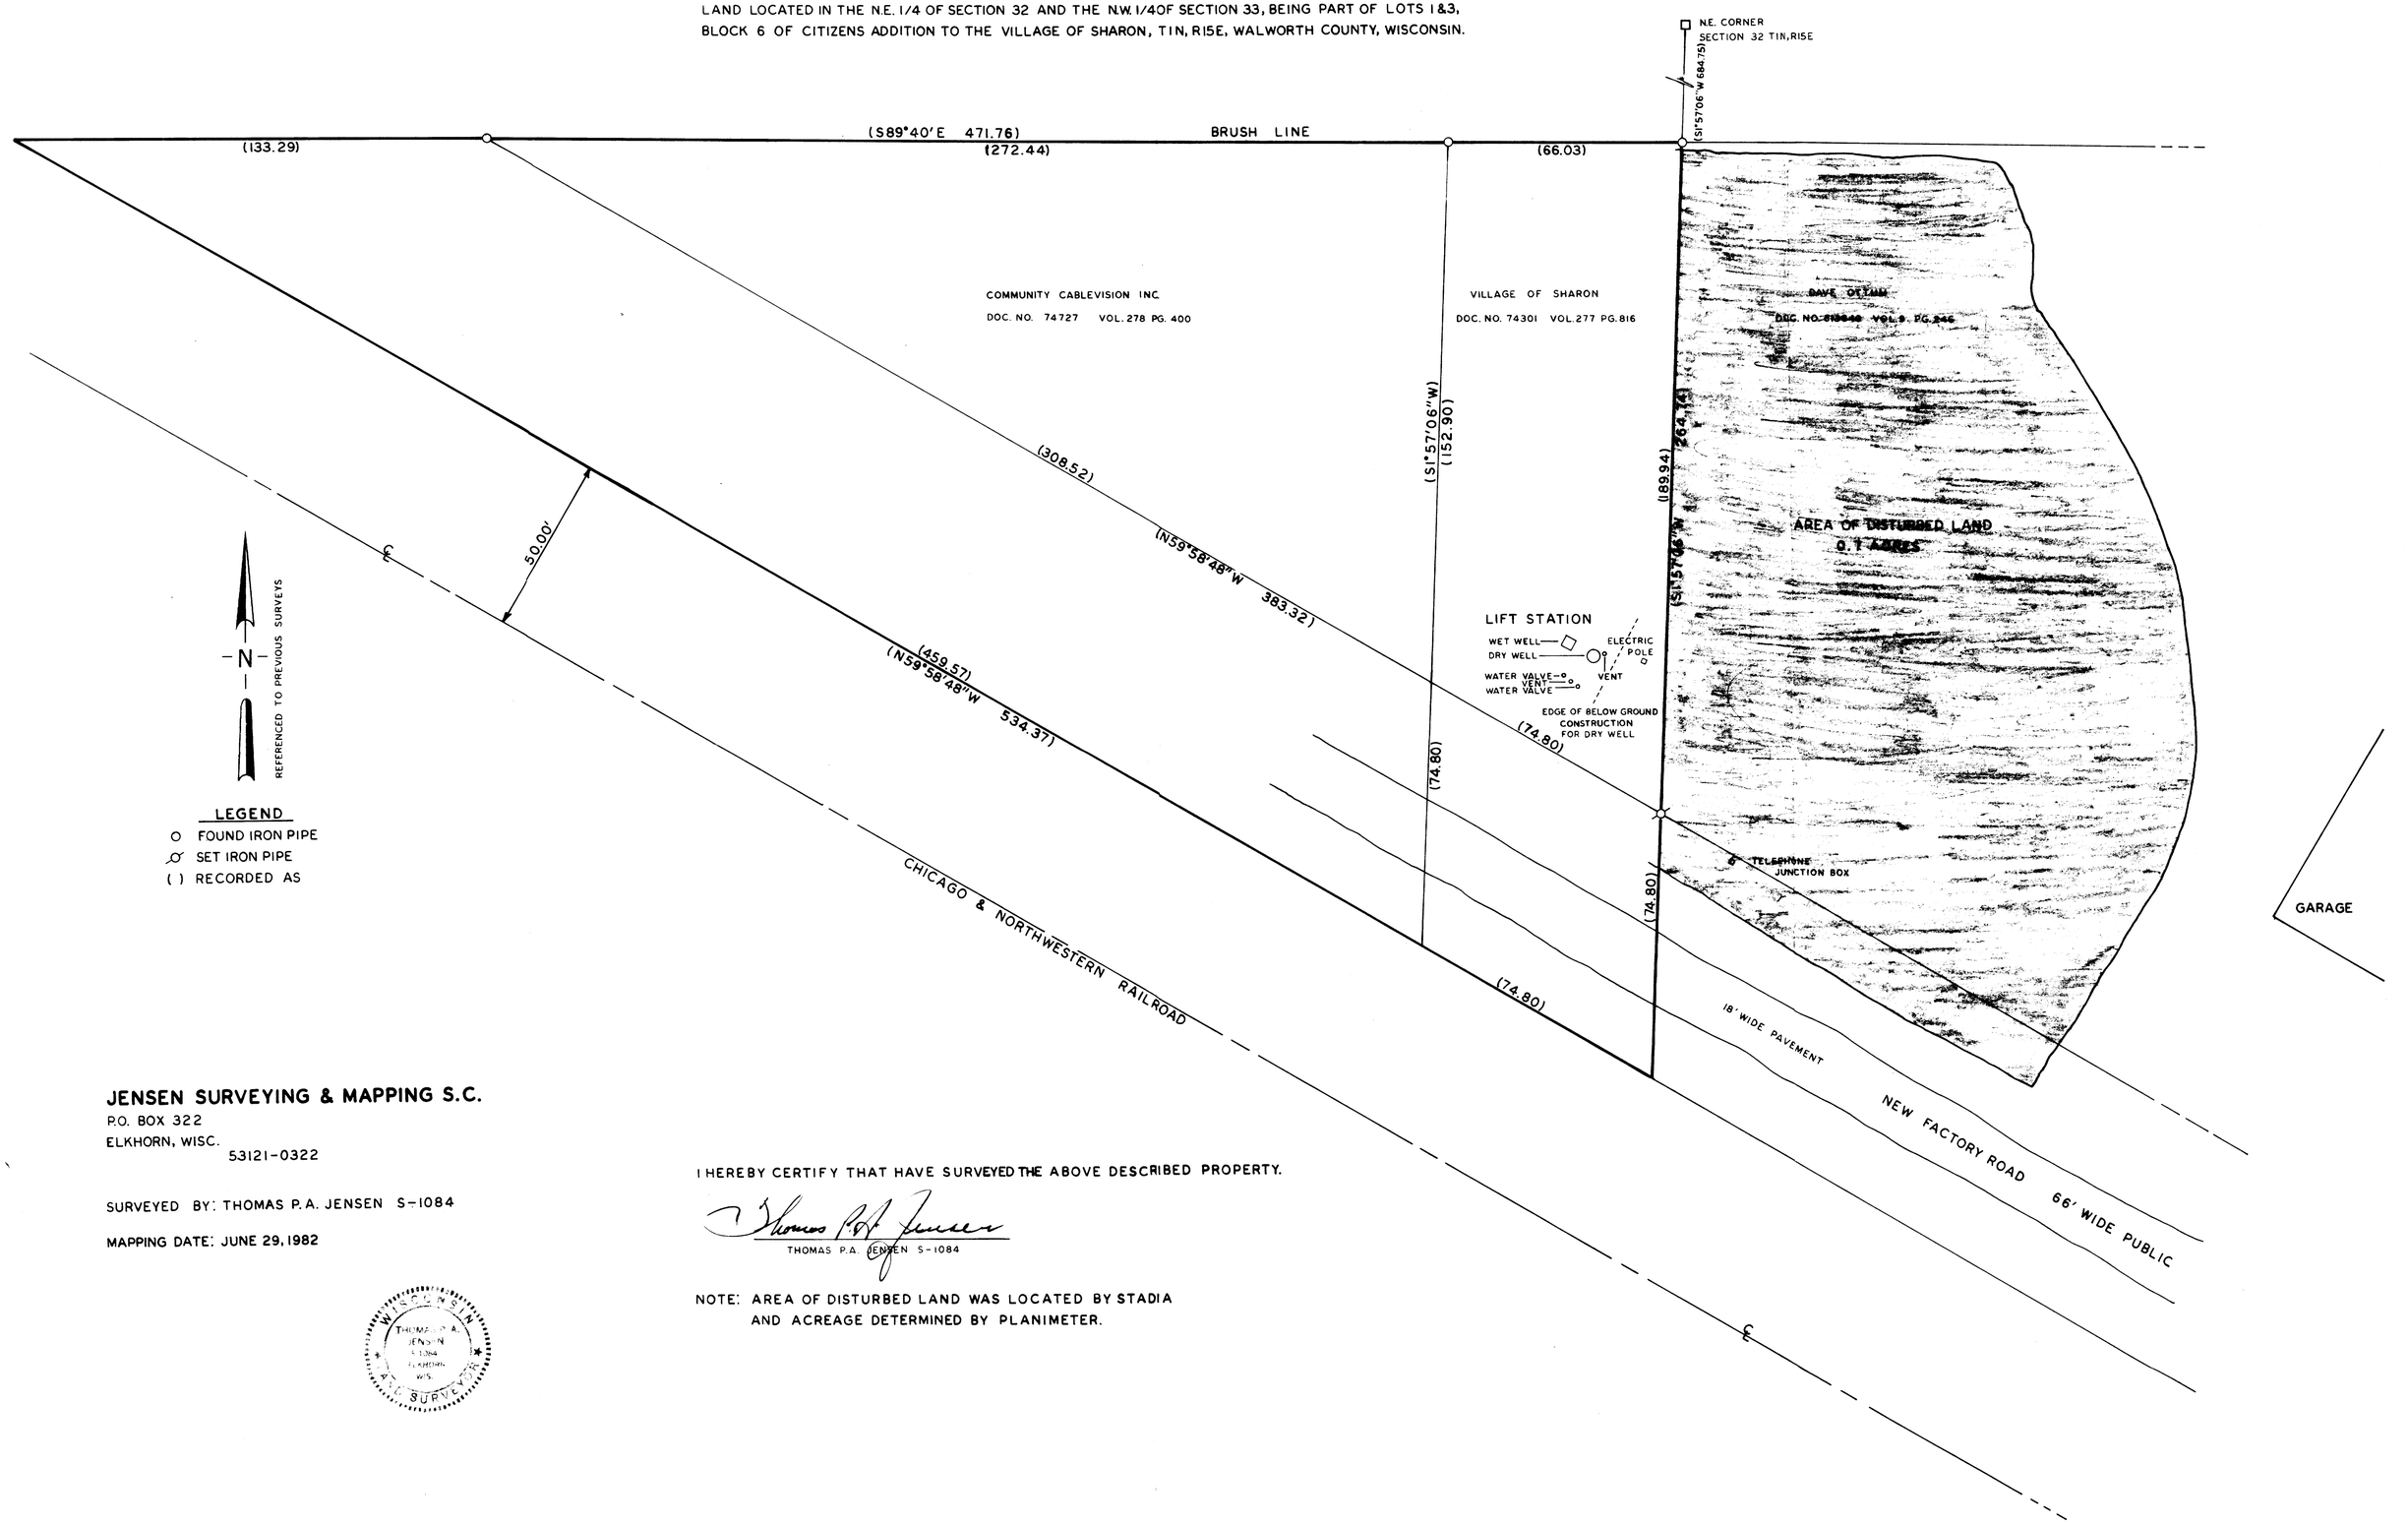

LEGEND

- O FOUND IRON PIPE
- ⌀ SET IRON PIPE
- ( ) RECORDED AS

JENSEN SURVEYING & MAPPING S.C.
P.O. BOX 322
ELKHORN, WISC.
53121-0322

SURVEYED BY: THOMAS P.A. JENSEN S-1084

MAPPING DATE: JUNE 29, 1982

WISCONSIN THOMAS P.A. JENSEN S-1084 ELKHORN WIS. LAND SURVEYOR

I HEREBY CERTIFY THAT HAVE SURVEYED THE ABOVE DESCRIBED PROPERTY.

Thomas P.A. Jensen

THOMAS P.A. JENSEN S-1084

NOTE: AREA OF DISTURBED LAND WAS LOCATED BY STADIA AND ACREAGE DETERMINED BY PLANIMETER.

CA-101
CA-96 & C-99 - part of + all of S-92-1

1982.026

8-90-J