Plat of Survey

of

Outlot 97 of the Assessor's Plat of the Village of Walworth,

located in the Southwest 1/4 of the Northwest 1/4 of Section 22, Town 1 North, Range 16 East, Village of Walworth, Walworth County, Wisconsin.

Surveyed for: **Anna Maria Hinkle**
322 Linden Lane
Delavan, Wisconsin. 53115

Bearings referenced to the West line of the Northwest 1/4 of Section 22-1-16, recorded as N1°16'28"W in the Wisconsin State Plane Coordinate System, South Zone, (NAD-27).

Coordinates are referenced to the Wisconsin State Plane Coordinate System, South Zone, (NAD-27).

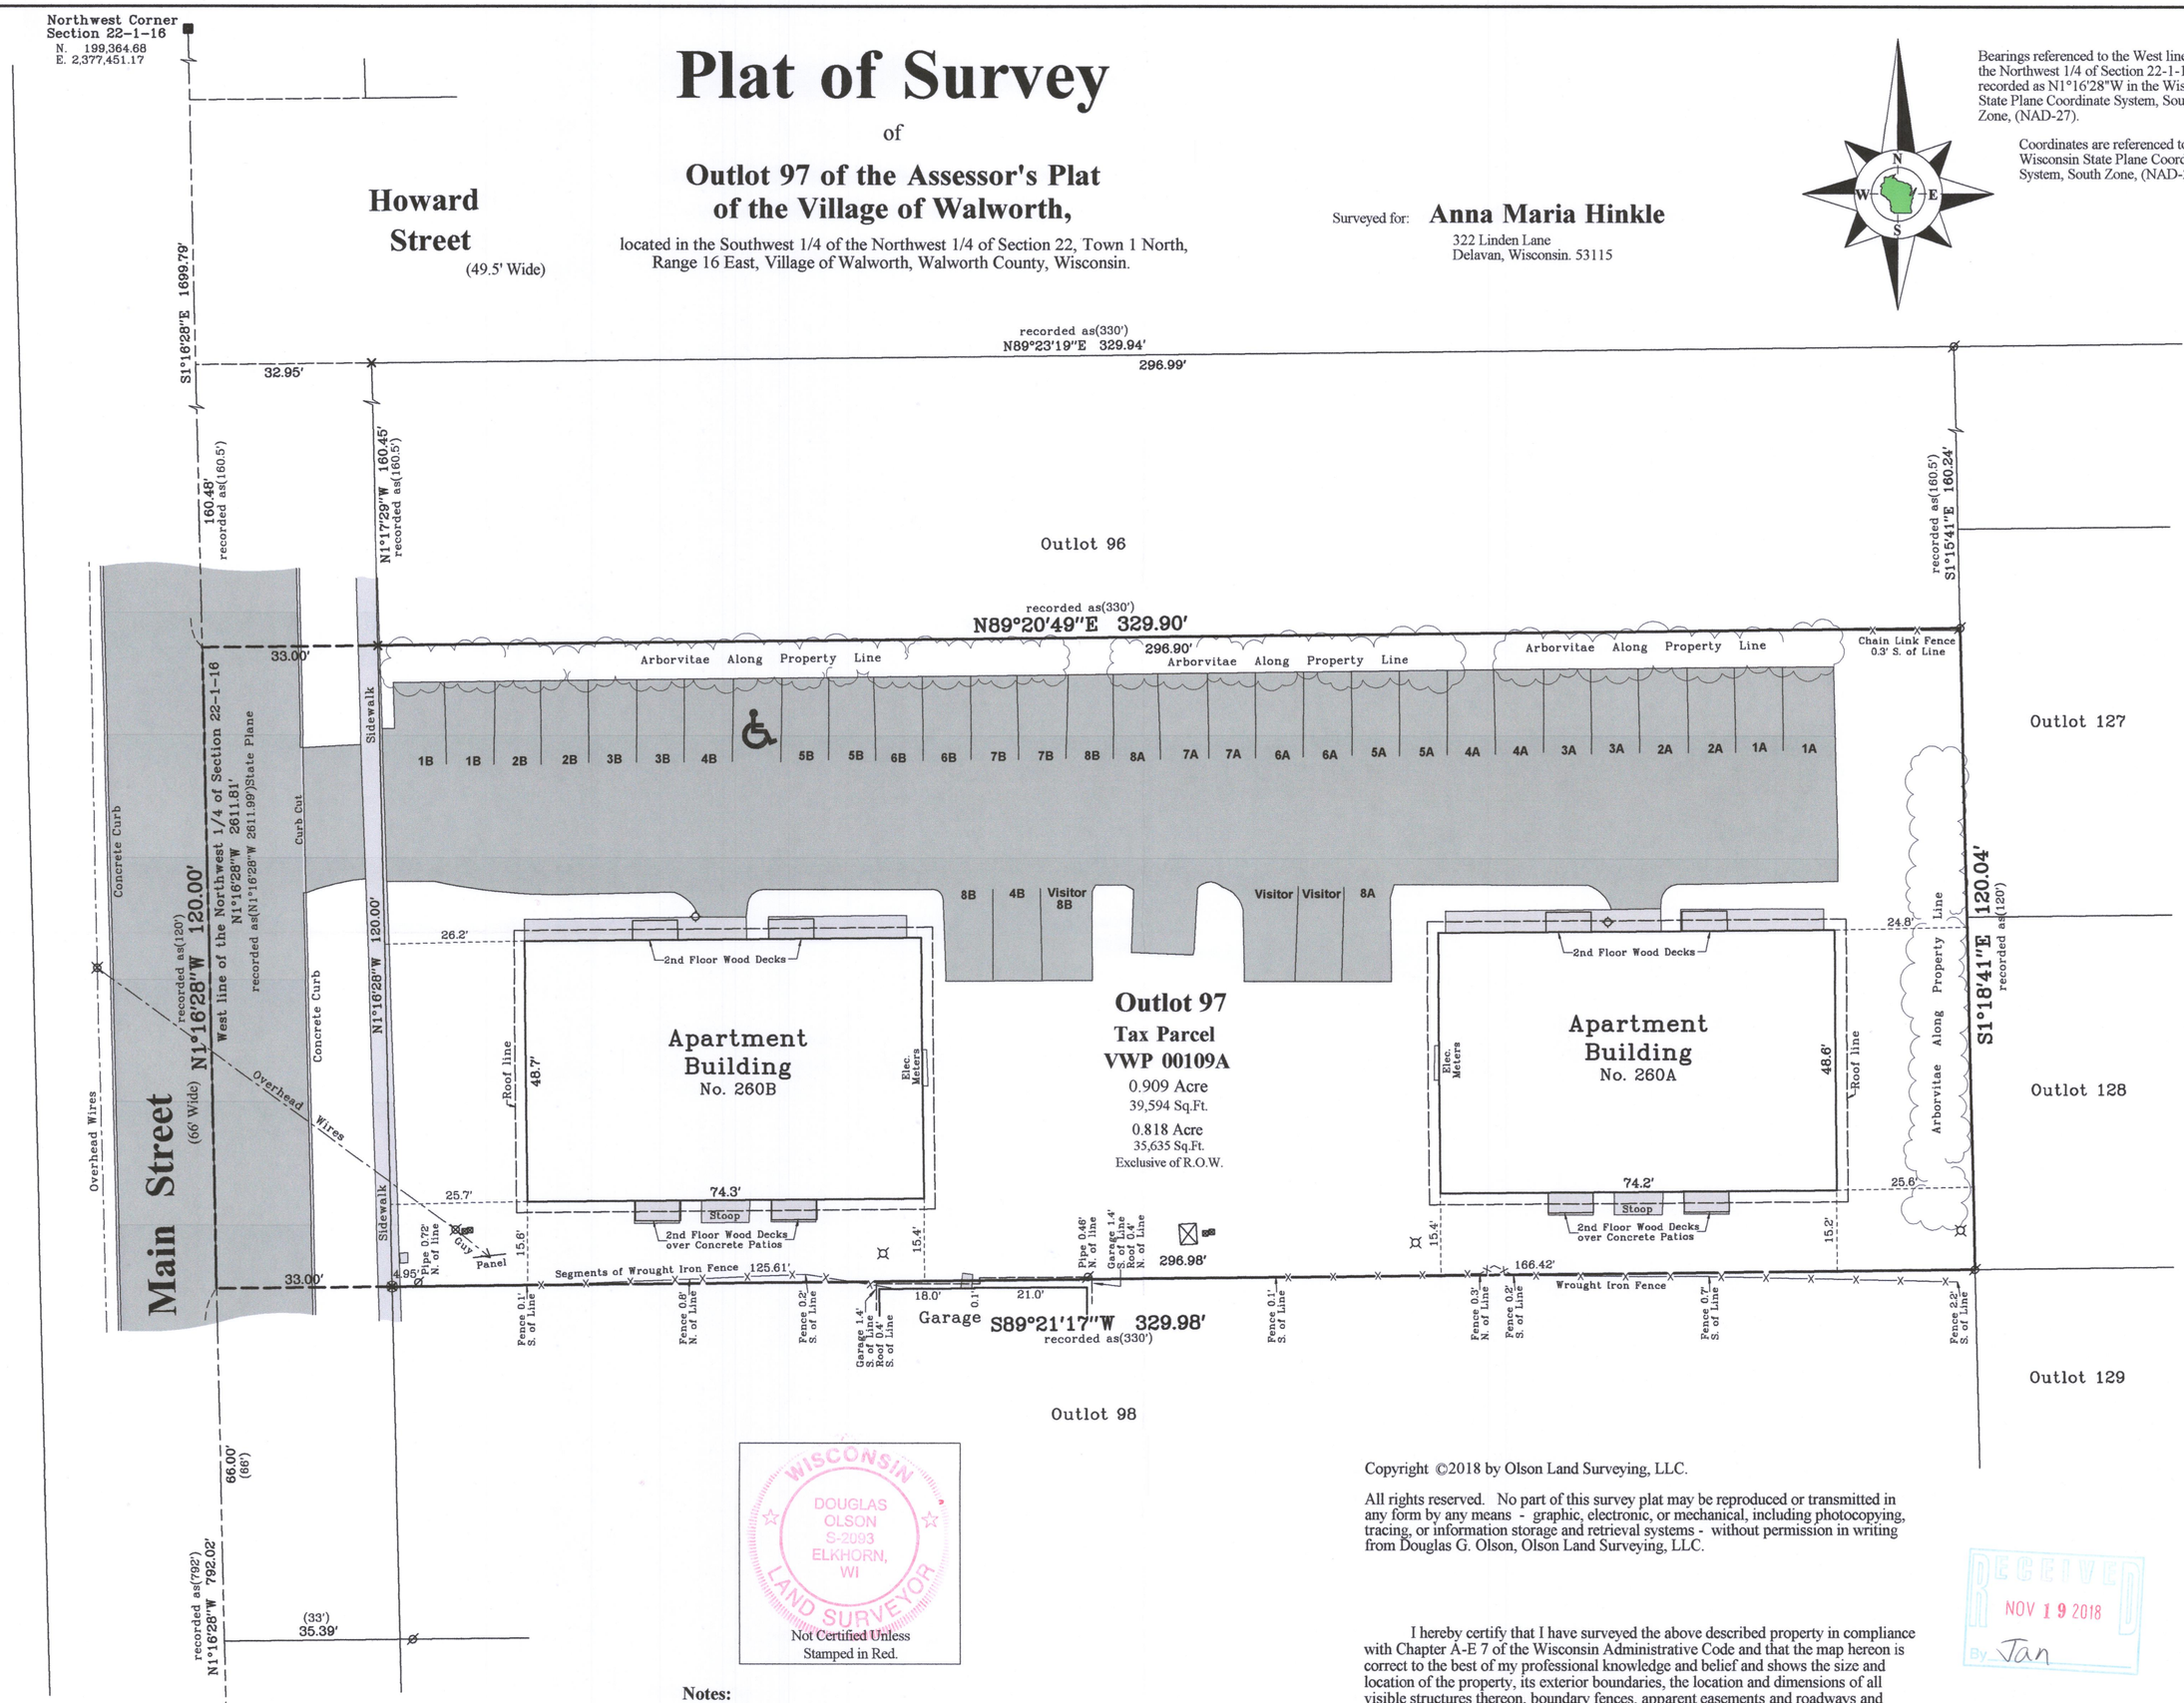

WISCONSIN DOUGLAS OLSON S-2093 ELKHORN, WI LAND SURVEYOR

Not Certified Unless Stamped in Red.

Notes:

1) This Plat of Survey is not certified unless signed and sealed in red ink.
2) This survey is subject to Wisconsin lien laws. This Plat of Survey is the notice of intent to file lien. Lien waiver required.
3) The Survey Date shown on this Plat of Survey is the completion date of the field work.

Copyright ©2018 by Olson Land Surveying, LLC.

All rights reserved. No part of this survey plat may be reproduced or transmitted in any form by any means - graphic, electronic, or mechanical, including photocopying, tracing, or information storage and retrieval systems - without permission in writing from Douglas G. Olson, Olson Land Surveying, LLC.

I hereby certify that I have surveyed the above described property in compliance with Chapter A-E 7 of the Wisconsin Administrative Code and that the map hereon is correct to the best of my professional knowledge and belief and show the size and location of the property, its exterior boundaries, the location and dimensions of all visible structures thereon, boundary fences, apparent easements and roadways and visible encroachments, if any.

This survey is made for the exclusive use of the present owners of the property, and also those who purchase, mortgage or guarantee title thereto, within one year from the date hereof.

Douglas G. Olson
Wisconsin Professional Land Surveyor - 2093

RECEIVED NOV 19 2018 By Jan

VWP-109A 009-1308

Survey Date: August 08, 2018.
Revisions: No. 1 - Bearing reference

Scale in Feet
1" = 20'
0' 10' 20' 40' 60'

45 South Wisconsin Street | P.O. Box 322
Elkhorn, Wisconsin. 53121
Telephone: (262) 723-3434
Facsimile: (262) 723-8044
Email: doug@olsonsurveying.com
Website: www.olsonsurveying.com

OLSON LAND SURVEYING, LLC
Rural | Residential | Commercial

Legend of Symbols & Abbreviations
Found County Section Corner
Found Iron Pipe
Found Cut Cross
Set Cut Cross
Recorded Information
Utility Pole
Utility Box or Pedestal
Light Pole
Sign
Asphalt Surface
Concrete Surface
N North
S South
E East
W West
Bearings
Degrees
' Minutes
" Seconds
In Distances
' Feet
" Inches

Sheet 1 of 1 Sheets

Drawing Name:

Job Reference Number
2018.099

2018.099