
PLAT OF SURVEY

OF Blk 1

The East 25 feet of Lots 18 & 19 of E. W. Crumbs Addition and the North 82.50 feet of Outlot 192 Assessor's Plat of the Village of Walworth, Walworth County, Wisconsin.

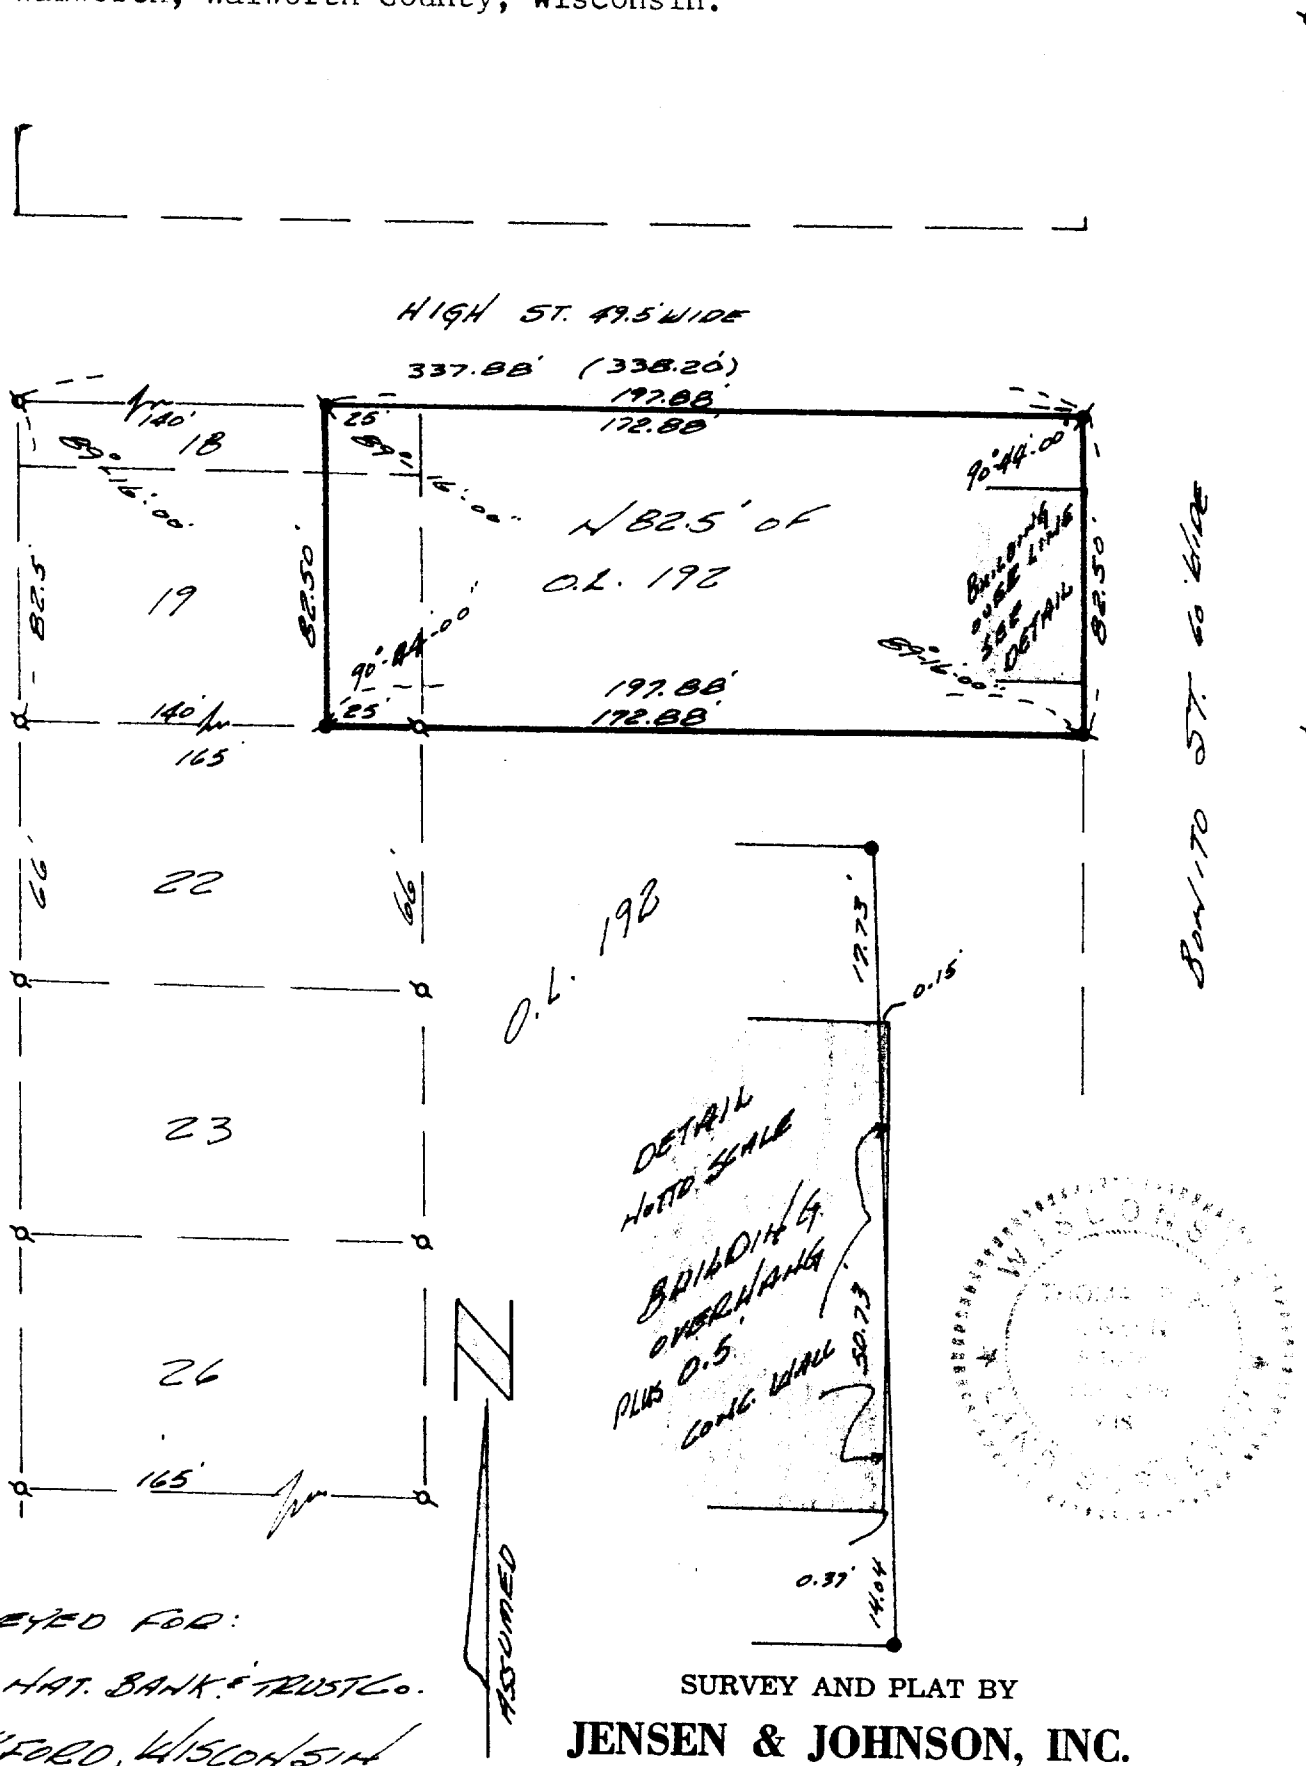

SURVEYED FOR:

AMER. NAT. BANK & TRUST Co.

ROCKFORD, WISCONSIN

LEGEND

- ∅ — Iron Pipe FOUND
- ● — Concrete Monument
- Scale 1" = 50'
- ■ — 3/4" O.D. IRON ROD SET

SURVEY AND PLAT BY

JENSEN & JOHNSON, INC.

CIVIL ENGINEERS AND SURVEYORS

Elkhorn, Wisconsin

WE CERTIFY: That we have surveyed the above described property and that the plat shown hereon is an accurate survey and a true representation thereof and correctly shows the exterior boundary lines and all divisions of said property.

Date 1/AN 29, 1976 Thomas P.A. Jensen [redacted]

Wisconsin Registered Land Surveyor, No. S-[redacted]

VECR-15 + Pt VWP-231

POST 175H

9-136J