
#244-65.

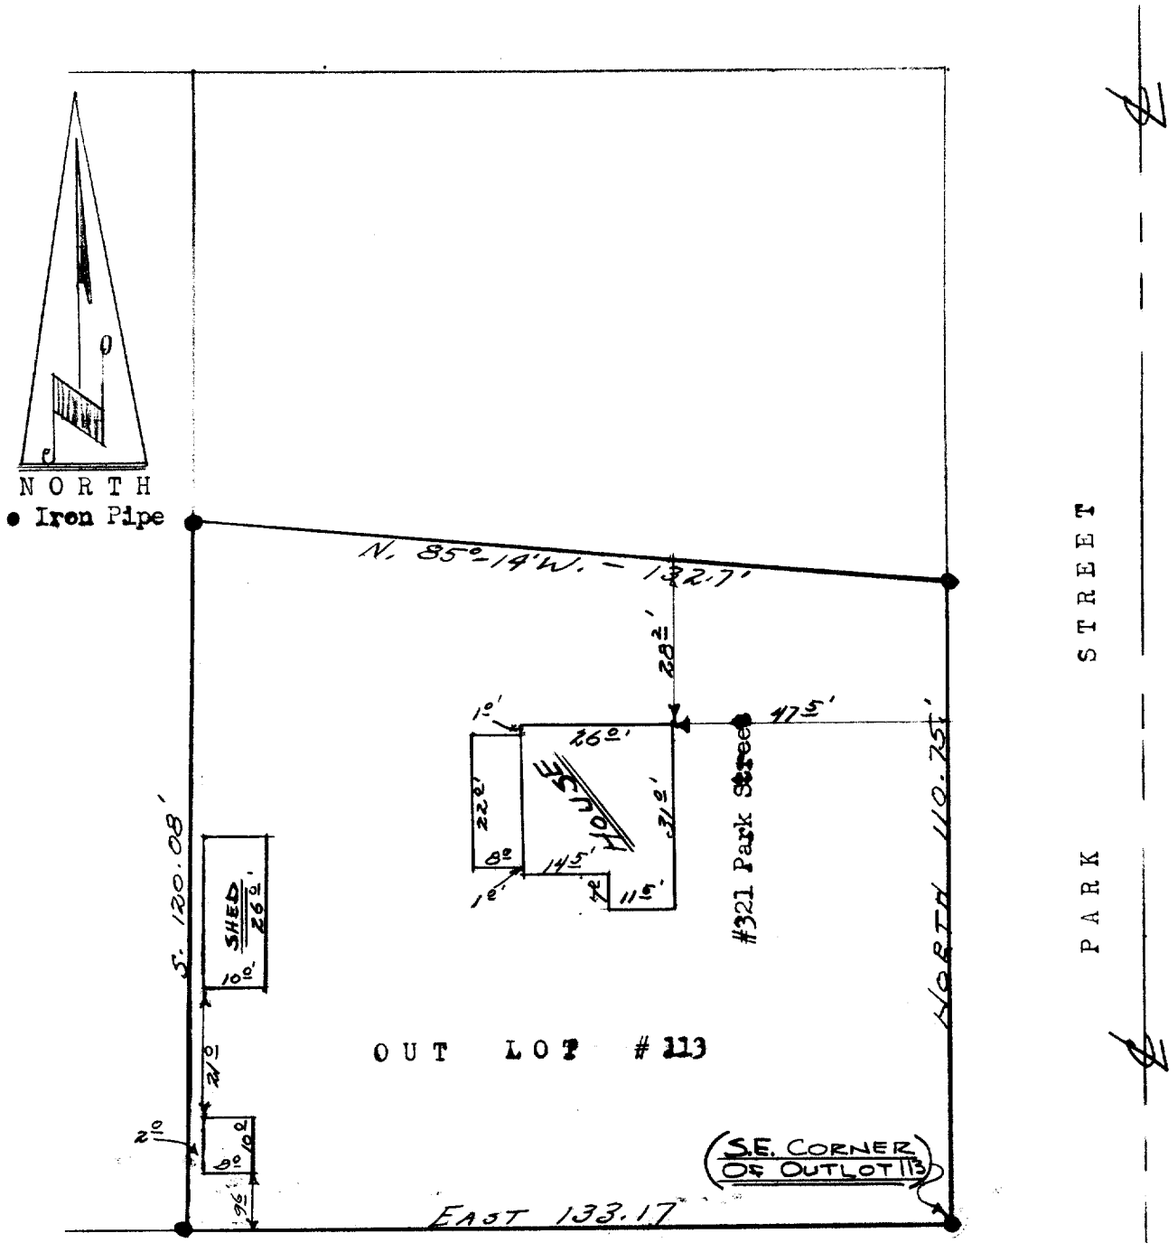

DESCRIPTION: Part of Outlots 112 and 113; Commencing at the SE Corner of Outlot 113, thence North 110.75 feet, thence N. 85° 14' W. 132.70 feet, thence South 120.08 feet, thence East 133.17 feet, to the place of beginning all in the Village of Walworth, Walworth County, Wisconsin.

CERTIFICATE: I, hereby certify that I have surveyed the above mentioned property and that the hereon portrayed is an accurate survey and a true representation thereof and correctly shows the exterior boundary lines and the location of buildings and other improvements thereof.

James F. Biagi. P.E. and L.S.
Elkhorn, Wisconsin.

Dated: October 27th 1965.

JAMES F. BIAGI MILWAUKEE, WIS. REGISTERED LAND SURVEYOR WISCONSIN

VWP-138

9-1B