
DUNHAM SURVEYING, S.C.

SURVEYING & SUBDIVIDING

DELAVAN, WISCONSIN 53115

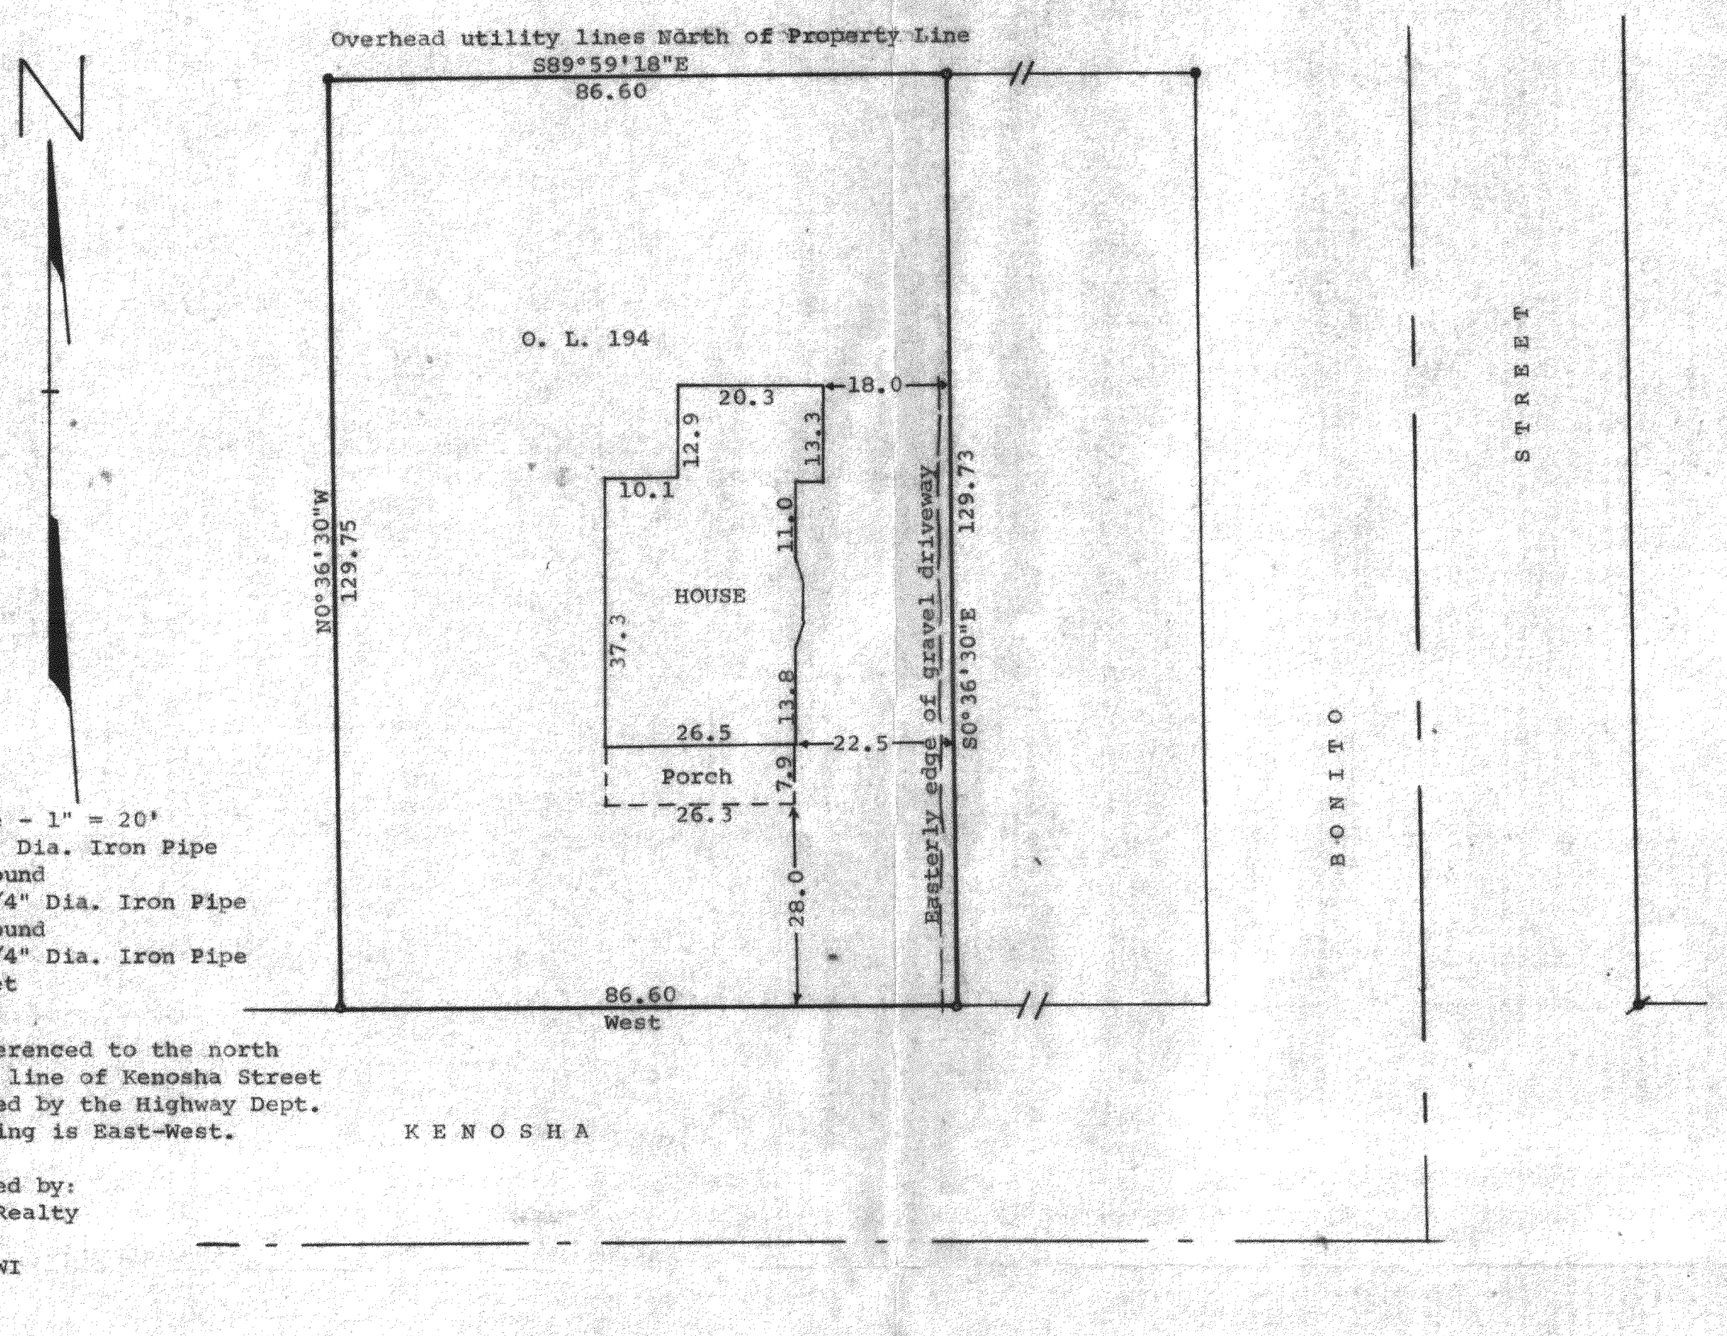

Scale - 1" = 20'

● = 1" Dia. Iron Pipe Found

⌀ = 3/4" Dia. Iron Pipe Found

○ = 3/4" Dia. Iron Pipe Set

Bearings referenced to the north right of way line of Kenosha Street as established by the Highway Dept. Assumed bearing is East-West.

Survey ordered by:
Churchill Realty
322 Park
Walworth, WI

STATE OF WISCONSIN)
COUNTY OF WALWORTH) SS

I, George T. Dunham, Surveyor, certify that I have surveyed the property described as follows,

Outlot 194 of the Assessor's Plat of the Village of Walworth, Walworth County, Wisconsin,

and that the above map is a true representation thereof and shows the size and location of the property, its exterior boundaries, the location of all visible structures and dimensions of all principal buildings thereon, boundary fences, apparent easements, roadways and visible encroachments, if any.

This survey is made for the use of the present owners of the property, and also those who purchase, mortgage, or guarantee the title thereto within one (1) year from date hereof.

February 3, 1983

George T. Dunham

George T. Dunham, Surveyor

WISCONSIN
GEORGE T. DUNHAM
DELAVAN, WIS.
LAND SURVEYOR

K & E 10-2155

VWP-233

9-202-D