


GEORGE T. DUNHAM
SURVEYING & SUBDIVIDING
DELAVER, WISCONSIN

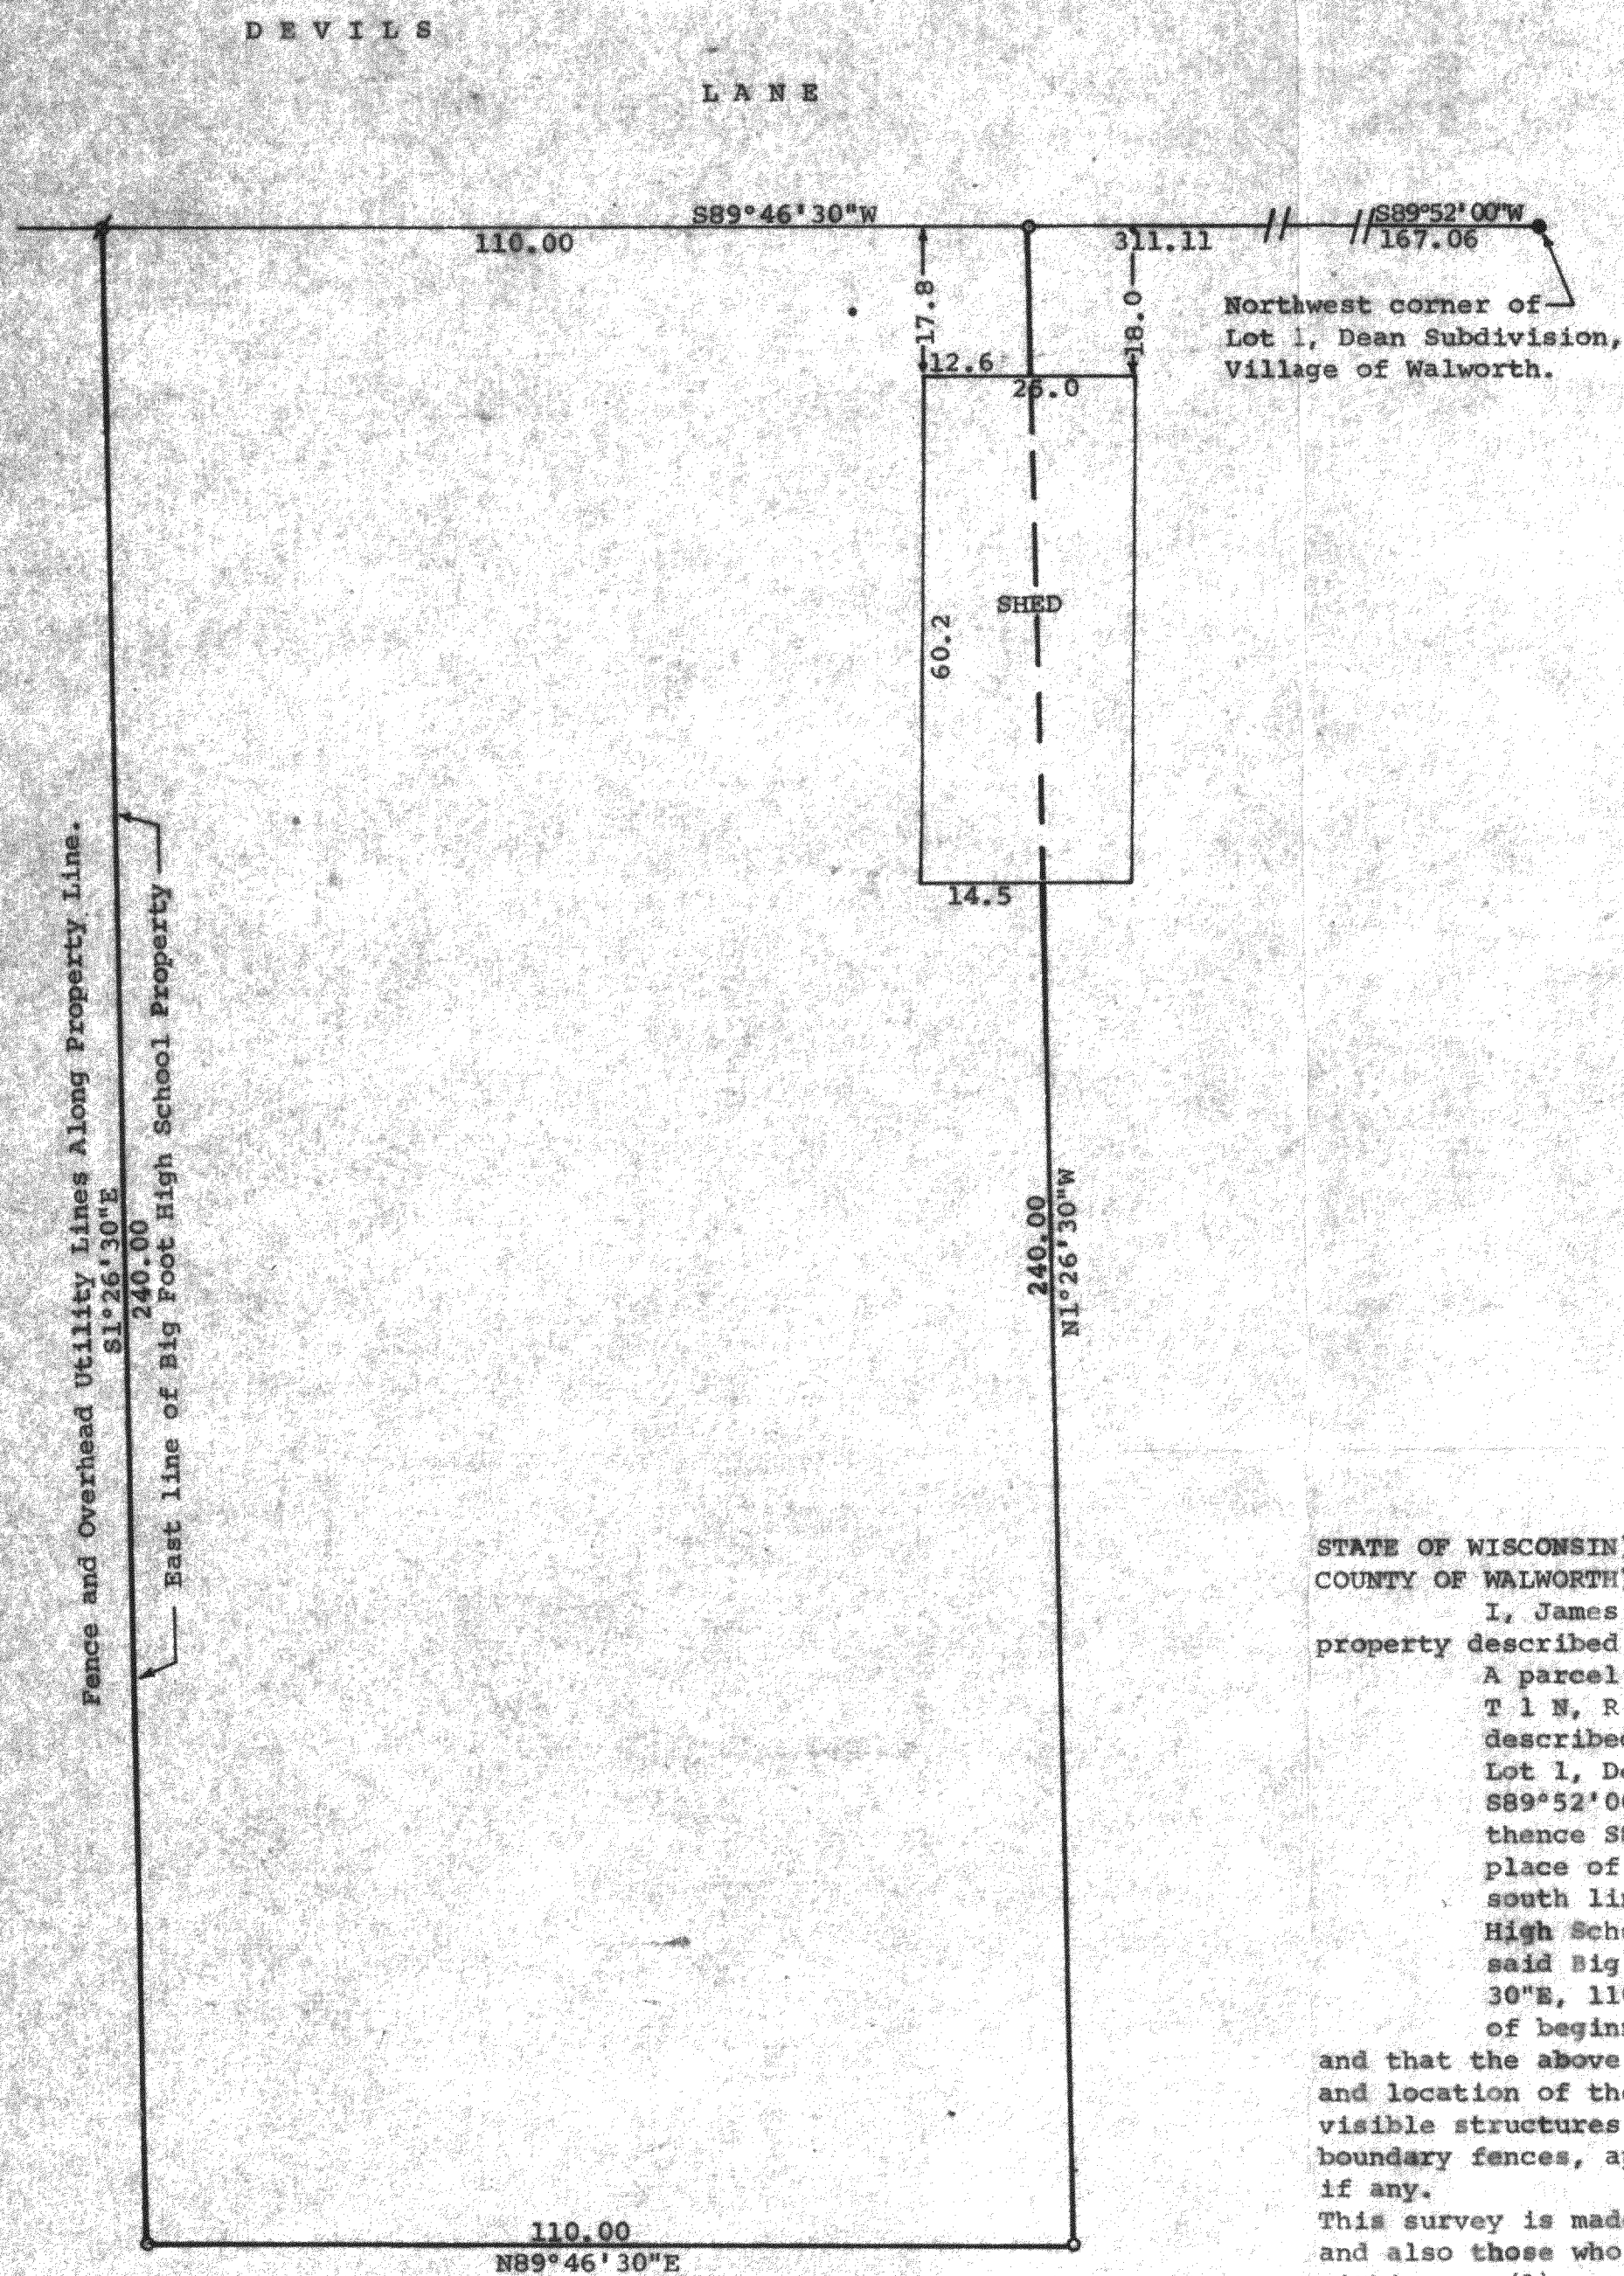

Scale - 1" = 20'
 - - - = Iron Pipe Found
 ——— = Iron Pipe Set
 • = 2" Iron Pipe Found

STATE OF WISCONSIN)
 COUNTY OF WALWORTH) SS

I, James M. Dunham, Surveyor, certify that I have surveyed the property described as follows:

A parcel of land located in the Southwest ¼ of Section 22, T 1 N, R 16 E, Village of Walworth, Walworth County, Wisconsin, described as follows: Commencing at the northwest corner of Lot 1, Dean Subdivision in said Village of Walworth; thence S89°52'00"W along the south line of Devils Lane, 167.06 feet; thence S89°46'30"W along said south line, 311.11 feet to the place of beginning; thence continue S89°46'30"W along said south line 110.00 feet to the northeast corner of the Big Foot High School property; thence S1°26'30"E along the east line of said Big Foot High School property, 240.00 feet; thence N89°46'30"E, 110.00 feet; thence N1°26'30"W 240.00 feet to the place of beginning containing 0.61 acres of land.

and that the above map is a true representation thereof and shows the size and location of the property, its exterior boundaries, the location of all visible structures and dimensions of all principal buildings thereon, boundary fences, apparent easements, roadways and visible encroachments, if any.

This survey is made for the use of the present owners of the property, and also those who purchase, mortgage, or guarantee the title thereto within one (1) year from date hereof.

August 12, 1980

James M. Dunham
 James M. Dunham, Surveyor

