


DUNHAM SURVEYING, S.C.

SURVEYING & SUBDIVIDING
DELAVER, WISCONSIN 53115

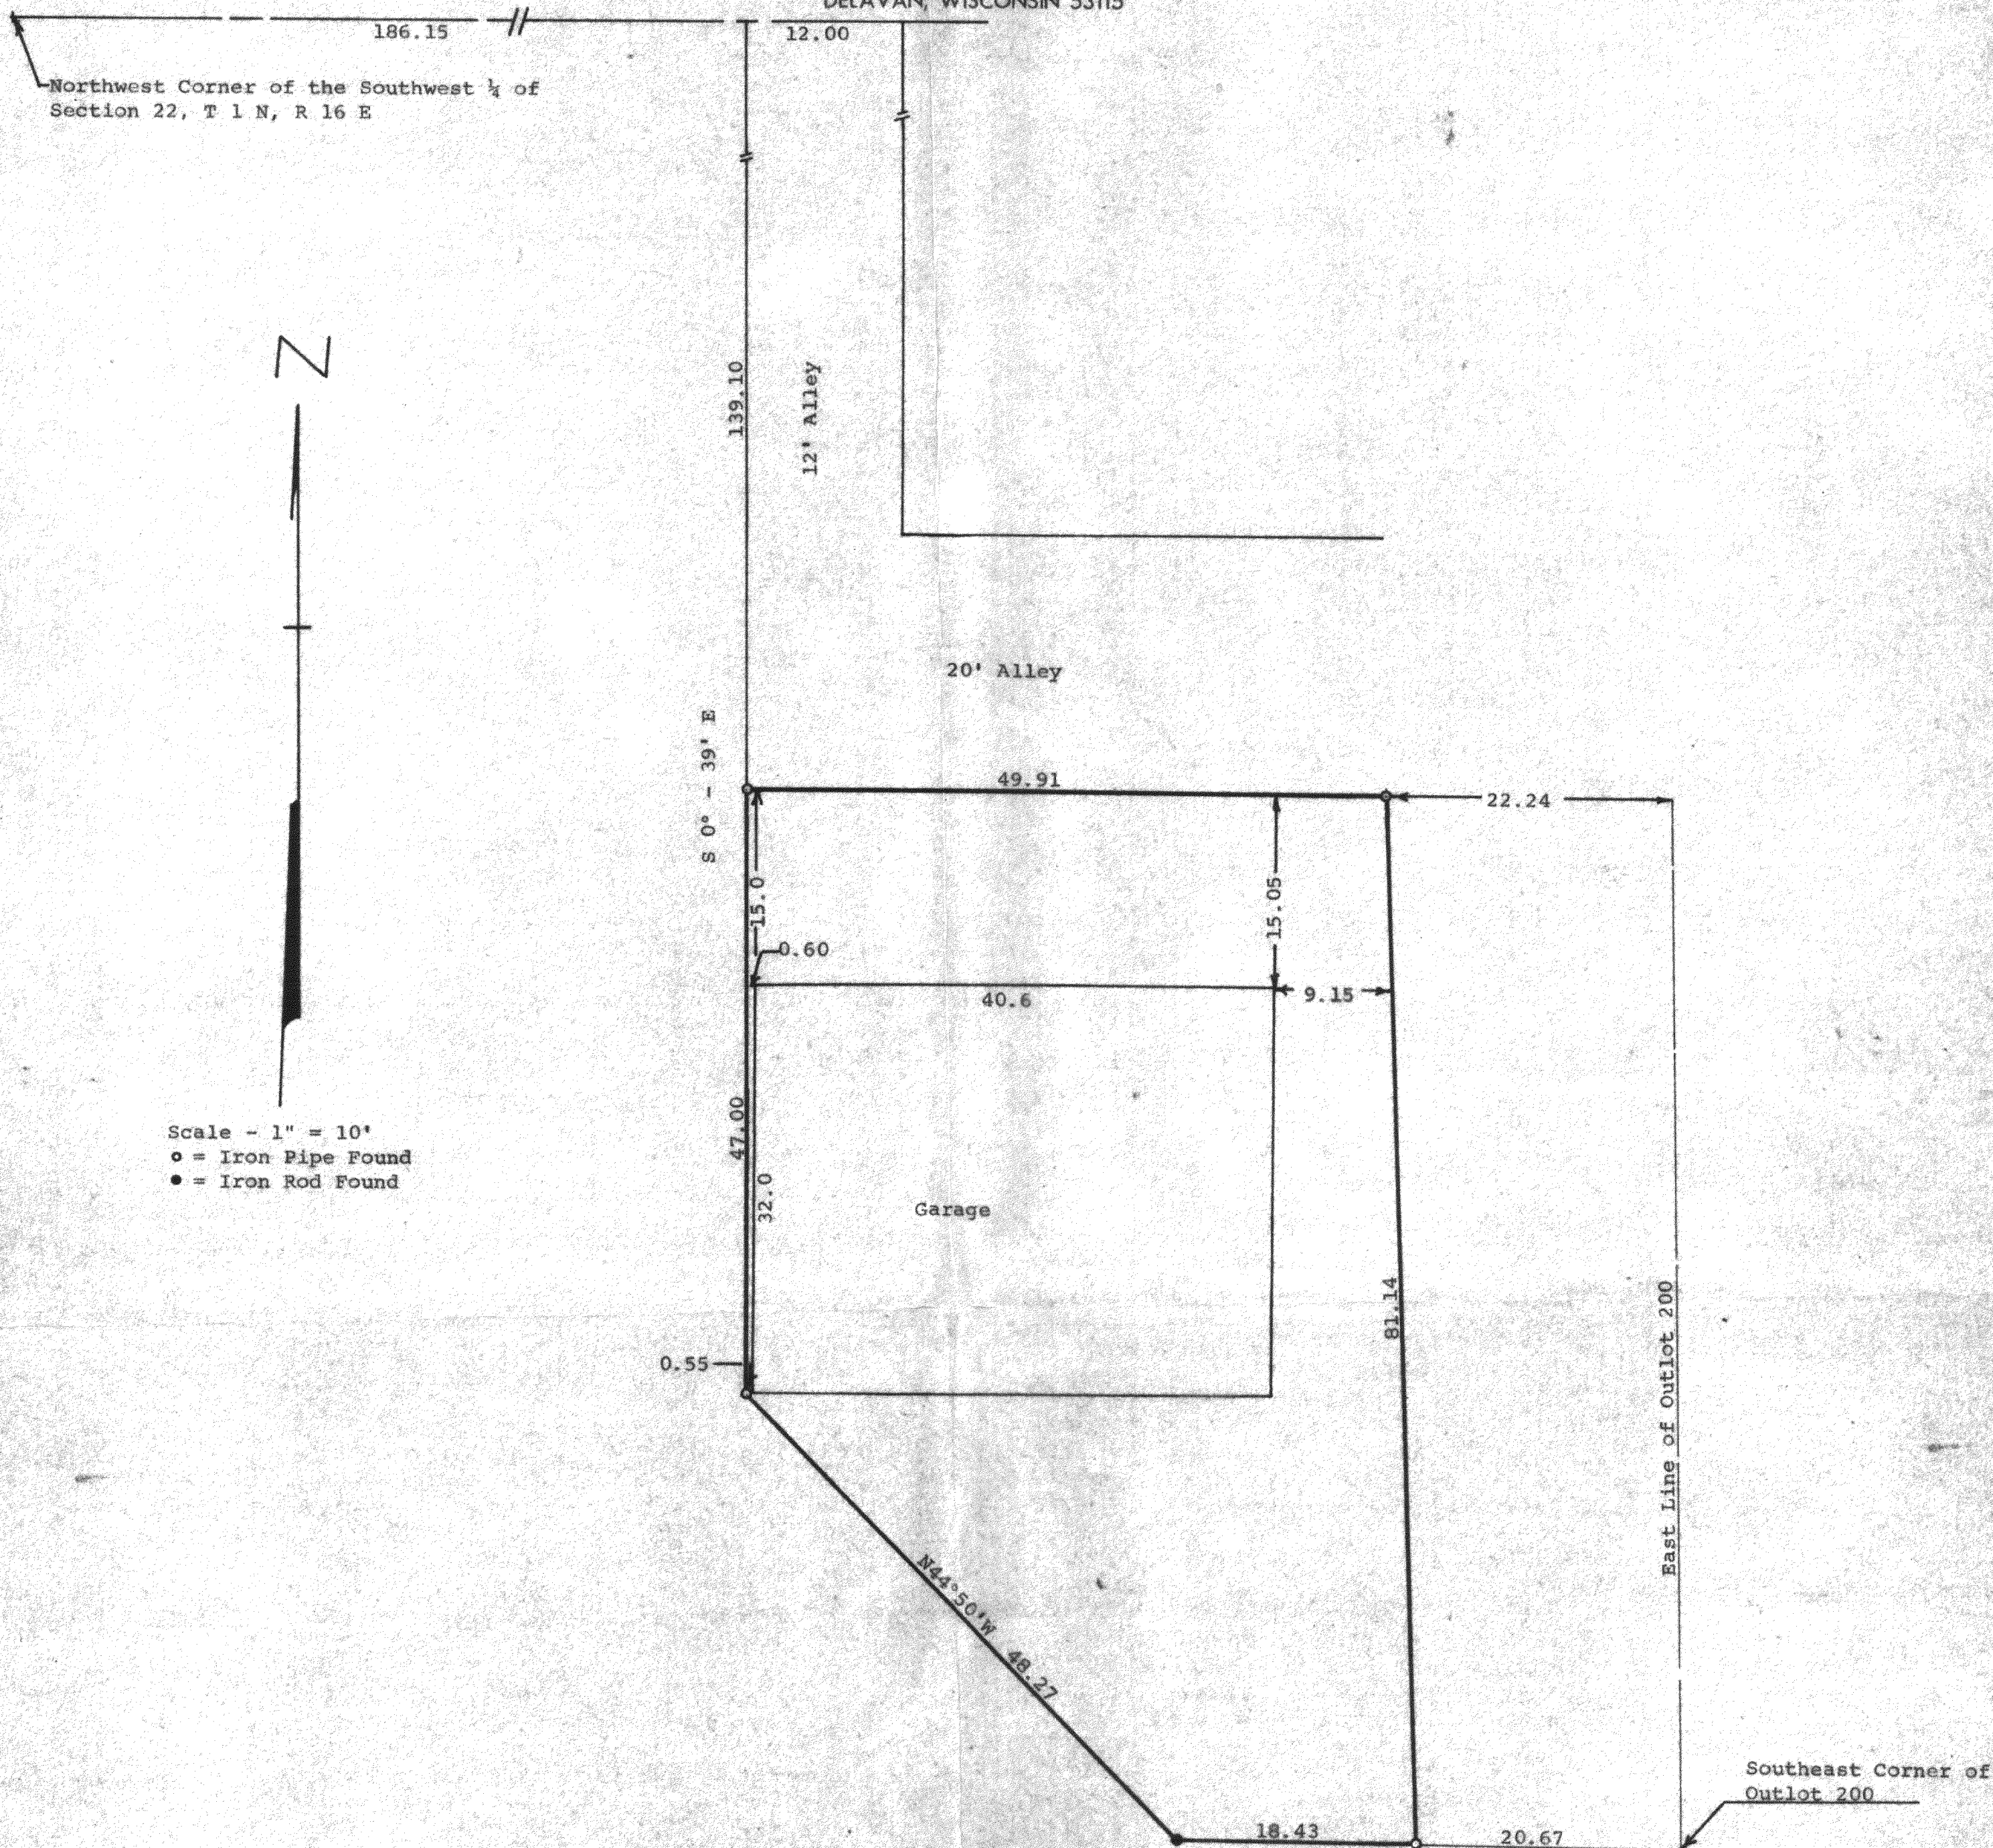

STATE OF WISCONSIN) SS
COUNTY OF WALWORTH)

I, George T. Dunham, Surveyor, certify that I have surveyed the property described as follows:

A parcel of land located in the Southwest 1/4 of Section 22, Town 1 North, Range 16 East, Walworth County, Wisconsin and being a part of Outlot No. 200 of the Assessor's Plat of the Village of Walworth, and described as follows: Commencing at the northwest corner of said Southwest 1/4; thence East along the north line of said southwest 1/4 186.15 feet; thence South 0° 39' East 139.10 feet to the place of beginning; thence east parallel to the north line of said southwest 1/4 49.91 feet to a point that is located 22.24 feet west of the east line of said Outlot 200; thence southerly 81.14 feet to a point on the south line of said Outlot 200, which point is located 20.67 feet west of the southeast corner of said Outlot 200; thence west along the south line of said Outlot 18.43 feet to the corner of said Outlot; thence North 44° 50' West along the southwesterly line of said Outlot 48.27 feet to an iron pipe; thence North 0° 39' West 47.00 feet to the place of beginning.

and that the above map is a true representation thereof and shows the size and location of the property, its exterior boundaries, the location of all visible structures and dimensions of all principal buildings thereon, boundary fences, apparent easements, roadways and visible encroachments, if any.

This survey is made for the use of the present owners of the property, and also those who purchase, mortgage, or guarantee the title thereto within one (1) year from date hereof.

March 12, 1980

George T. Dunham
George T. Dunham, Surveyor

