
DUNHAM SURVEYING, S.C.

SURVEYING & SUBDIVIDING
DELAVAN, WISCONSIN 53115

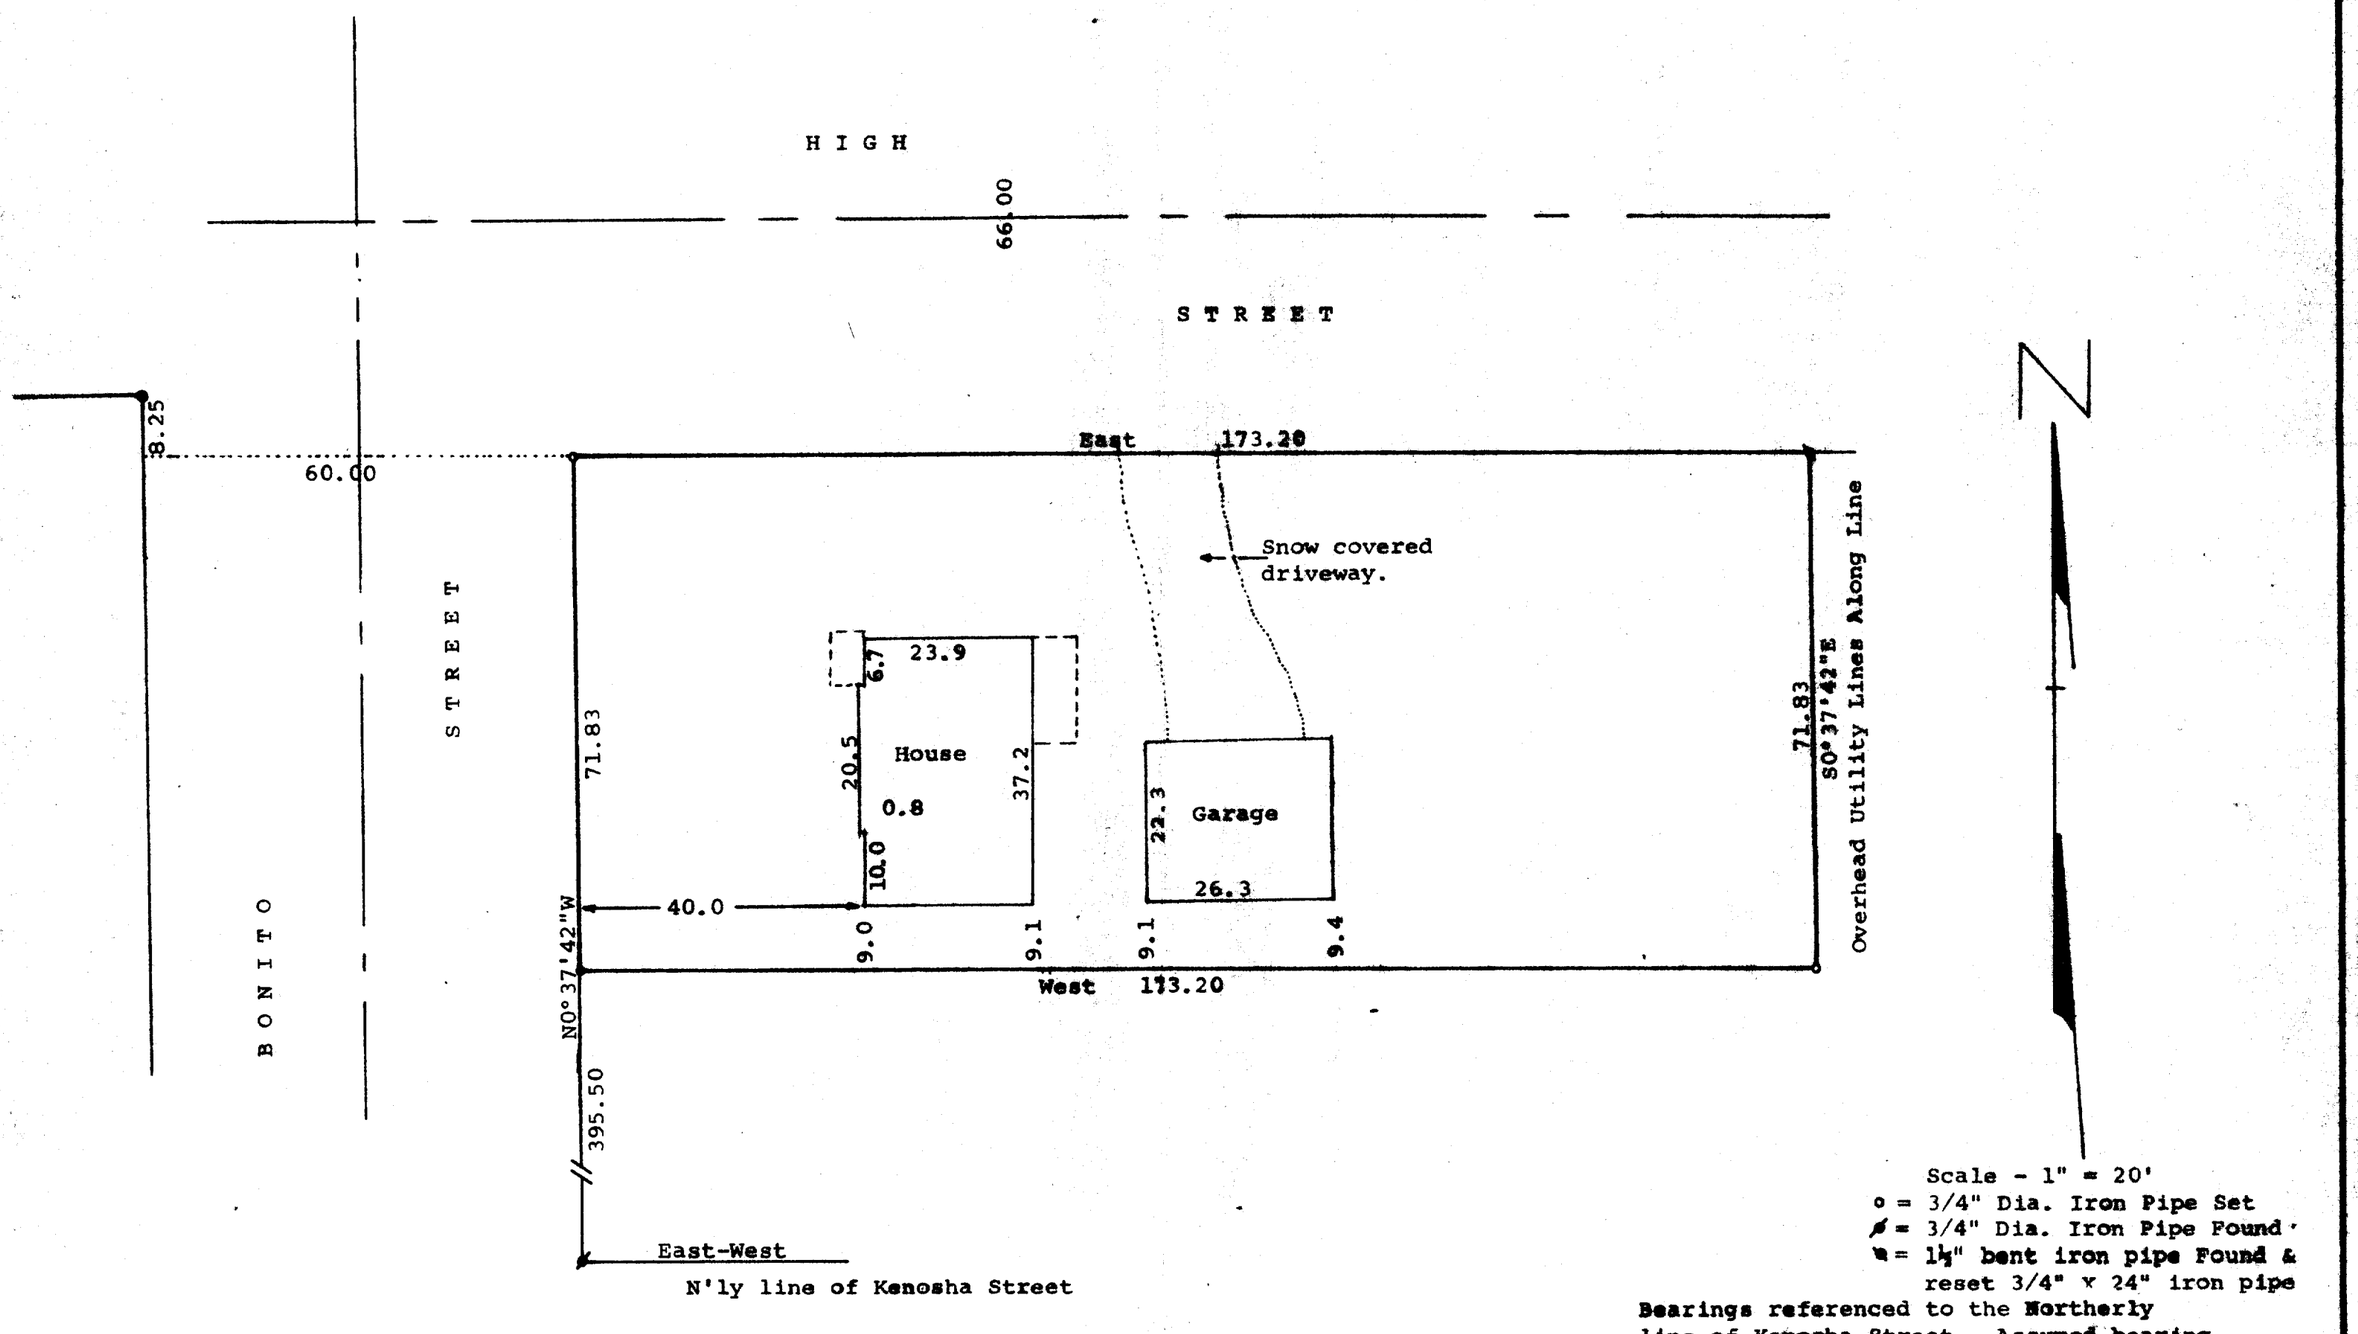

Survey ordered by:
Anchor Savings & Loan
500 E. Walworth Ave.
Delavan, Wisconsin 53115

STATE OF WISCONSIN)
COUNTY OF WALWORTH) SS

I, George T. Dunham, Surveyor, certify that I have surveyed the property described as follows,

A parcel of land located in a part of Outlot 196 of the Assessor's Plat of the Village of Walworth, Walworth County, Wisconsin, described as follows: Beginning at a point in the East line of Bonito Street, which point is 395.50 feet North of the north line of Kenosha Street; thence East and parallel with said Kenosha Street 173.20 feet; thence N0°37'42"W 71.83 feet to the South line of High Street; thence West along the south line of said High Street, 173.20 feet to the East line of Bonito Street; thence S0°37'42"E along said east line of Bonito Street, 71.83 feet to the place of beginning.

and that the plat shown above is a true representation thereof and shows the size and location of the property, its exterior boundaries, the location of boundary fences, apparent easements, roadways and visible encroachments, if any, and that I have surveyed the property hereon described according to the official records to the best of my knowledge and belief.

January 17, 1984

George T. Dunham, Surveyor

WISCONSIN
GEORGE T. DUNHAM
DELAVAN, WIS.
S-306
LAND SURVEYOR

VWP-000240

9-228-D